



As Built Ground Floor Plan

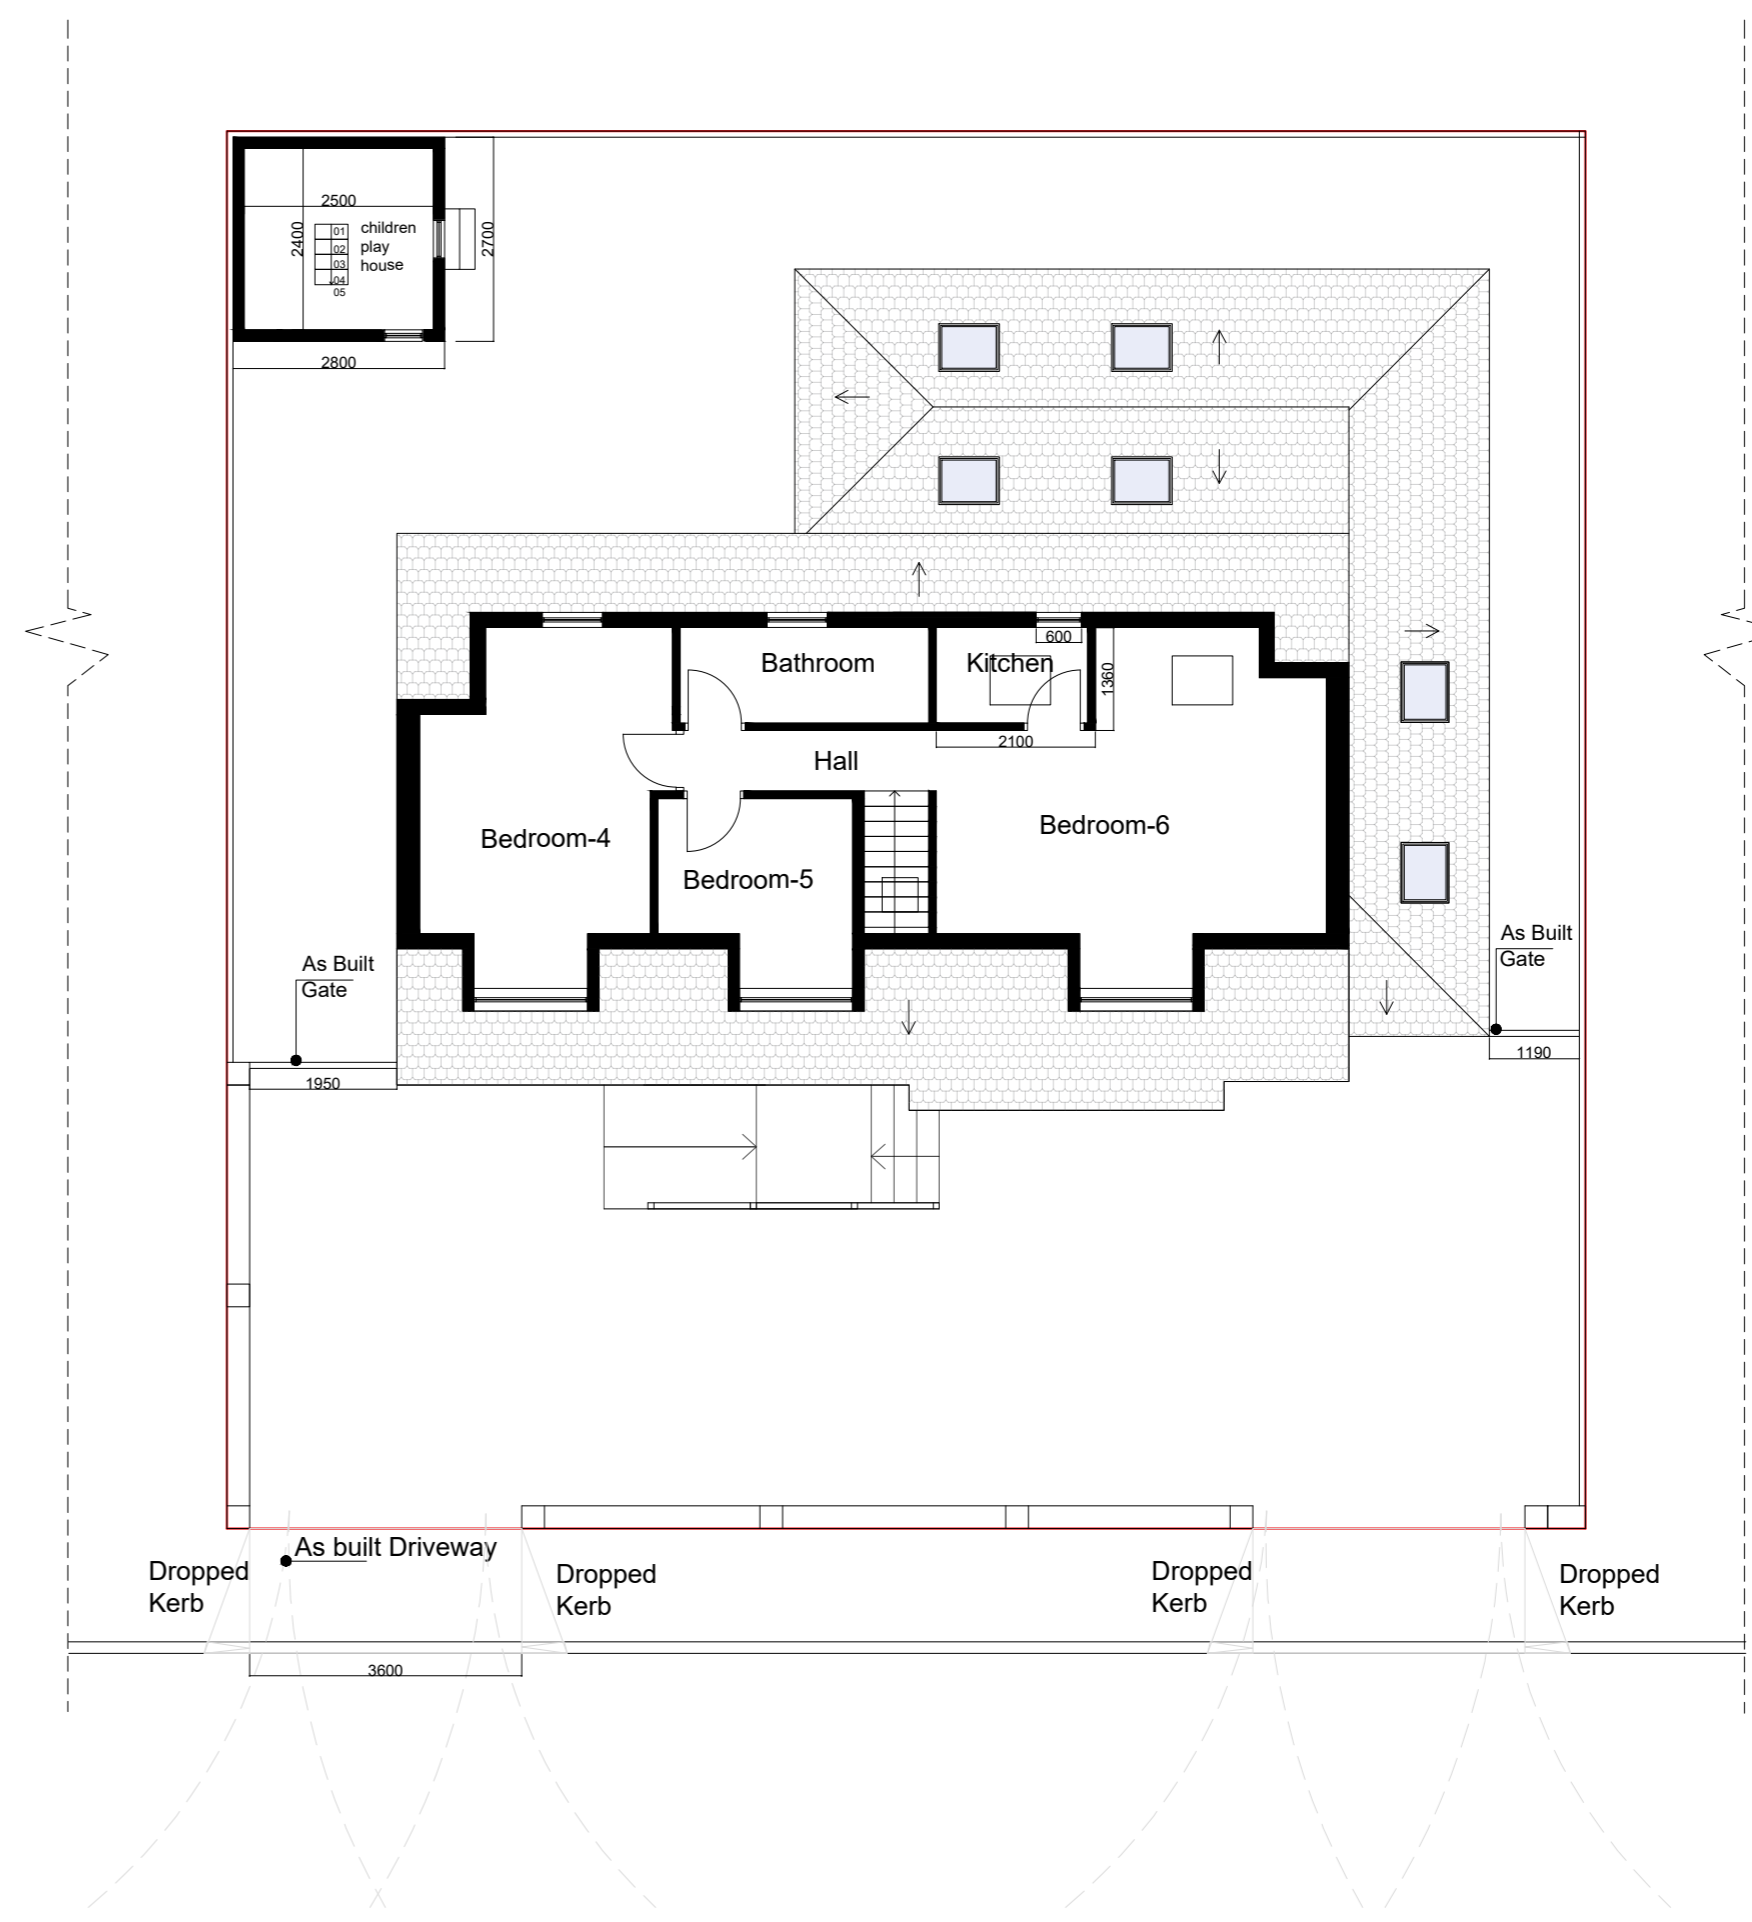

As Built First Floor Plan

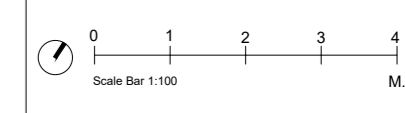

Drawing Name	
As Built Plans	
Project Address	
2 Greystones Close Aberford Leeds LS25 3AR	
Scale	Date
1/100 at A2	26.04.2023
Designer	
DG	V4
Drawing No.	
2GreystonesClose_ As BuiltPlans_ V4	

