



Any dimensions shown should be checked on site and discrepancies reported to the Architect prior to construction. Designs are not coordinated with engineer projects. Do not scale for construction purposes.


Block Plans are scaled from the Ordnance Survey Location Maps. Please see the licence number for the Os Maps in the Location Plans

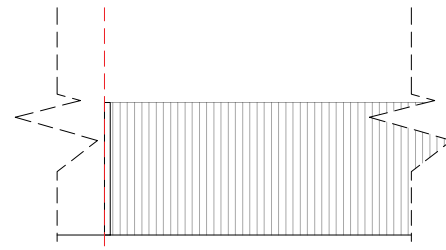

As Approved South Elevation

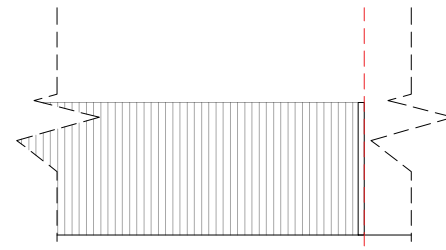


As Approved West Elevation

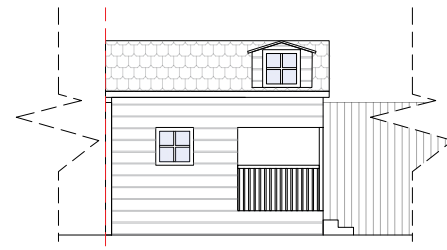


As Built South Elevation




As Built West Elevation

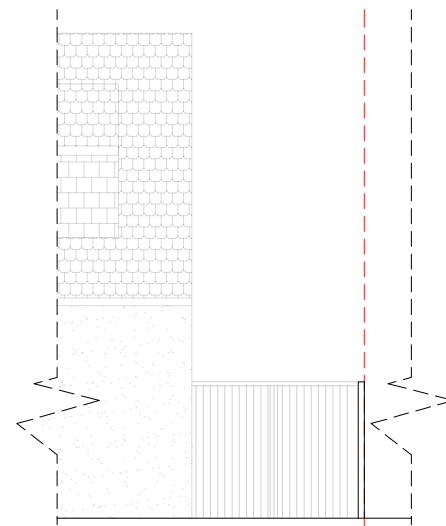


As Approved North Elevation

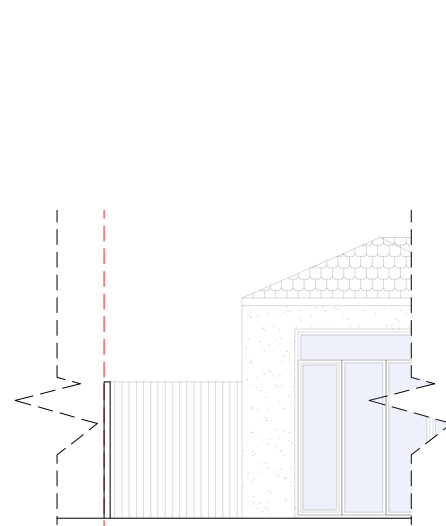


As Approved East Elevation

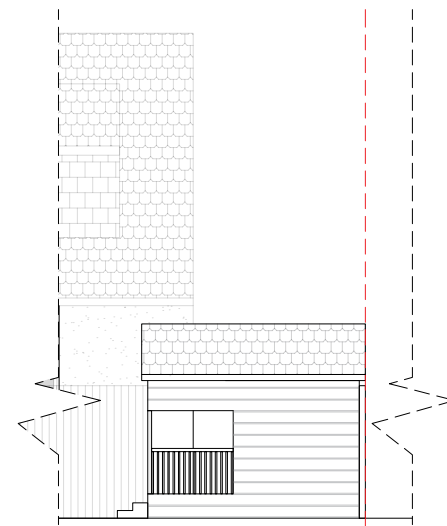

As Built North Elevation

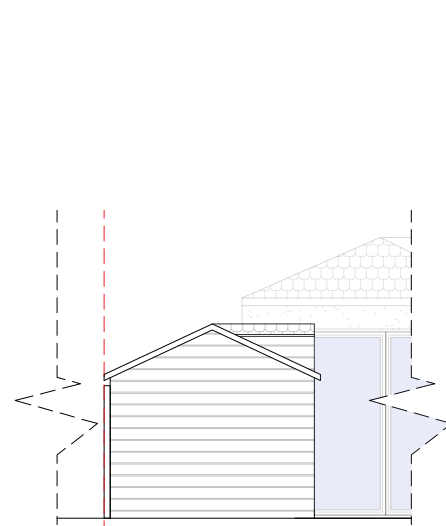

As Built East Elevation

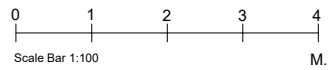

Drawing Name  
**Children Play House Elevations**

Project Address  
**2 Greystones Close  
Aberford Leeds LS25 3AR**

Scale <b>1/100 at A3</b>	Date <b>07.03.2023</b>
-----------------------------	---------------------------

Designer <b>DG</b>	Revision <b>V4</b>
-----------------------	-----------------------

Drawing No.  
**2GreystonesClose\_ChildrenPlayHouseElevations\_ V4**



Planning By Design Ltd  
www.planning-by-design.co.uk  
hello@planning-by-design.co.uk