


Elvington Cottage, Church Lane, YO41 4AD

317/101A

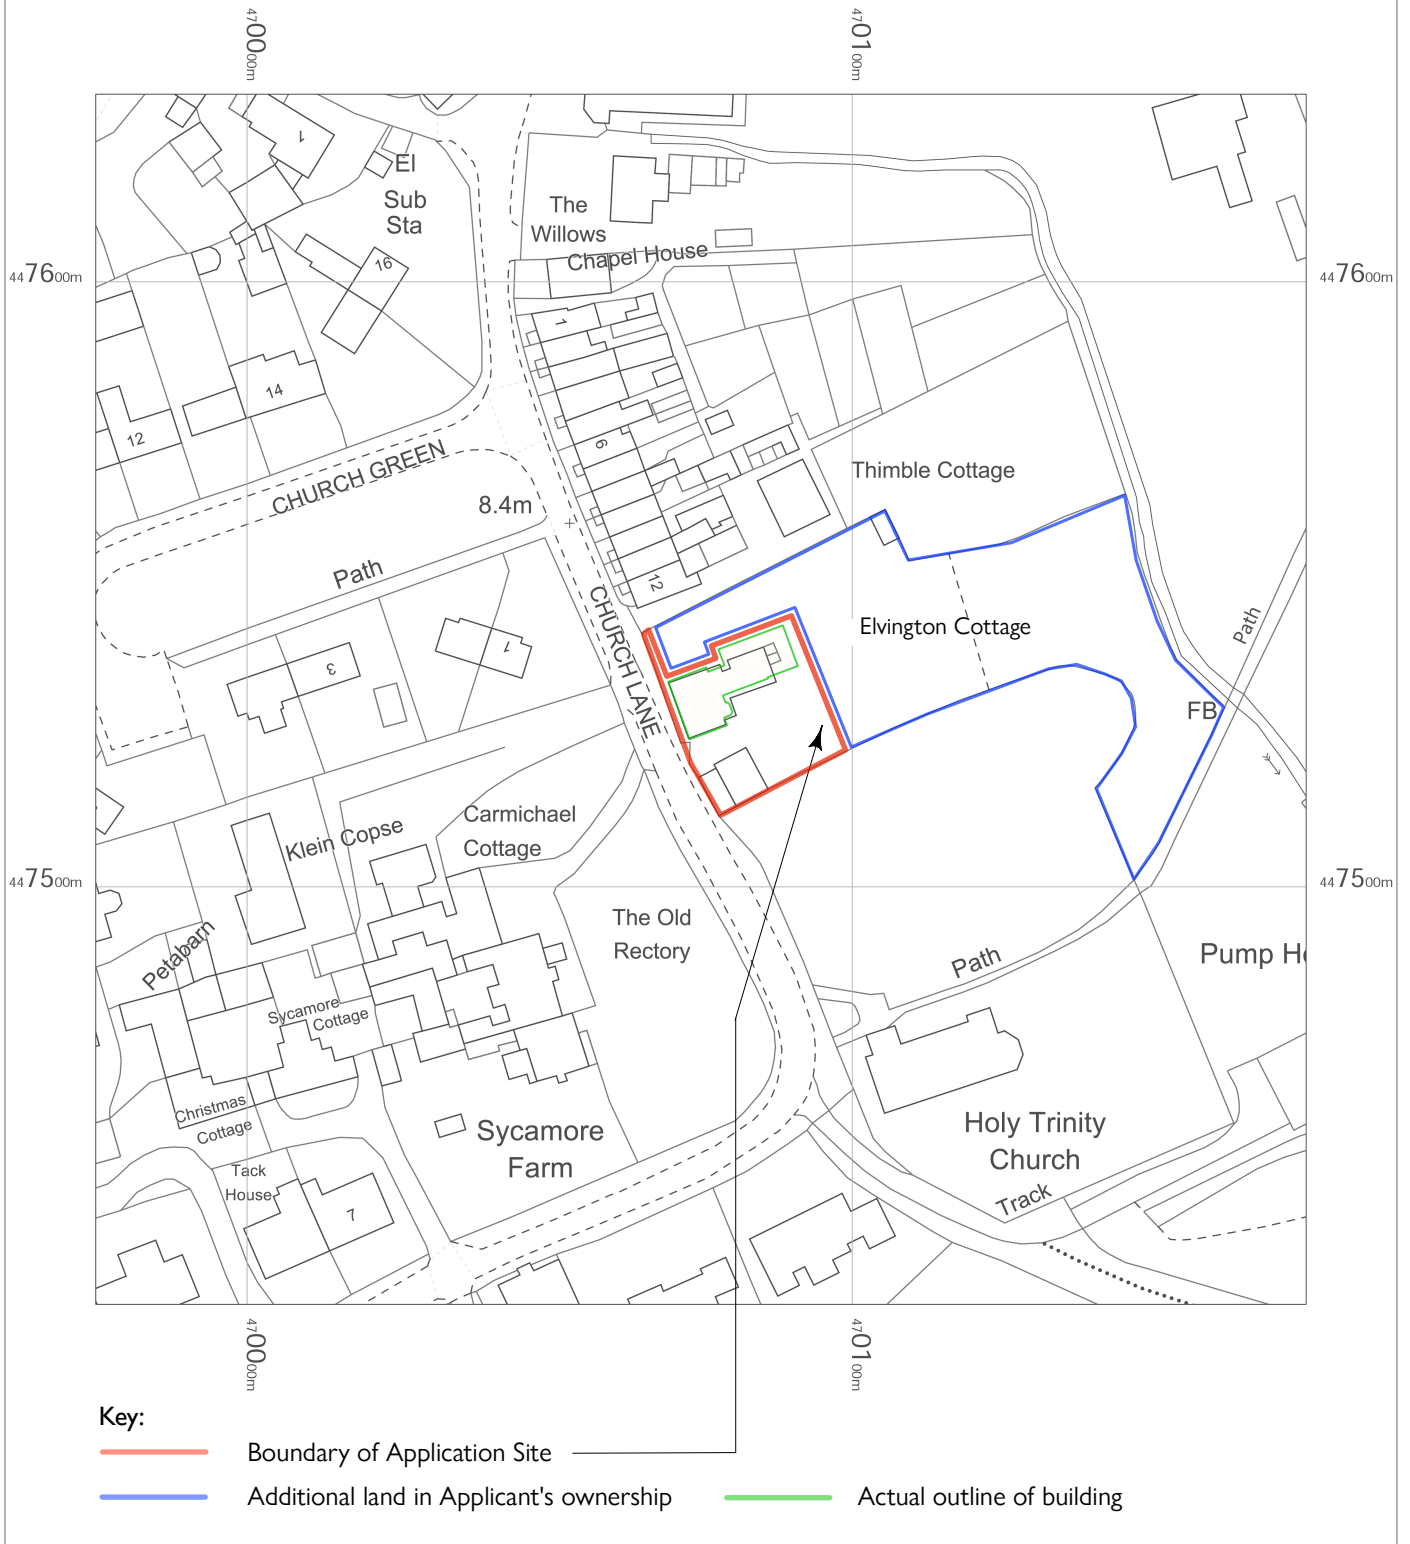

Location Plan Dwg. no. **317/101B** 1:1250 Issued for Householder Planning Application May 2023

Revision **A** - Red line of application site re-drawn

Revision **B** - Red line of application site re-drawn; true line of building (green outline) added; note added

OS MasterMap 1250/2500/10000 scale
 Sunday, April 23, 2023, ID: MPMBW-01099577
www.blackwellmapping.co.uk

1:1250 scale print at A4, Centre: 470075 E, 447531 N

©Crown Copyright Ordnance Survey. Licence no. 100041041



GEOFFREY HOLLAND
 CHARTERED ARCHITECT

BLACKWELL'S
 MAPPING SERVICES
 PERSONAL & PROFESSIONAL MAPPING
www.blackwellmapping.co.uk

TEL: 0800 151 2612
maps@blackwell.co.uk

Elvington Cottage
 Church Lane,
 Elvington,
 York,
 YO41 4AD