


Elvington Cottage, Church Lane, YO41 4AD

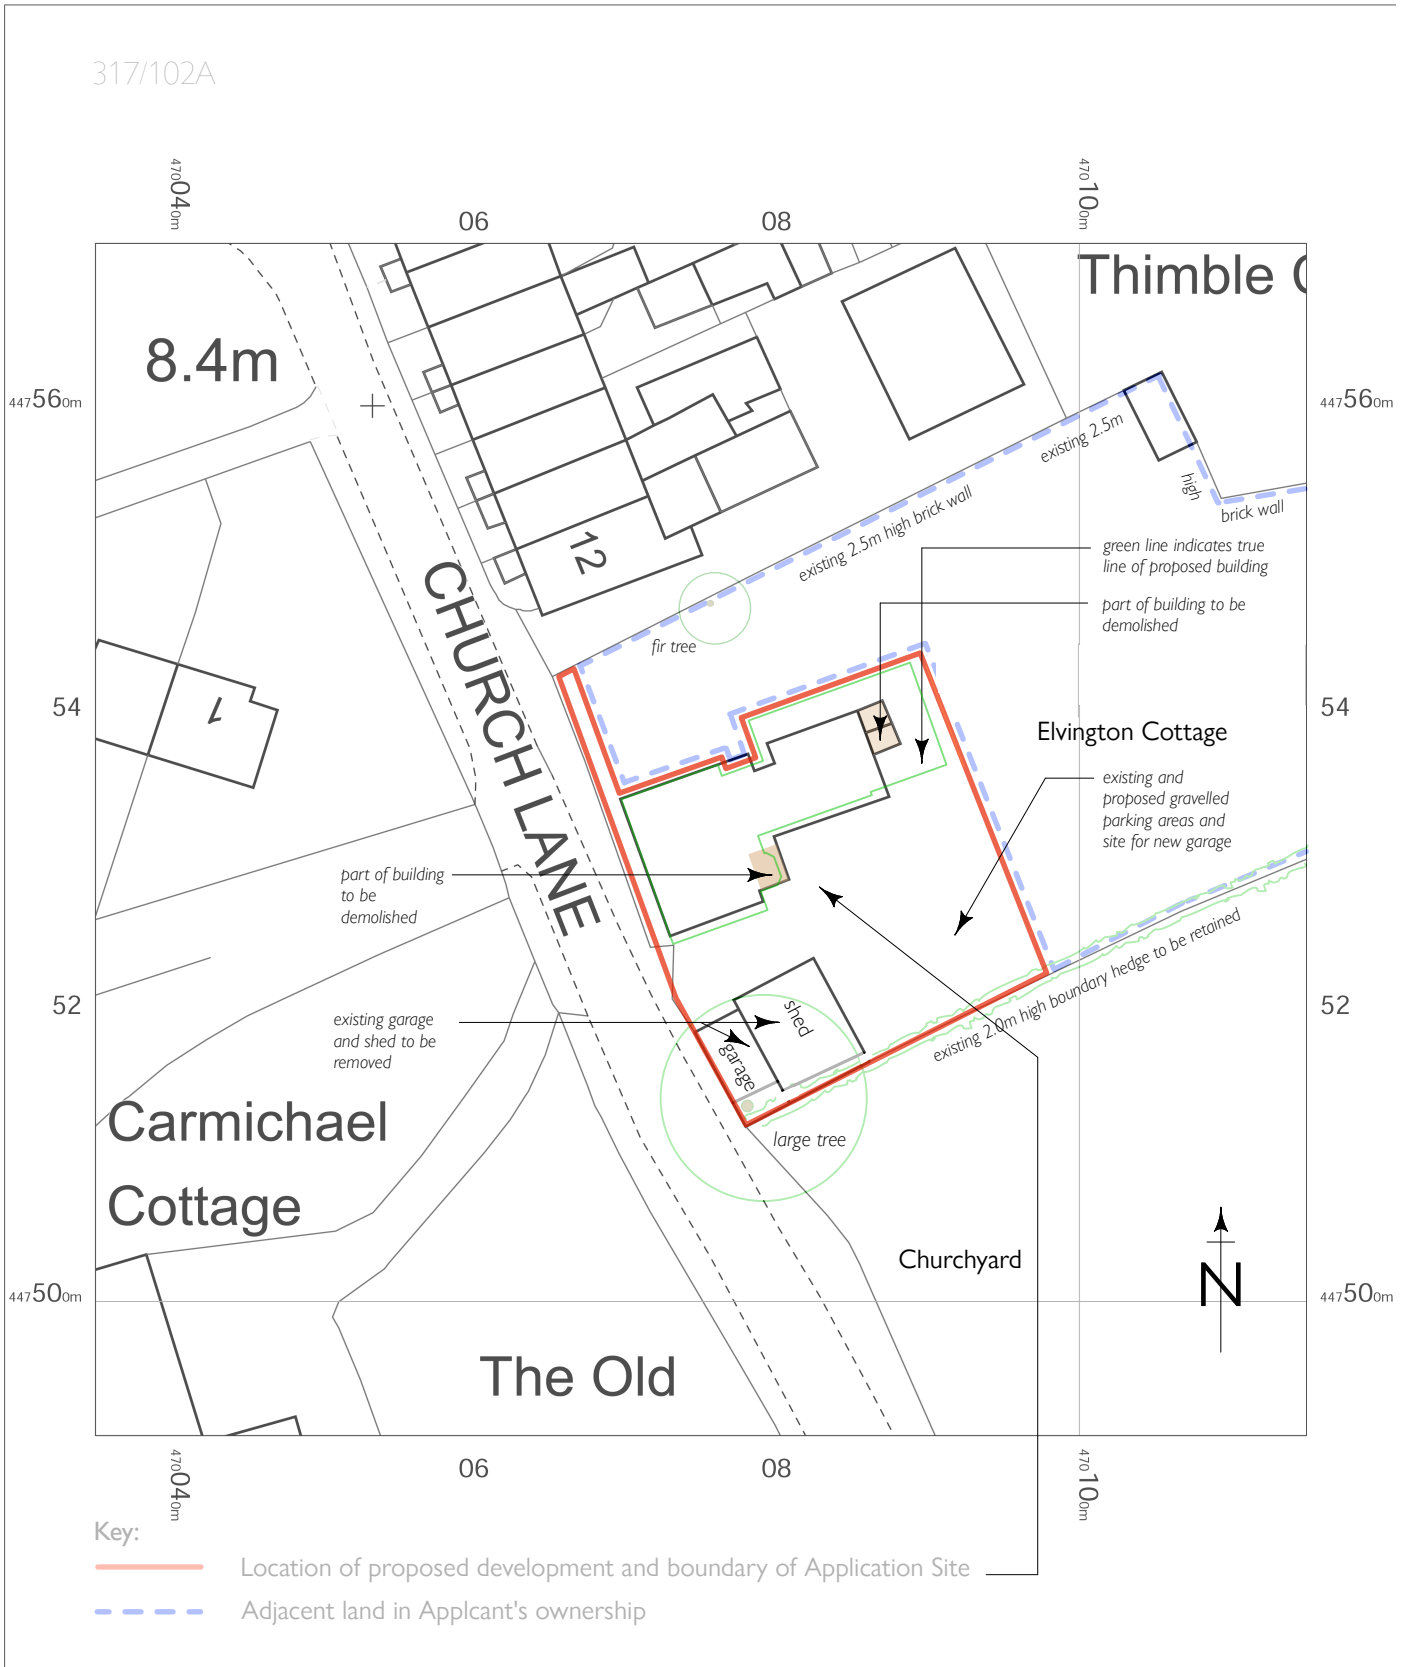

Block Plan Dwg. no. 317/102B 1:500. Issued for Householder Planning Application May 2023

Revision A - red line of application site re-drawn; various items of information added

Revision B - red line of application site re-drawn; true line of building (green outline) added; note added

OS MasterMap 1250/2500/10000 scale
 Sunday, April 23, 2023, ID: MPMBW-01099578
www.blackwellmapping.co.uk

1:500 scale print at A4 Centre: 470075 E 447531 N

Elvington Cottage
 Church Lane,
 Elvington,
 York,
 YO41 4AD

GEOFFREY HOLLAND
 CHARTERED ARCHITECT

BLACKWELL'S
 MAPPING SERVICES
 PERSONAL & PROFESSIONAL MAPPING
www.blackwellmapping.co.uk