


Rear Garden
- 115.5m²




Proposed New Rear
Extension footprint

4715

3263






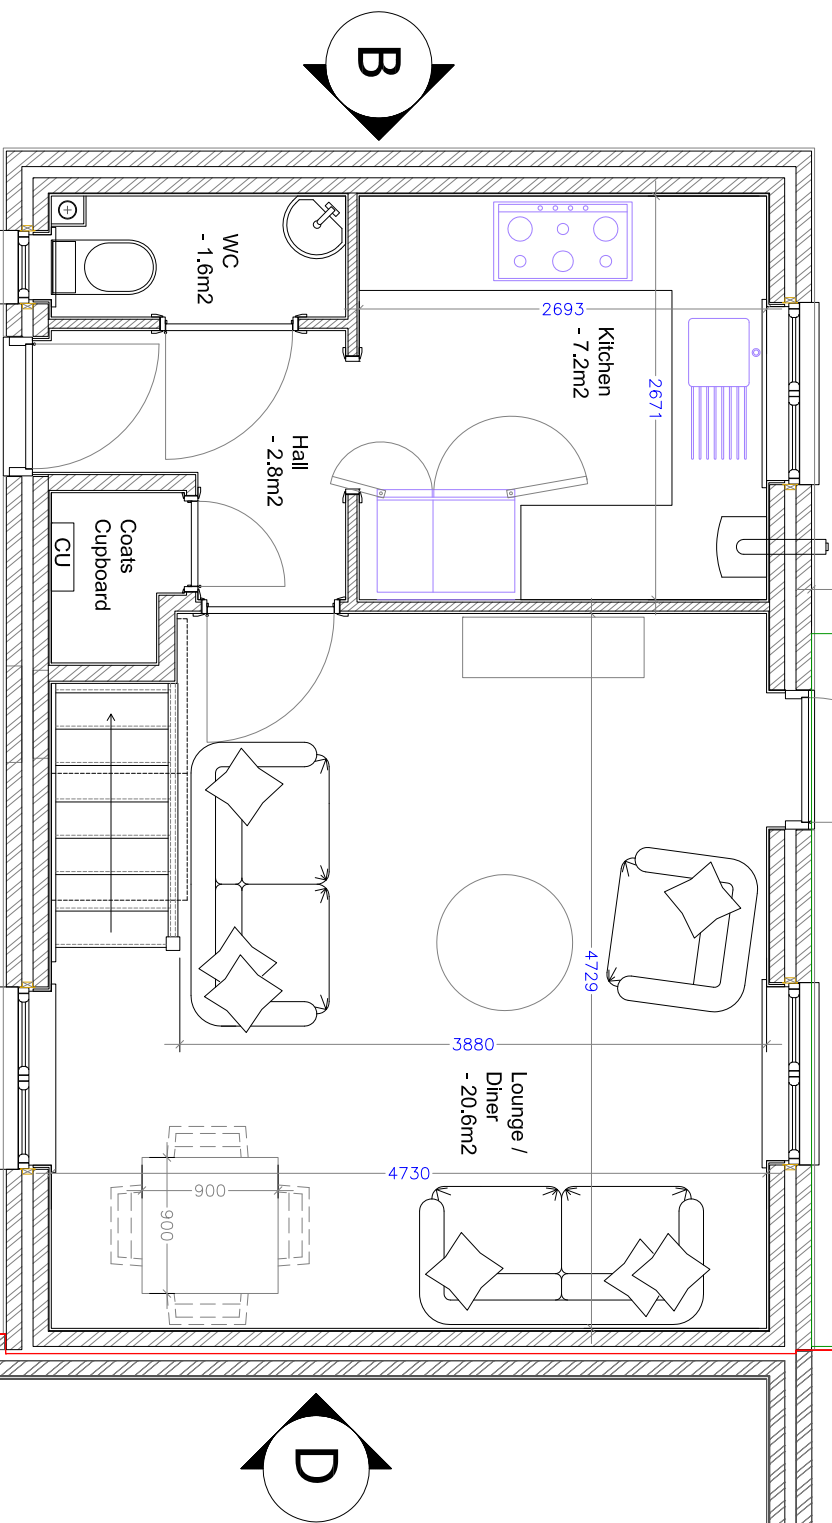


Front Garden &
Parking Amenity
- 88.4m²

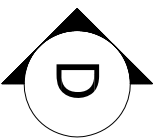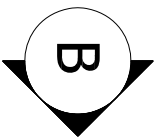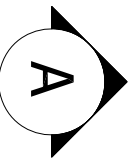

1 EXISTING GROUND FLOOR

EX-GL Scale: 1:50 @ A3

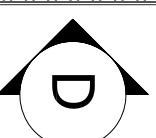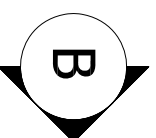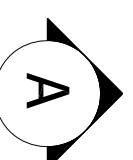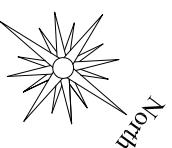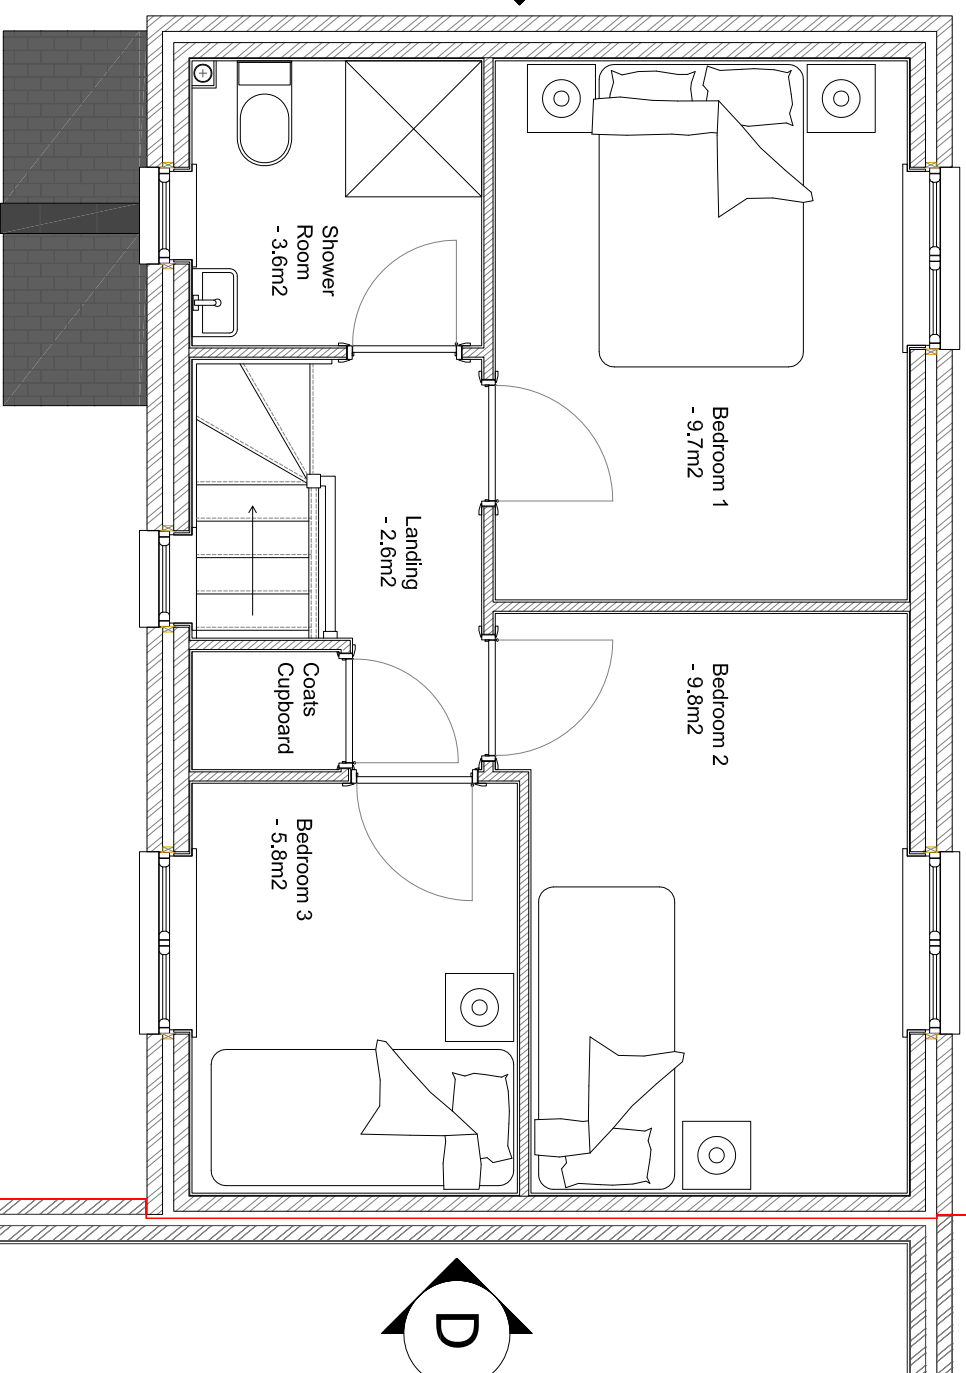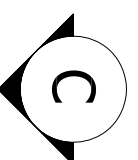

2 EXISTING FIRST FLOOR

EX-G1 Scale: 1:50 @ A3



6: mat@hmdesign.co
t: 07852 199 139
f: www.facebook.com/hmdesignco
registration no: 10394535

CLIENT
Mr & Mrs Spink

DRAWING TITLE
Existing Details

PROJECT
47 Nottley Green, Great Nottley
Braintree, Essex, CM77 7US

DRAWING No. EX-GL SCALE 1:50 @A3

DATE 22-05-2023 REVISION A

ISSUE STATUS
AS BUILT