
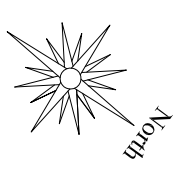


1
LOC

LOCATION PLAN


Scale: 1:1000 @ A3

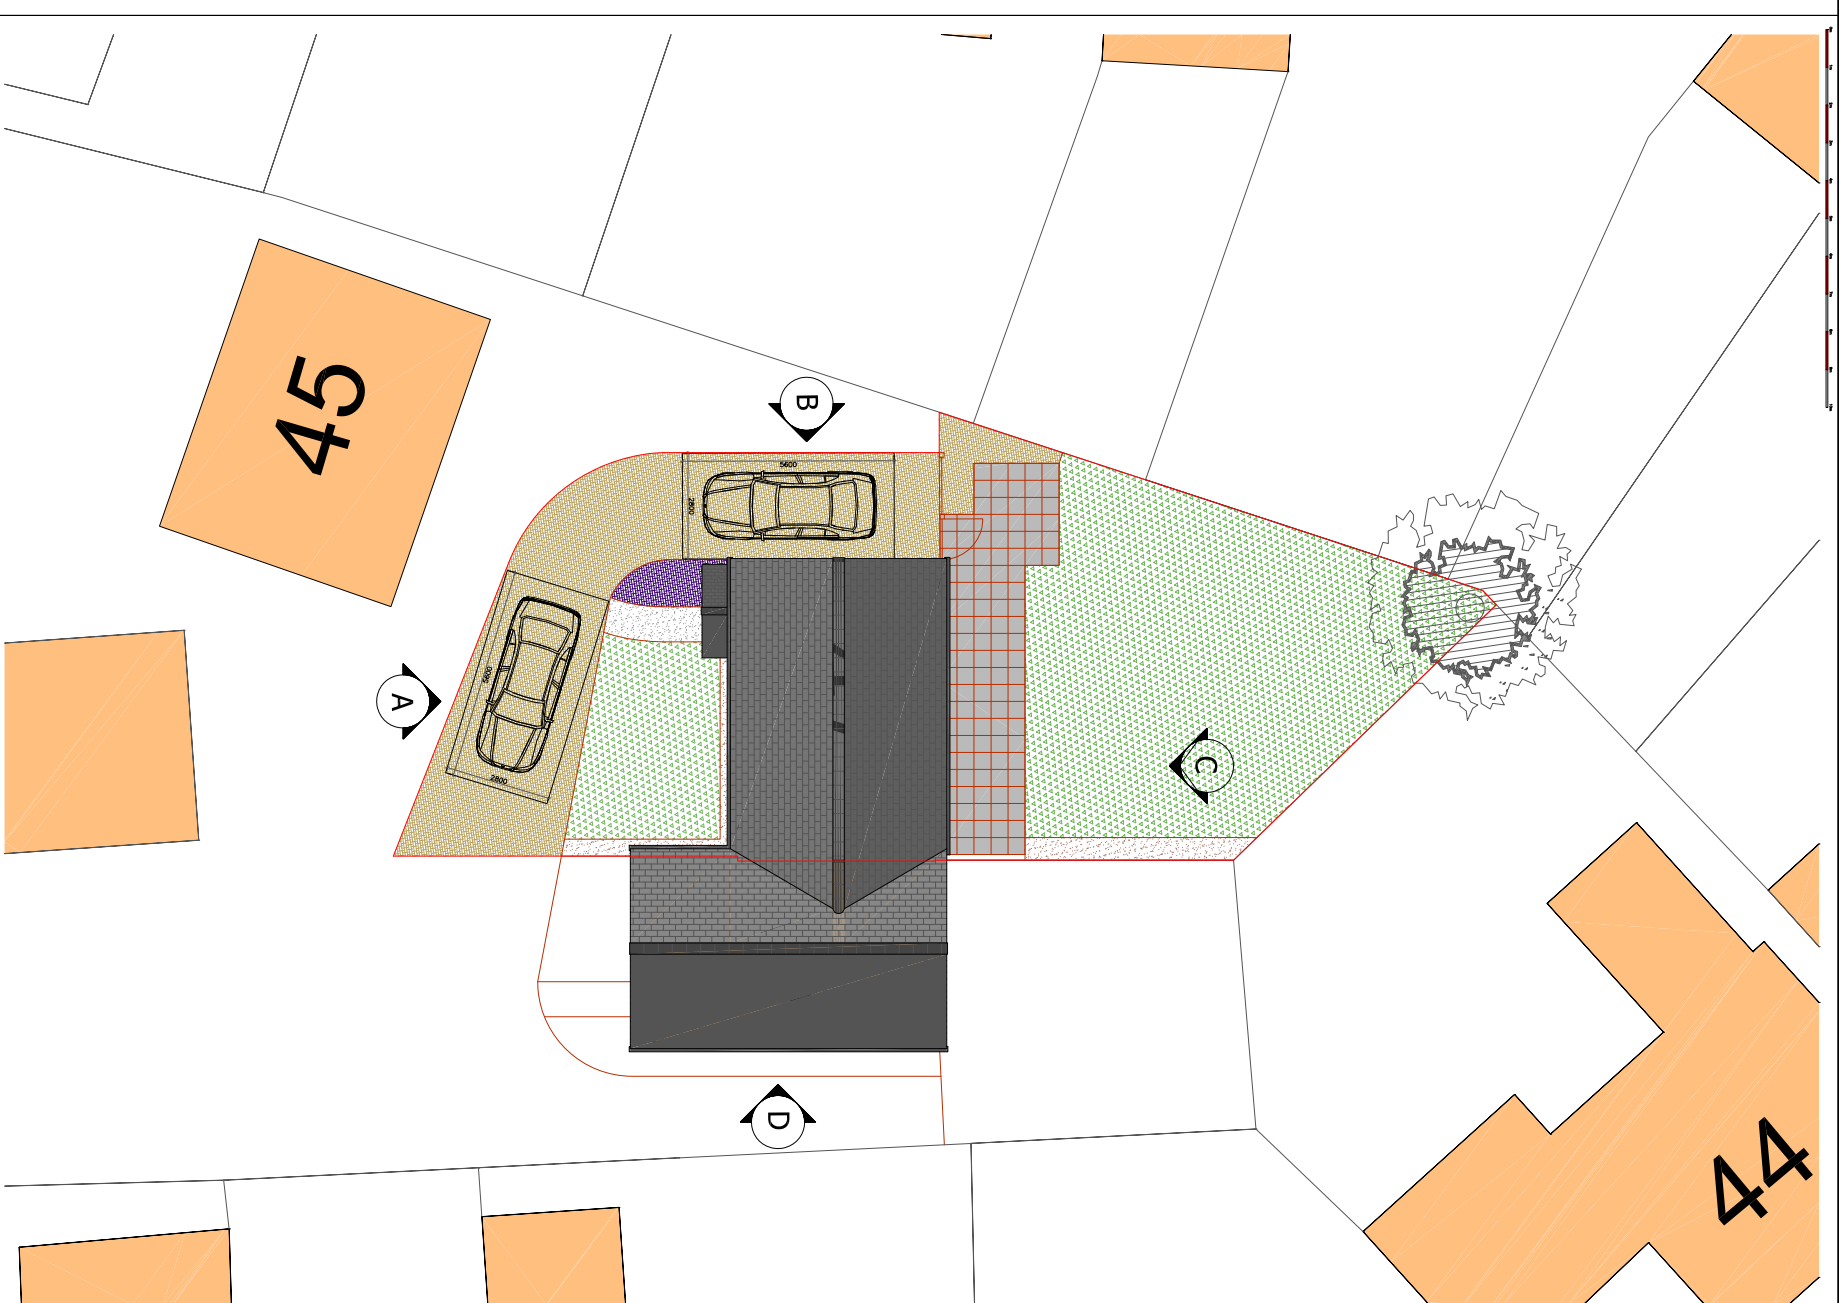

2
LOC

EXISTING ROOF PLAN

Scale: 1:200 @ A3

	
architectural design & planning	
e: mat@unodesign.co t: 07862 199 139 f: www.facebook.com/unodesignco	
registered no: 10384535	
CLIENT	Mr & Mrs Spink
DRAWING TITLE	Location Plan
PROJECT	47 Nolley Green, Great Nolley Braintree, Essex, CM77 7US
DRAWING NO.	LOCATION
DATE	24-05-2023
REVISION	D
SCALE	1:1000 & 1:200 @A3
ISSUE STATUS	AS BUILT