




1
EX-EL
EXISTING ELEVATION A
Scale: 1:100 @ A3

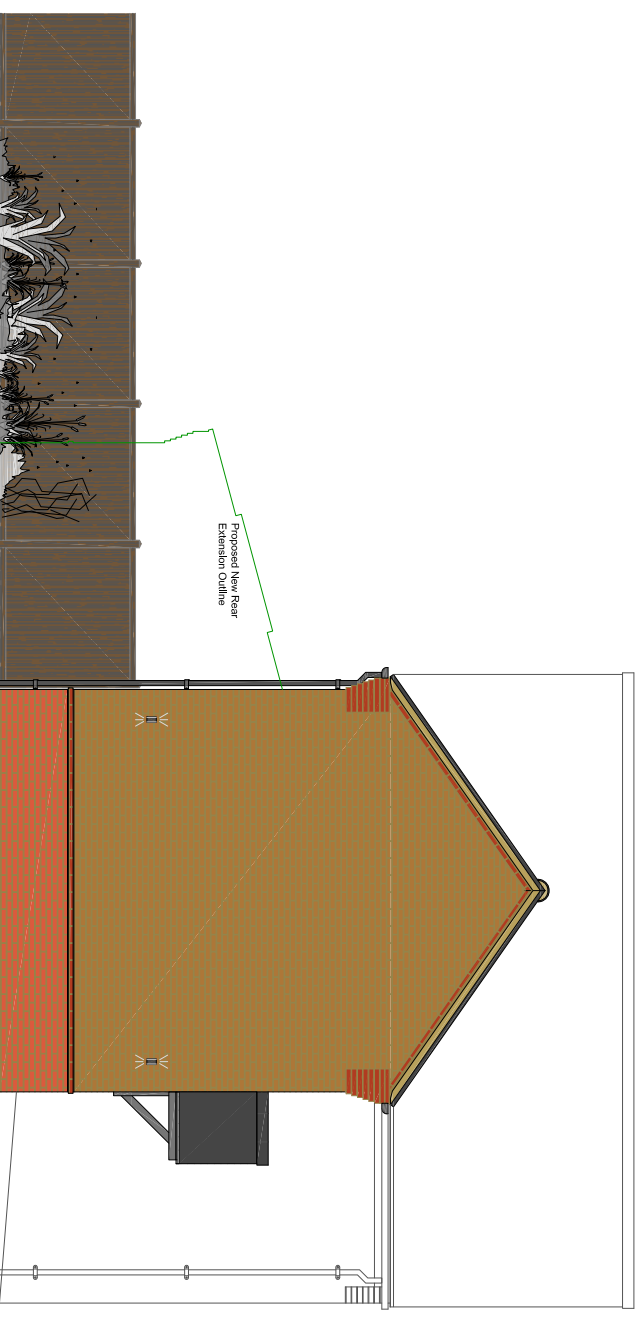

2
EX-EL
EXISTING ELEVATION B
Scale: 1:100 @ A3

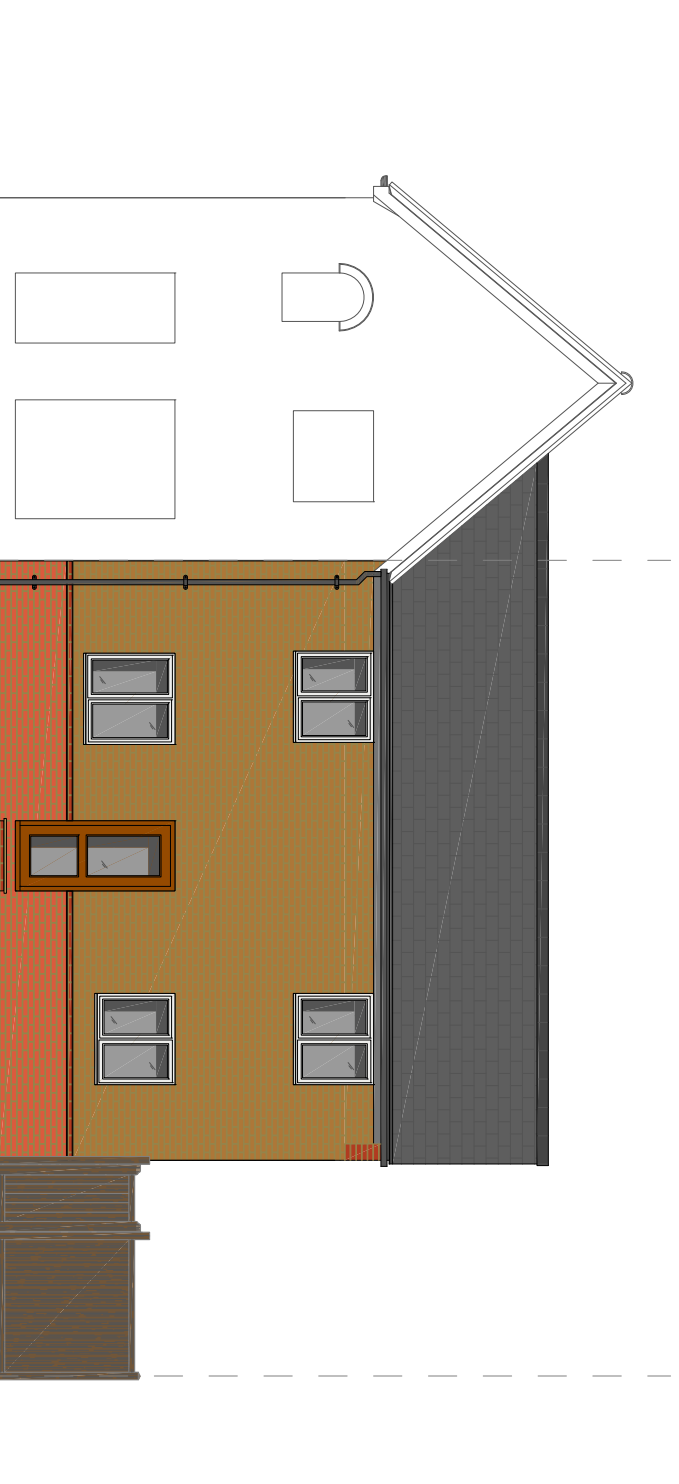

3
EX-EL
EXISTING ELEVATION C
Scale: 1:100 @ A3

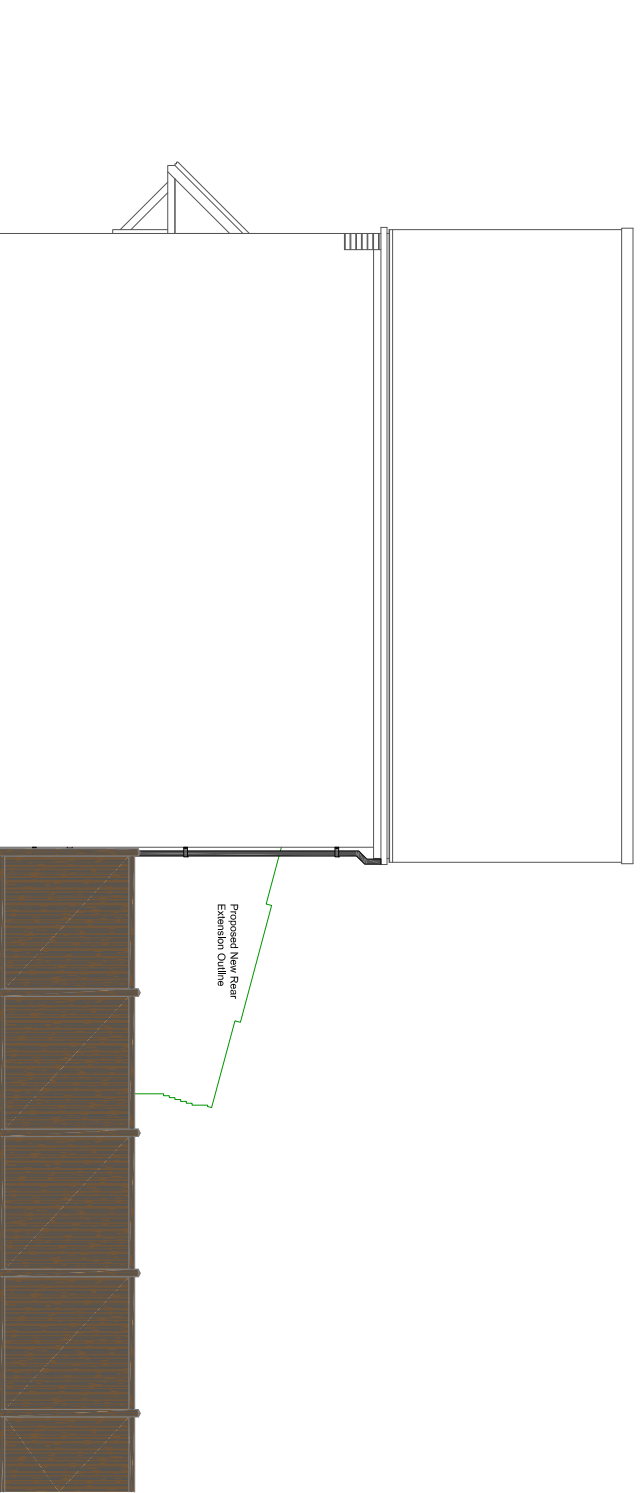

4
EX-EL
EXISTING ELEVATION D
Scale: 1:100 @ A3



CLIENT	Mr & Mrs Spink
DRAWING TITLE	Existing Elevations
PROJECT	47 Nolley Green, Great Nolley Braintree, Essex, CM77 7US
DATE	23-05-2023
ISSUE STATUS	AS BUILT
REGISTERED NO.	10394535
SCALE	1:100 @ A3
REVISION	B