



Do not scale the drawing. Use figured dimensions in all cases. Check all dimensions on site. Report any discrepancies to LH before proceeding.
 ALL STRUCTURAL ELEMENTS TO REFER TO SE SPECIFICATION.

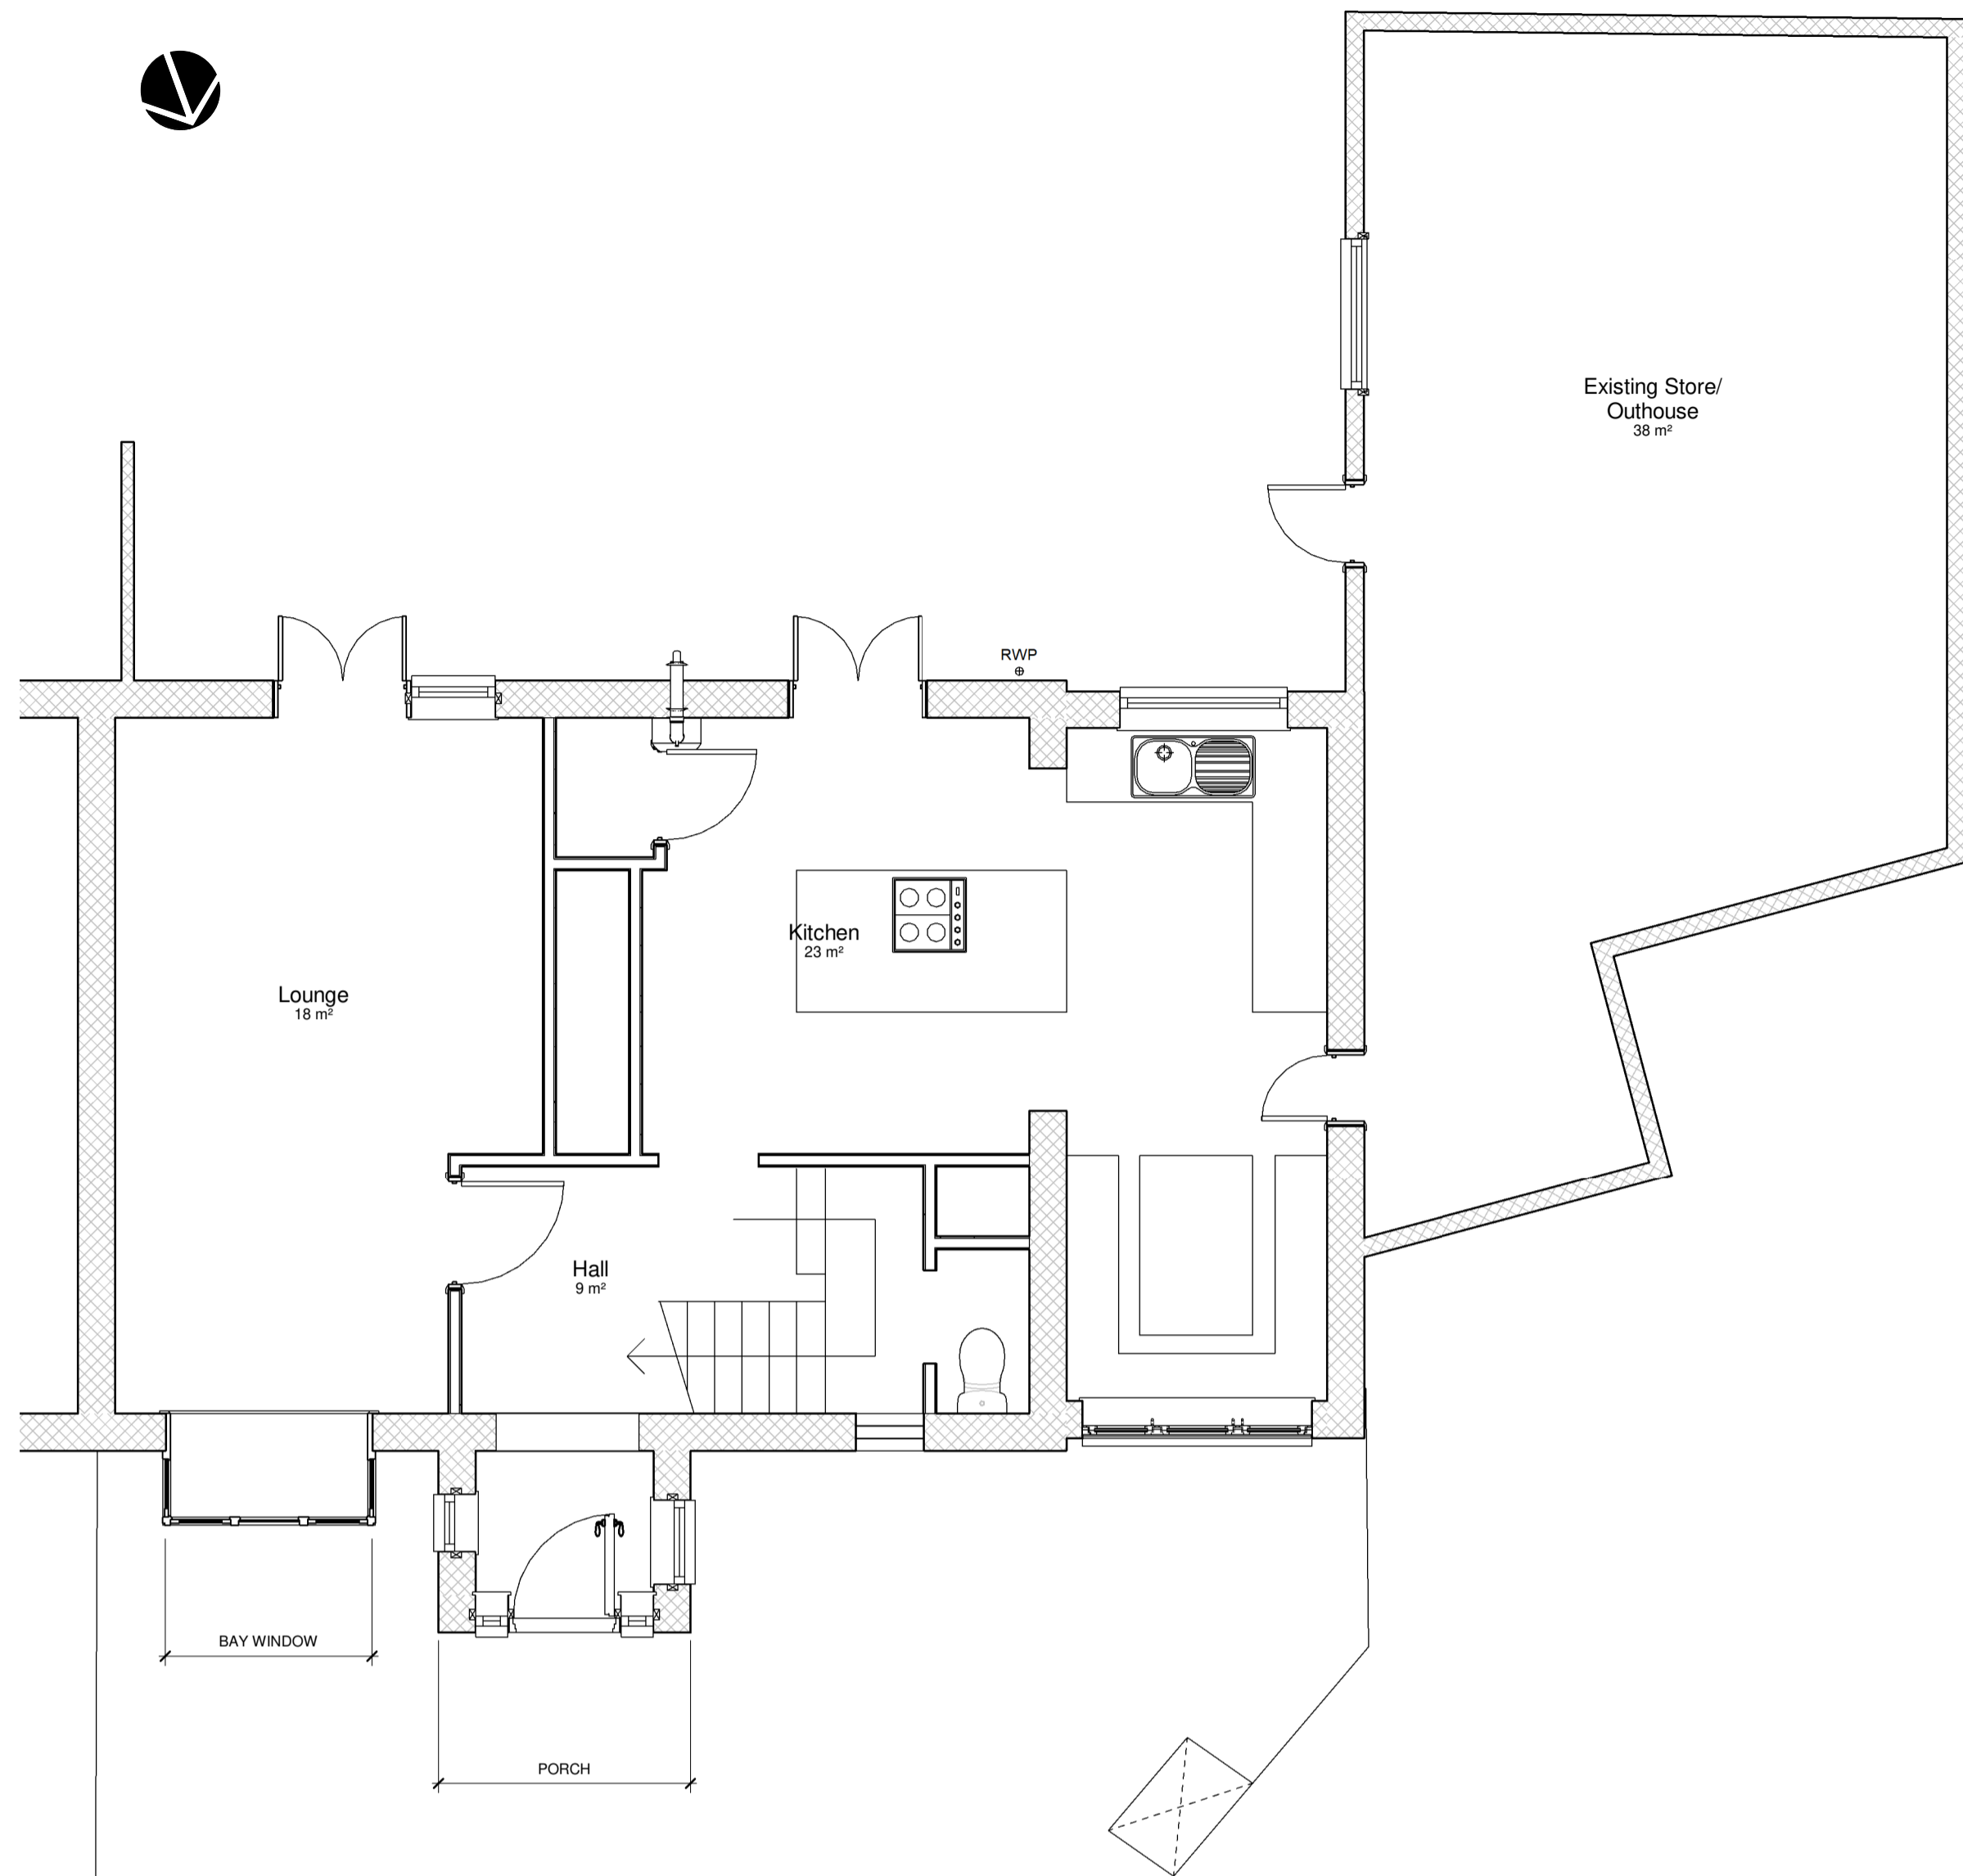


0.1 Existing GF plan

1:50

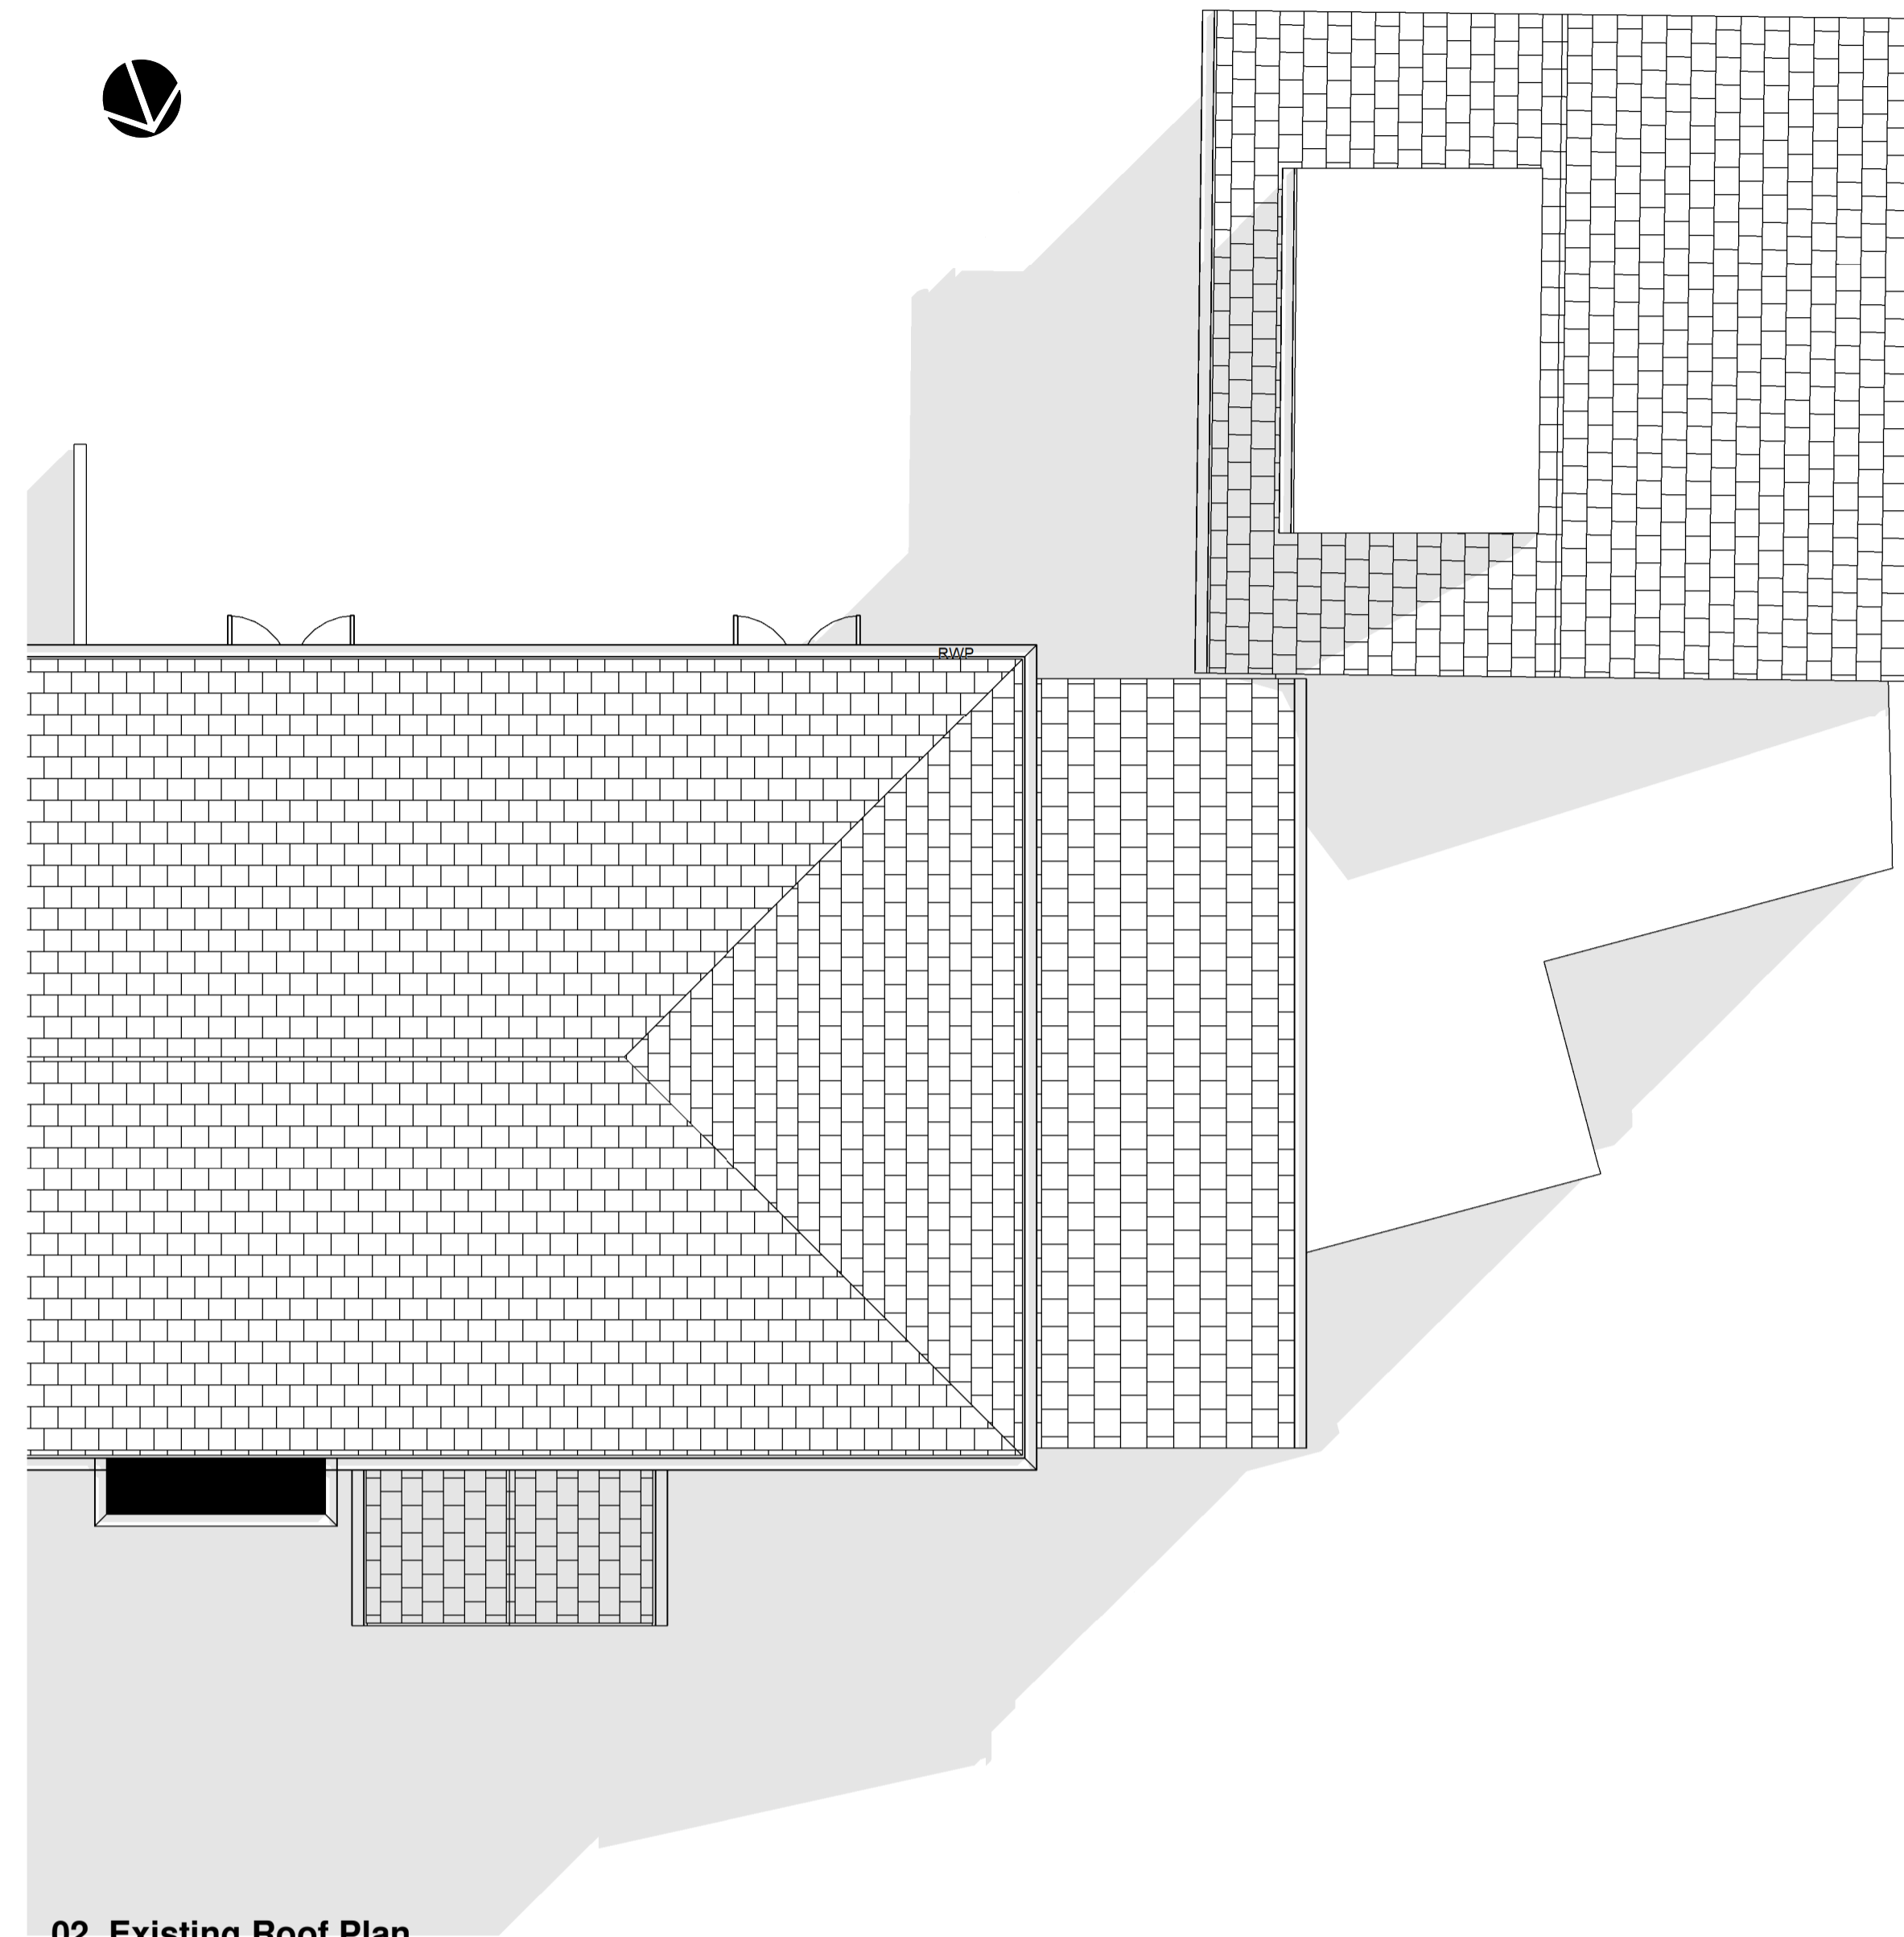


02. Existing Roof Plan

1:50

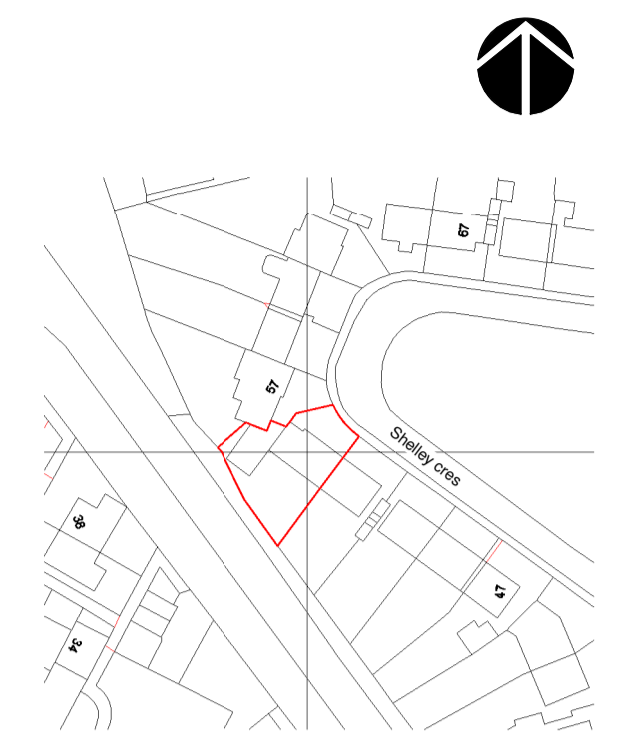

0.1 Location Plan
1:1250

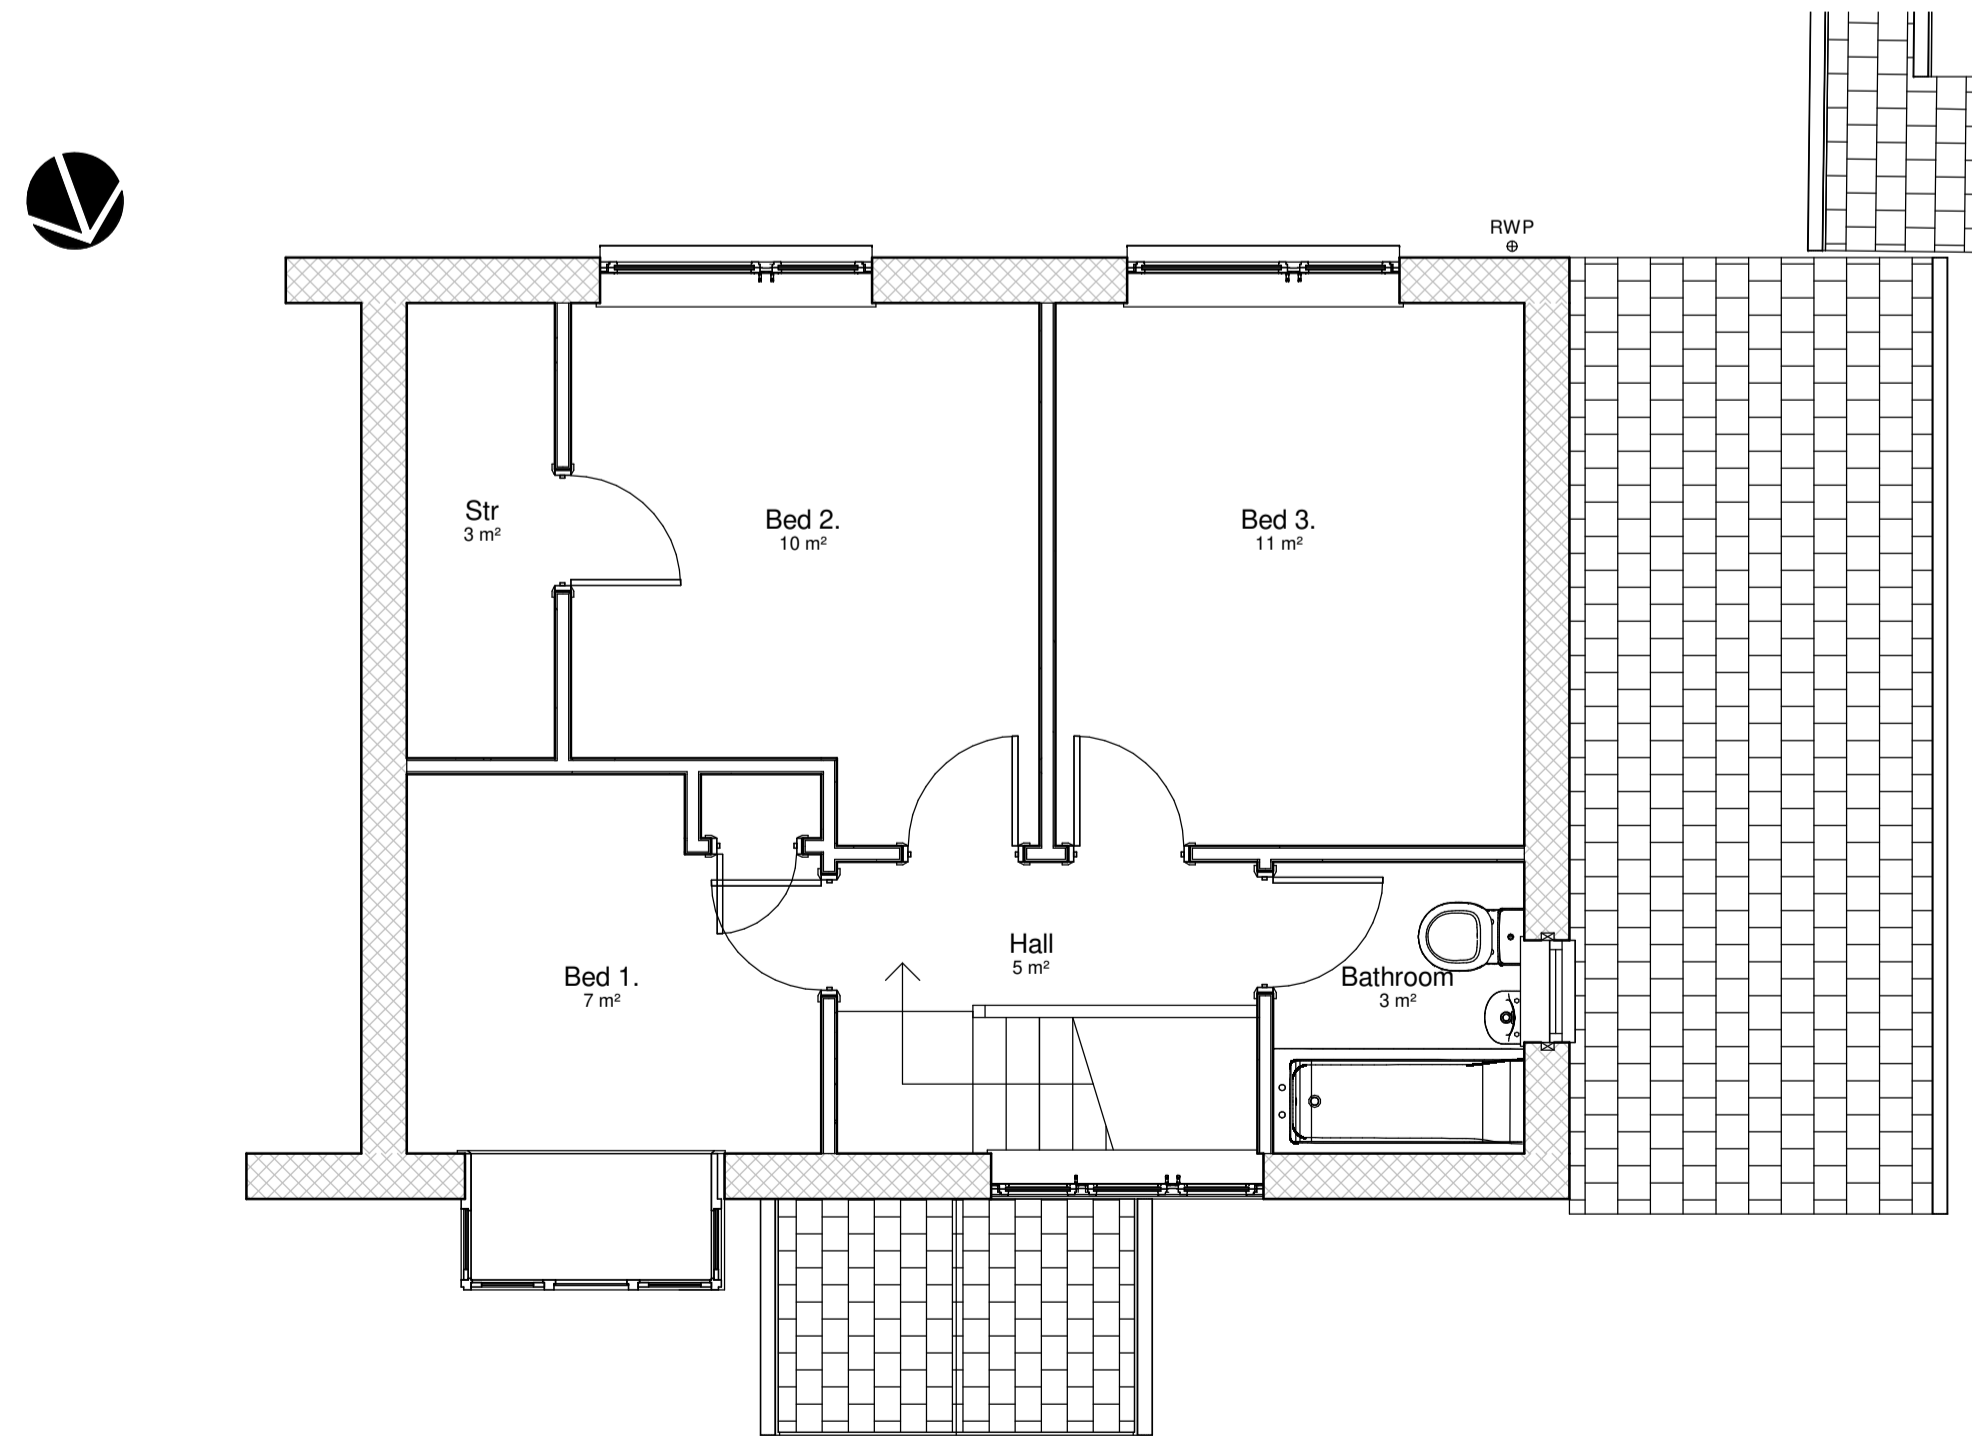

0.2 Existing FF plan

1:50

Lighthouse ARCHITECTURE

Project 55 Shelley Cres Blyth NE24 5RJ		Revision	
Revision 1	Date 27.5.21	Drawn By JW	Comments
Revision 2	Date 26.6.21	Drawn By JW	Comments
Project Title 100-01 Existing/ As built Floor Plans			
Status PLANNING			
Drawn By Author	Scale at A1 As indicated		
Date 11/27/19			

C - THIS DRAWING IS THIS COPYRIGHT OF LHA. NO COPYING OR DISTRIBUTION OF THIS DRAWING OR ANY PART IS PERMITTED WITHOUT PRIOR WRITTEN NOTICE OR PERMISSION.
 THE DRAWING IS FOR PLANNING/ BUILDING CONTROL PURPOSES ONLY. ALL DIMENSIONS TO CHECKED ON SITE PRIOR TO COMMENCEMENT OF WORKS AND PRIOR TO ANY MANUFACTURE.
 ANY DISCREPANCIES TO BE BROUGHT TO THE ATTENTION OF LHA.
 Email - lighthousearchitecture@hotmail.com
 Tel - 07710 046506
 A1 SIZE - SCALE AS SHOWN