


SITE LOCATION



LOCATION PLAN
Scale 1:50000

Based upon Ordnance Survey data with permission of the Controller of Her Majesty's Stationary Office.
© Crown Copyright. All rights reserved.
Spectra Telecom (UK) Ltd. Licence No. AL100034385

SITE LOCATION

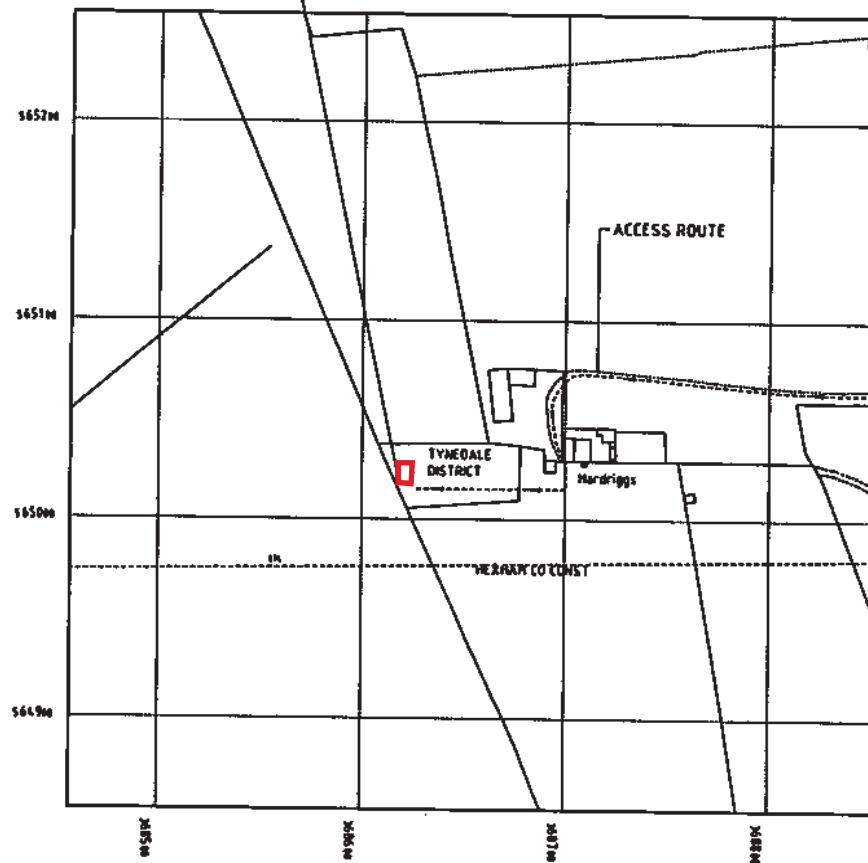

LOCATION PLAN
Scale 1:2500

NOTE: ORIGINAL DRAWING SIZE A3

NOTES

Site co-ordinates:
E 368621 / N 565023

Rev	Date	Amendments	Drawn By	Approved By
B	12.12.07	As-built issue	PH	DB
A	28.03.07	Issued For Construction	JLD	PH

I:\1-drawings\Golfif-1\golfif-1.jpg

Gifford Midlands
Woking
Hinchley
Leicester LE10 3JF
E-Mail: spec@bt.com midlands@bt.com
Tel: 01455 222777
Fax: 01455 222749

I:\1-drawings\Golfif-1\spec-logo.jpg

2nd Floor
Towers Court
Towers Lane
Birmingham B37 7YH
E-mail: Offices@bt.com bt.com

Client:

BT BT Business Services


Job Title
**HARD RIGG FARM
COMB HILL, HALTWHISTLE
NORTHUMBRIA, NE49 9NS**

Drawing Title
**STRUCTURAL DETAILED DESIGN
PROPOSED SITE LOCATION PLAN**

Drawn by	Checked by	Approved by	
DB	DB	DB	
Date Drawn	Date Checked	Date Approved	
08.11.07	08.11.07	08.11.07	
Consultant Ref	Site Code	Drawing No.	Rev.
W11062	NTHU62A GF_NTH38	11	B



PLAN ON TOWER @ +15.0m
ANTENNA CONFIGURATION 11

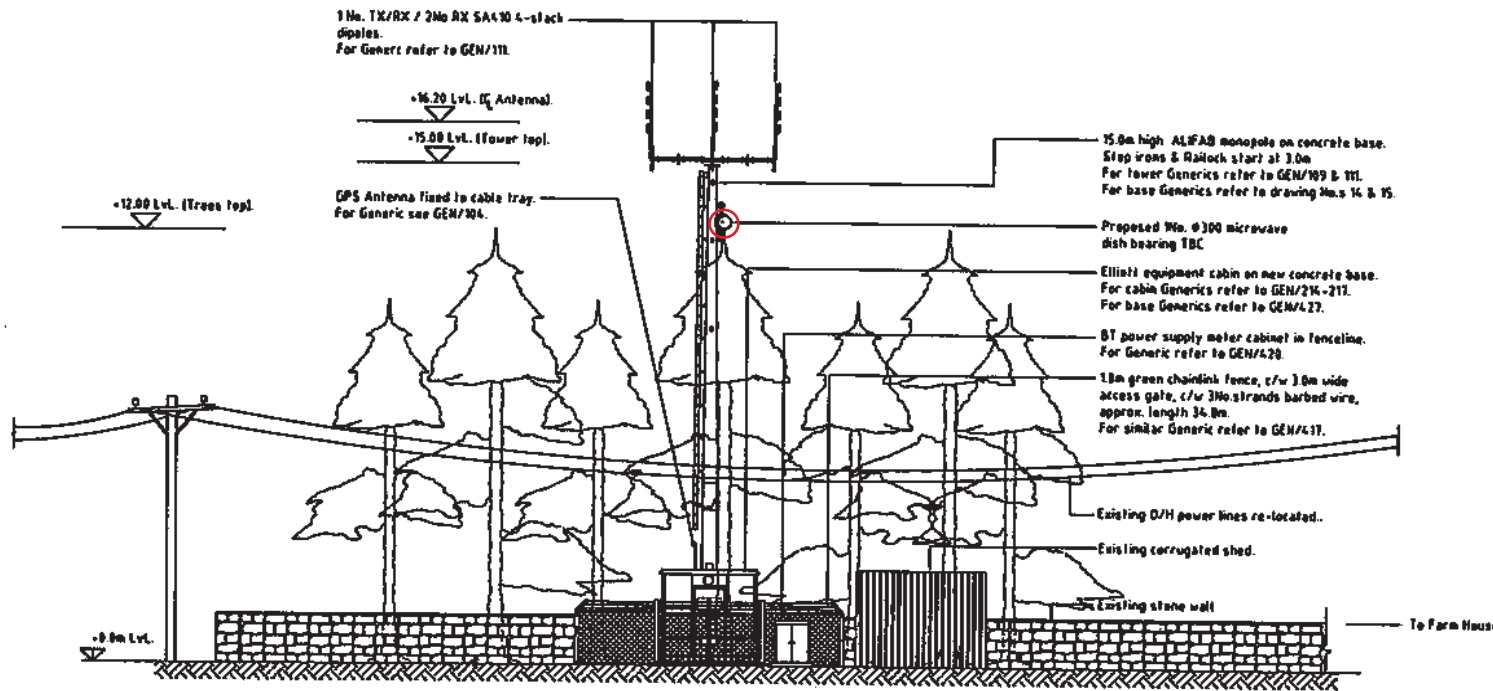

PROPOSED SOUTH ELEVATION
Scale 1:150

NOTE: ORIGINAL DRAWING SIZE A3

NOTES

BT-PSRCP Antenna / Dish Schedule

Antenna Configuration 11

Duplicate Required Y

Antenna/Dish Ref.	Antenna Type	Size (mm)	Height A.S.L. (m)	Antenna Bearing	Cable Type	Cable Length (m)
TX/RX	4 Stack		15.2	090	LOFA-50	22.9
Rb	4 Stack		15.2	090	LOFA-50	22.9
Rc	4 Stack		15.2	090	LOFA-50	22.9
AS	GPS	100	-	TBC	AG 24	5.8
Td	DISH	300mm dia	TBC	TBC	LOFA-50	22.9

BT-PSRCP Tower Schedule

Tower	Monopole		
Height	15.0m A.S.L.		
Colour	BS 4800 Y C 30		
Top Hat	N		
Roof Area	Y	Working Platform	0.1m ²
Dish Mount	Subsidiary Mount	Working Platform	TBC
Transfer Platform	N		
Climbing System	Ladder	Start Height	3.0m
Access Hatch	Y	End	Y

D	12.12.02	As-built issue	PW	DB
A	21.03.07	Issued For Construction	ALD	PH
Rev	Date	Amendments	Drawn	Approved
			By	By

E:\1-drawings\Collif-1\goRf-1.jpg

Collif Midlands
10 May
Leeds
Leeds LS10 5JF
E-mail: collif@collif-midlands.co.uk
Tel: 01455 272777
Fax: 01455 272749

E:\1-drawings\Collif-1\spec-logo.jpg

2nd Floor
Kensley Court
Kensley Lane
Warrington WA2 7UR
E-mail: D11@bt.a.spectro-td.com
+44(0)1925 418880
+44(0)1925 419951
Fax: 01455 272749

Client

BT
BT Home Services
Home Line
Warrington
Warrington WA2 7UR

Job Title
**HARD RIGG FARM
COMB HILL, HALWHISTLE
NORTHUMBRIA, NE49 9NS**

By
**CIVIL STRUCTURAL DETAILED DESIGN
PROPOSED SOUTH ELEVATION.**

Scale 1:150 (as per Scale 1:150)

Drawn by DB	Checked by DB	Approved by DB
Date Drawn 08.11.01	Date Checked 08.11.01	Date Approved 08.11.01
Consultant Ref W11062	Site Code NTHU62A GF_NTH38	Drawing No. 13 Rev. B