


SITE LOCATION PLAN  
AREA 16 HA  
SCALE: 1:2500 on A4  
CENTRE COORDINATES: 467670 , 156512

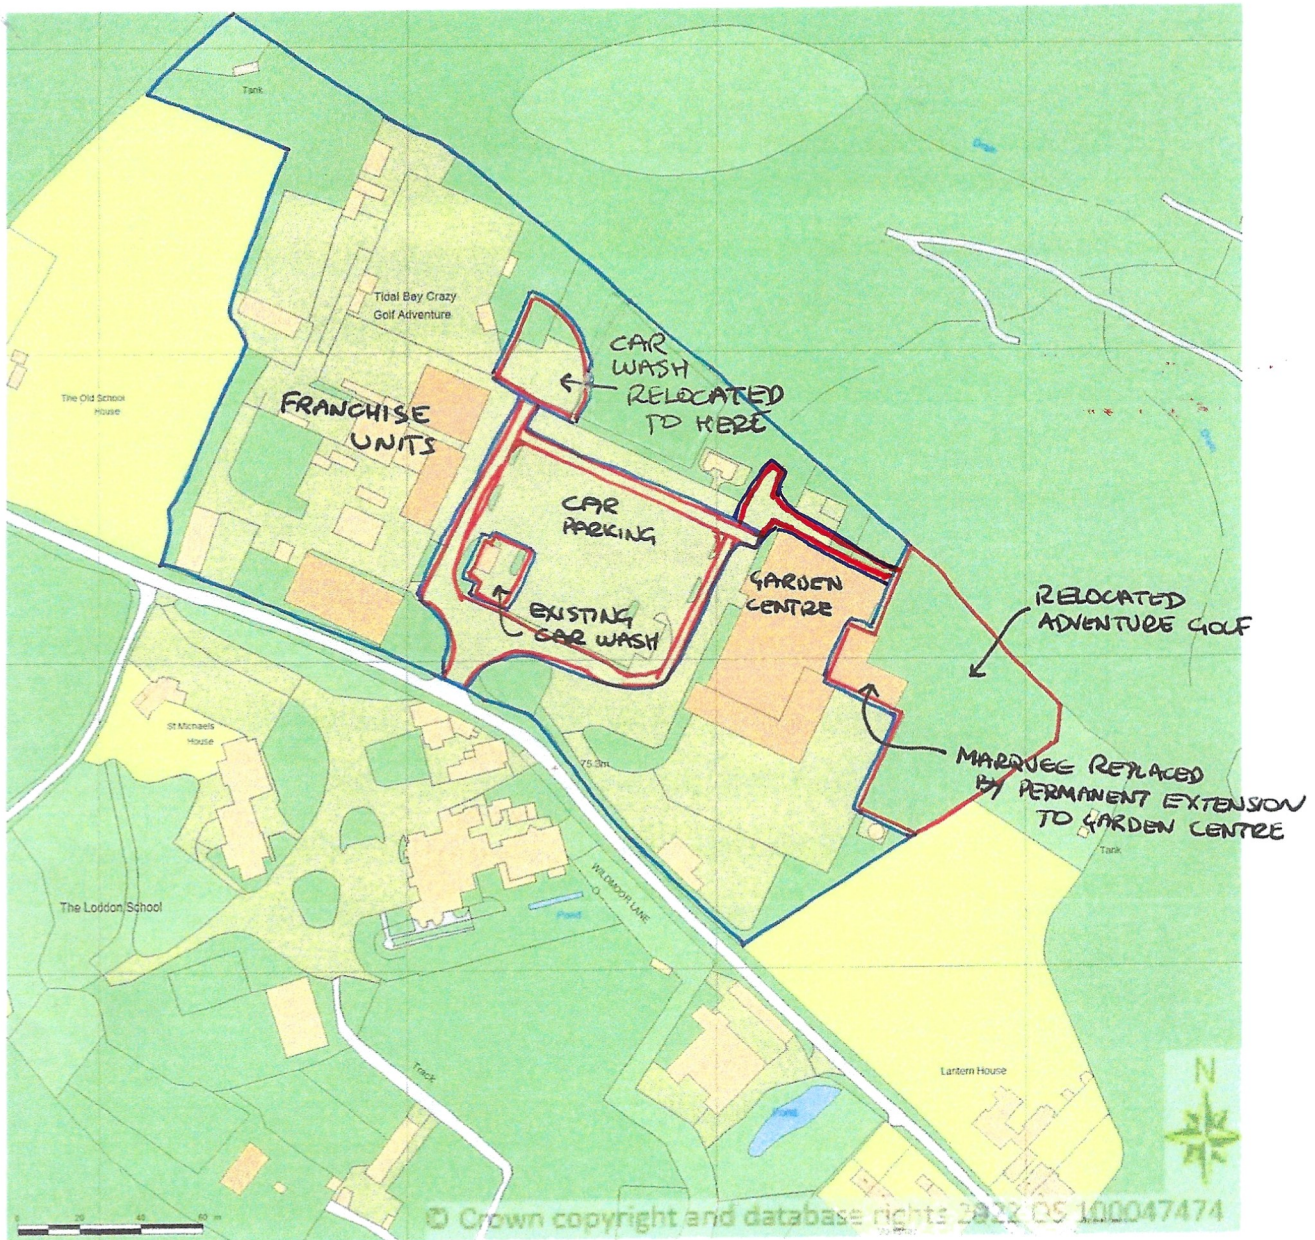

CAPITAL GARDEN CENTRE  
WILDMOOR LANE  
RG27 0HL

Supplied by Streetwise Maps Ltd  
www.streetwise.net  
Licence No: 100047474  
16:30:25 24/06/2022

AMENDED RED LINE PLAN  
~~16/02/2023~~  
31/05/2023