




As Built Front Elevation -1:100 A1

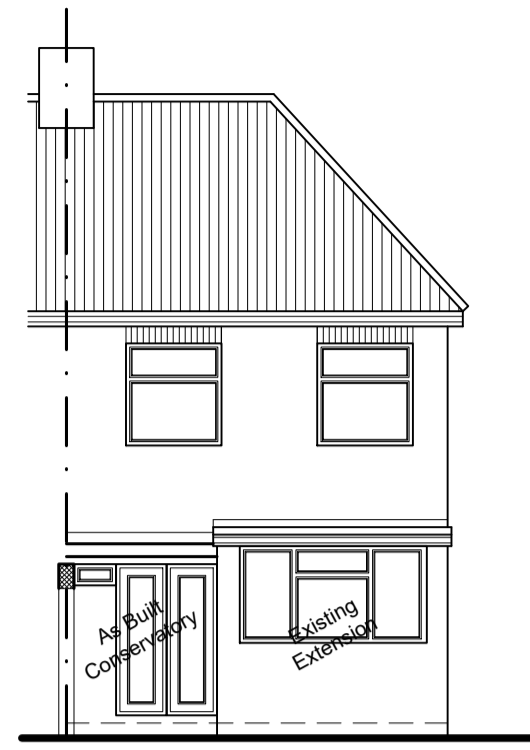

As Built Rear Elevation

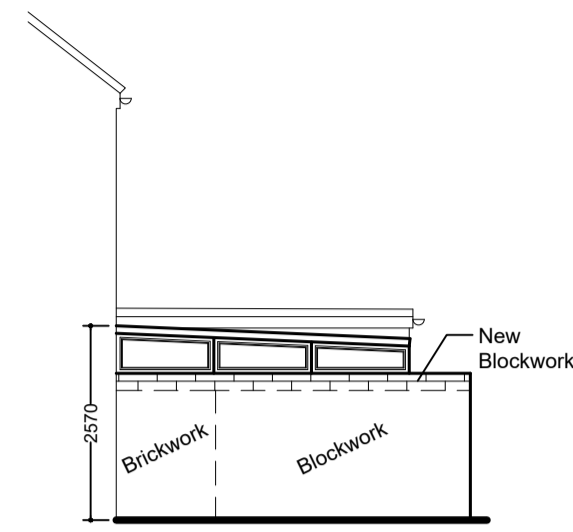

As Built Side Elevation

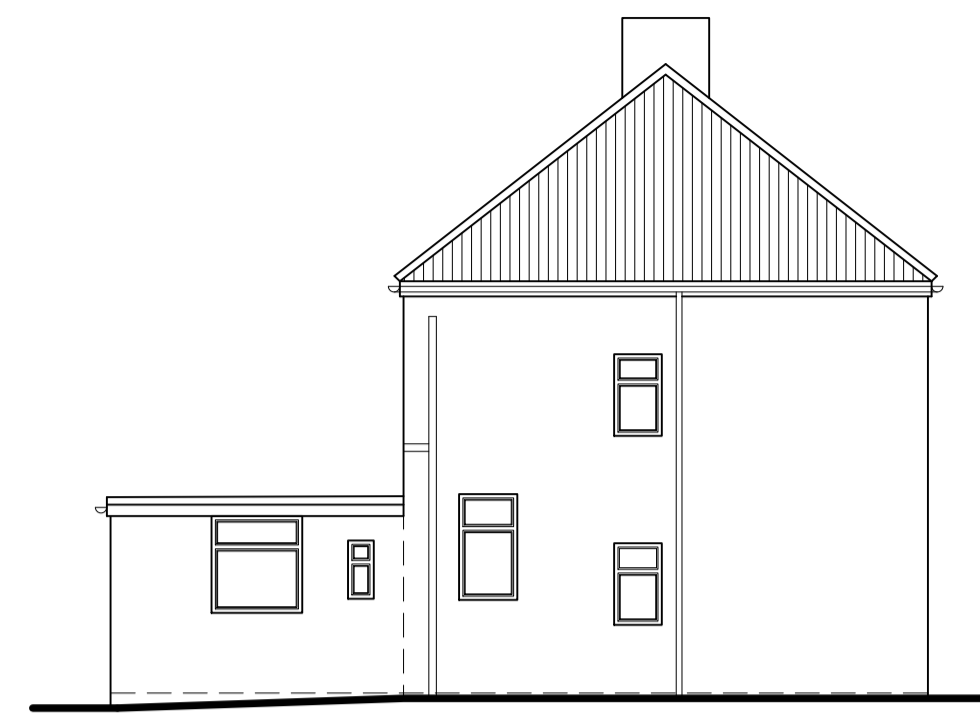


As Built Side Elevation

NOTE
DRAWINGS TO BE SUBMITTED TO BUILDING CONTROL,
TO AWAIT BUILDING CONTROL COMMENTS / APPROVAL


NOTE
CONTRACTOR IS TO UNDERTAKE A TRIAL HOLE FOR
INSPECTION TO CONFIRM FOUNDATION DESIGN PRIOR
TO ANY COMMENCEMENT OF WORKS ON SITE

NOTE
CLIENT TO ENSURE THAT ALL RELEVANT PARTY WALL
ACT NOTIFICATIONS ARE IN PLACE PRIOR TO THE
COMMENCEMENT OF WORKS ON SITE

Private sewers & Lateral Drainage
On commencement of building works a thorough investigation
of drainage should be undertaken on site to establish if any
Private sewers & Lateral Drainage owned by the Local
Sewerage Undertake (Yorkshire Water) will be affected by the
proposed building work

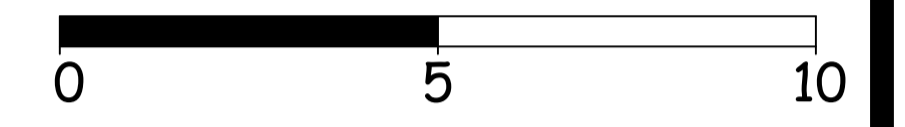

Scale Bar - 1:100

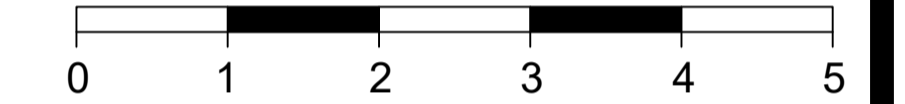

Scale Bar - 1:50



195 Holderness Road, Hull, HU8 8TA
Tel: 01482 707499 Mob: 07402 070779

CLIENT
Mr Paul Wilks
4 Lambert Park
Hedon
HU12 8HF


JOB TITLE
**Proposed Retrospective
Planning Application**

DWG. TITLE
**As Built Floor Plans and
Elevations**

SCALE 1:50 1:100	DRN -
----------------------------	----------

DATE	ALTERATION	BY	REV
08/08/23	Planning Updates	TP	A
17/08/23	Planning Updates	TP	B

DWG. NUMBER N2696-23-01	DATE Jun 23	REV B
-----------------------------------	-----------------------	-----------------

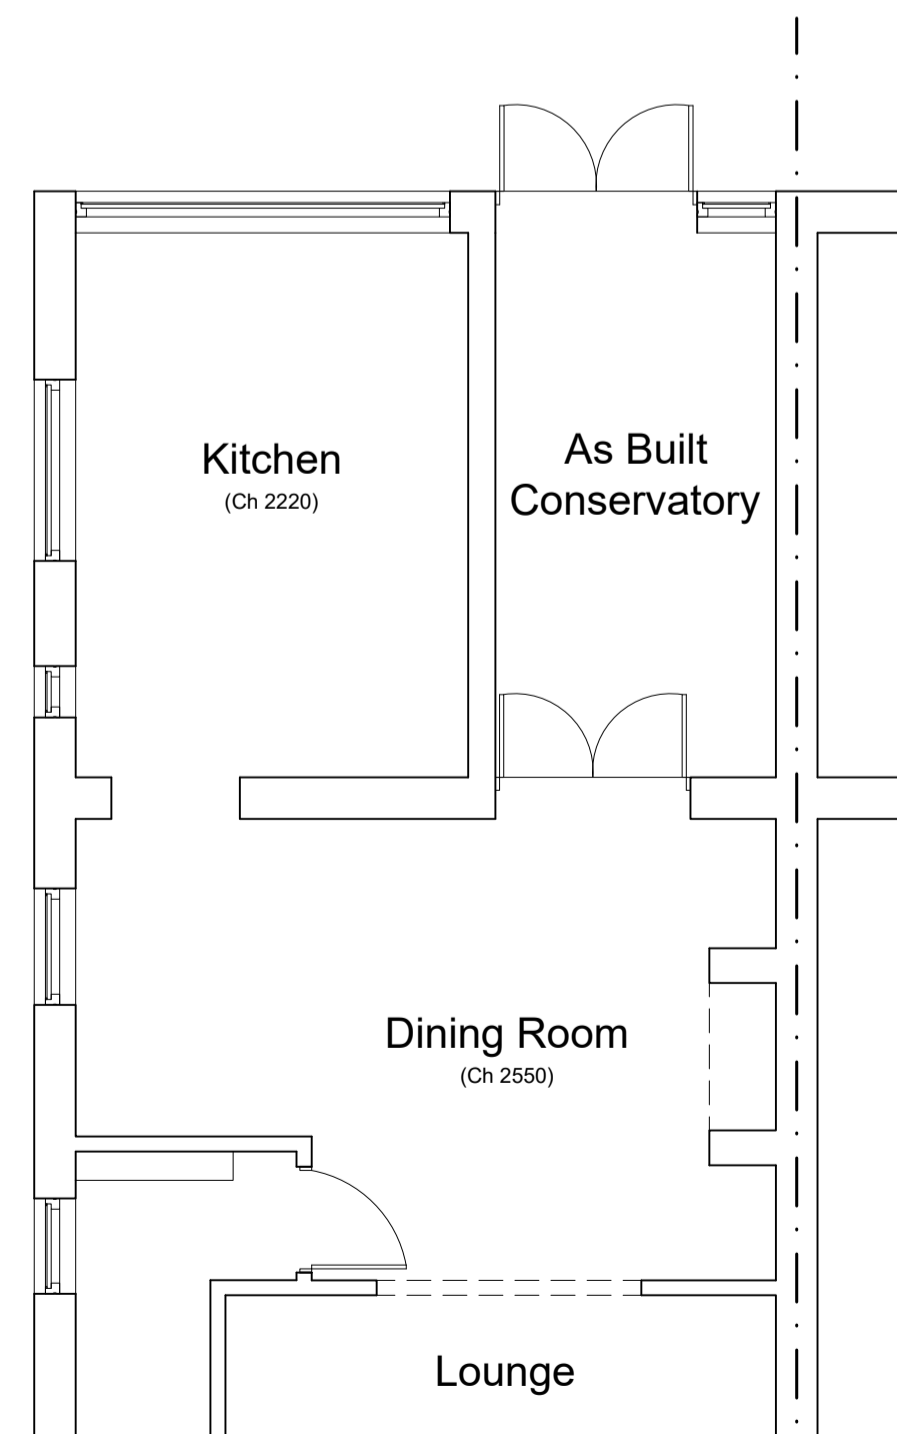

As Built Ground Floor Plan -1:50 A1