




Existing As Built First Floor Plan  
Scale 1:100

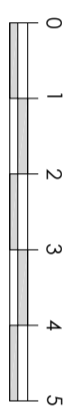

Loft Floor  
NOT DRAWN  
No works Carried out  
at this Level

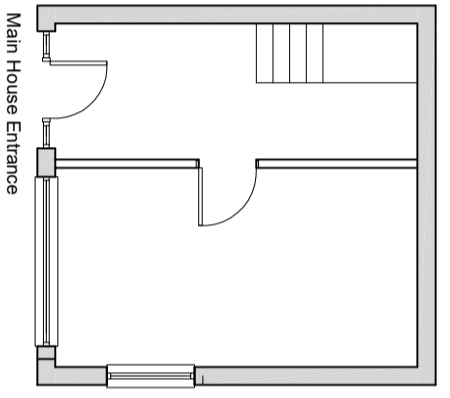


Existing Lower Ground Plan  
Front Entrance Level  
Scale 1:100

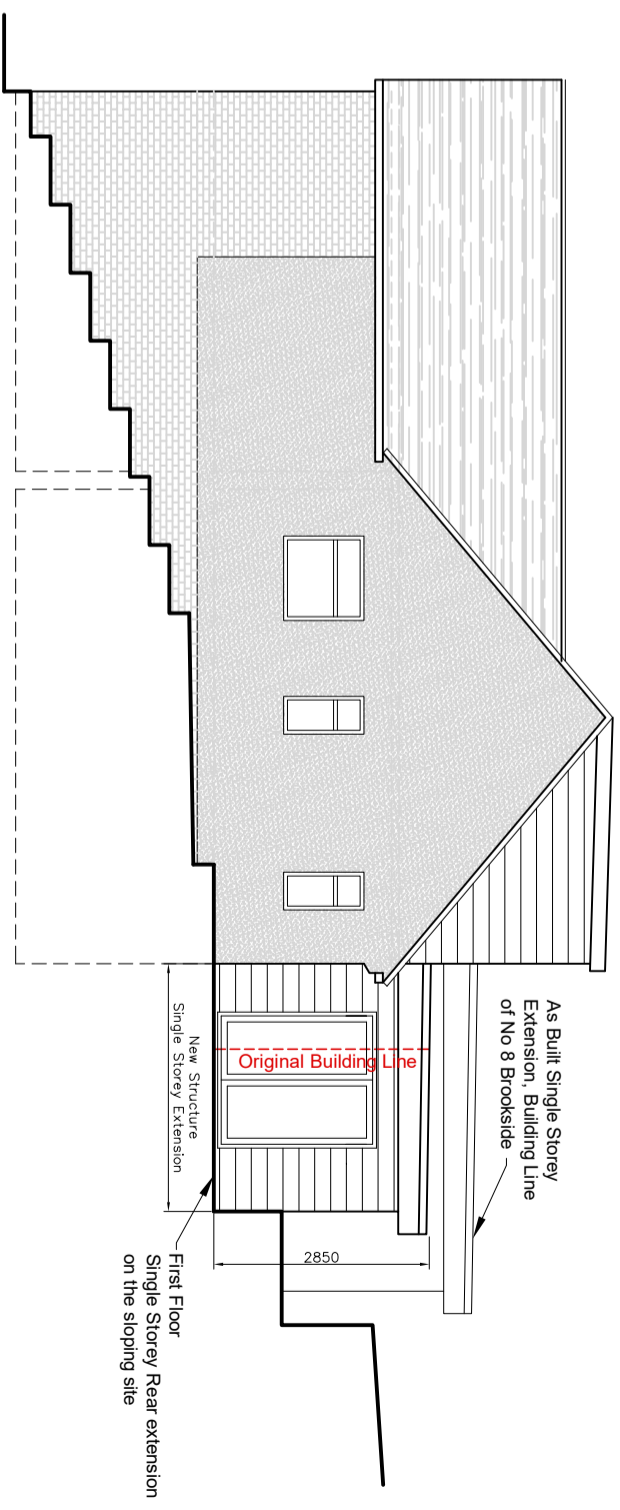


Existing As Built  
Side / North Elevation  
Scale 1:100

Finishes:  
All Generally to match existing  
Roof: Flat  
Walls: Cladding  
Windows and Doors: PVCu  
Colour: Grey  
Colour: Grey  
Colour: White

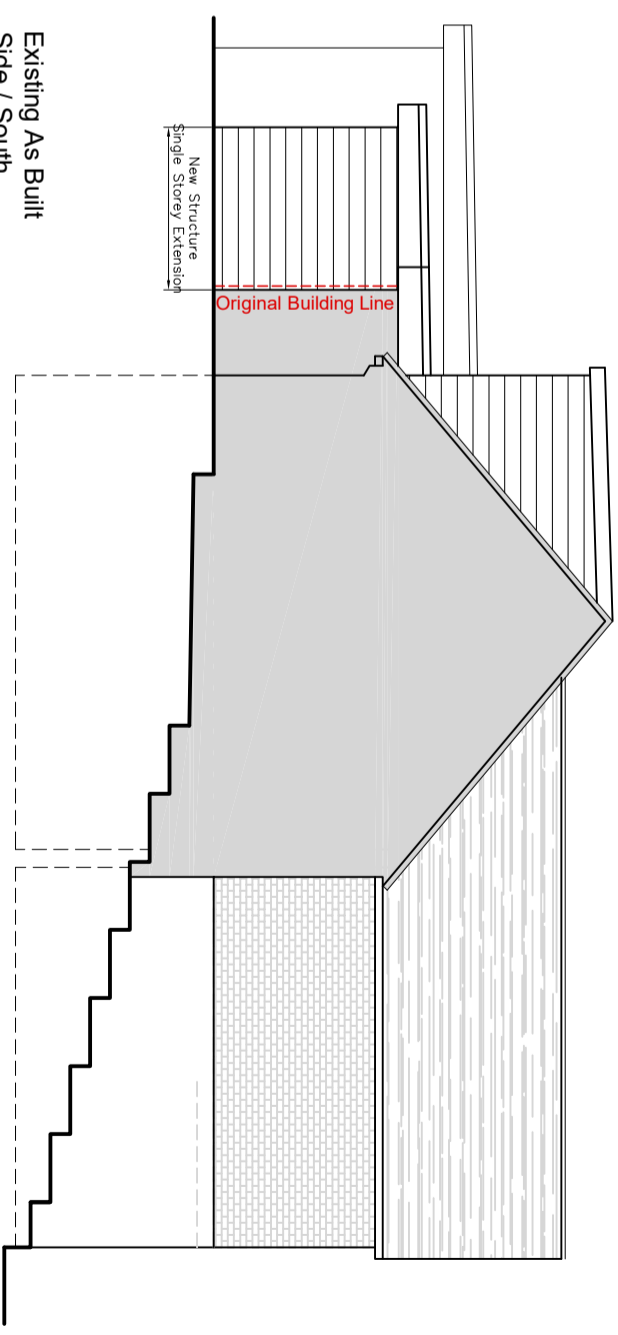

Existing As Built  
Side / South  
Section Through Semi Pair  
Scale 1:100

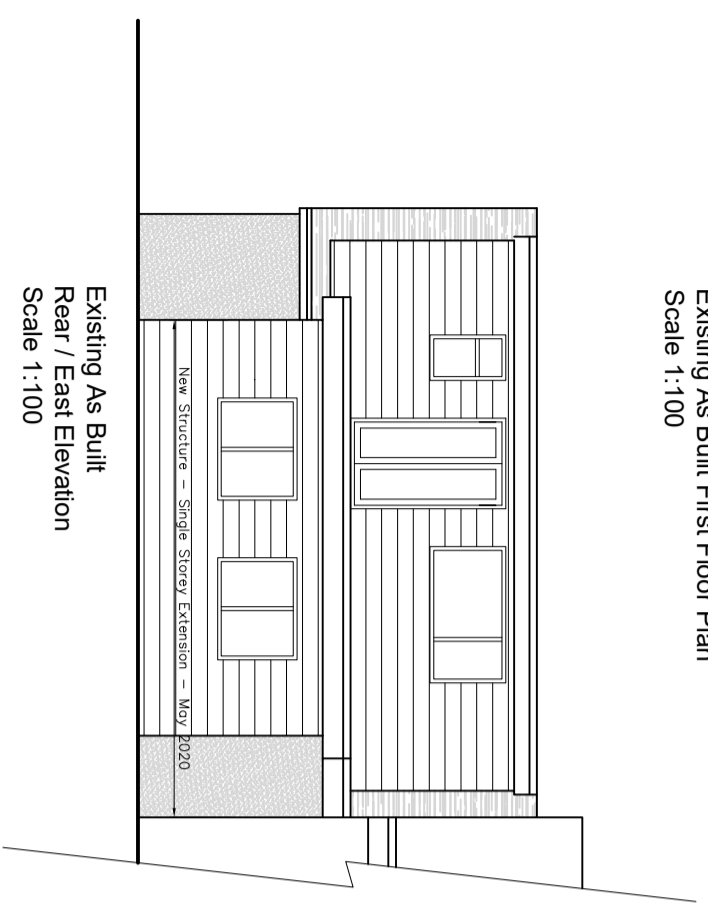

Existing As Built  
Rear / East Elevation  
Scale 1:100

**NOTES**  
Responsibility is not accepted for errors made by others in scaling from this drawing  
All construction Information should be taken from figured dimensions only  
All dimensions to be checked on site prior to construction.  
This drawing has been measured to a scale of 1:100, any subsequent enlargements must be checked and verified.  
All services shown in approximate positions.  
© ALL RIGHTS RESERVED.  
North Point indicative only.  
WP Projects COPYRIGHT

<p>Warren Payne MRICS Chartered Building Surveyor e-mail: warren@wpprojects.co.uk mobile: 07818 436 126</p>	<p><b>PROPERTY</b> 7 Brookside Winford BS40 8AB</p>	<p><b>Note</b></p>
	<p><b>DRAWING TITLE</b> As Built Details and Original Lines</p>	
<p>Scale 1:100 @ A3</p>		<p>Drawing No TC-03</p>