



NOTE: THIS DRAWING IS "AS BUILT" BY OTHERS.
WITH AMENDMENTS FOLLOWING TWH MEETING
WITH TDC/ ALRESFORD PARISH COUNCIL.
THIS REPLACES CSA HARD/SOFT LANDSCAPE
DRAWINGS FOR POS AREAS ONLY

ORIGINAL LANDSCAPE PROPOSALS SHOWN ON
CSA DRAWINGS CSA/2047/134-138

SCALE 1:250 (Meters to cm)

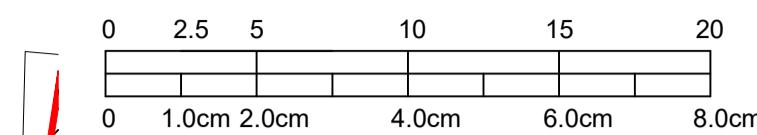

ALLOTMENTS TO BE SET OUT
IN ACCORDANCE WITH
LAYOUT AGREED WITH
ALRESFORD PARISH COUNCIL

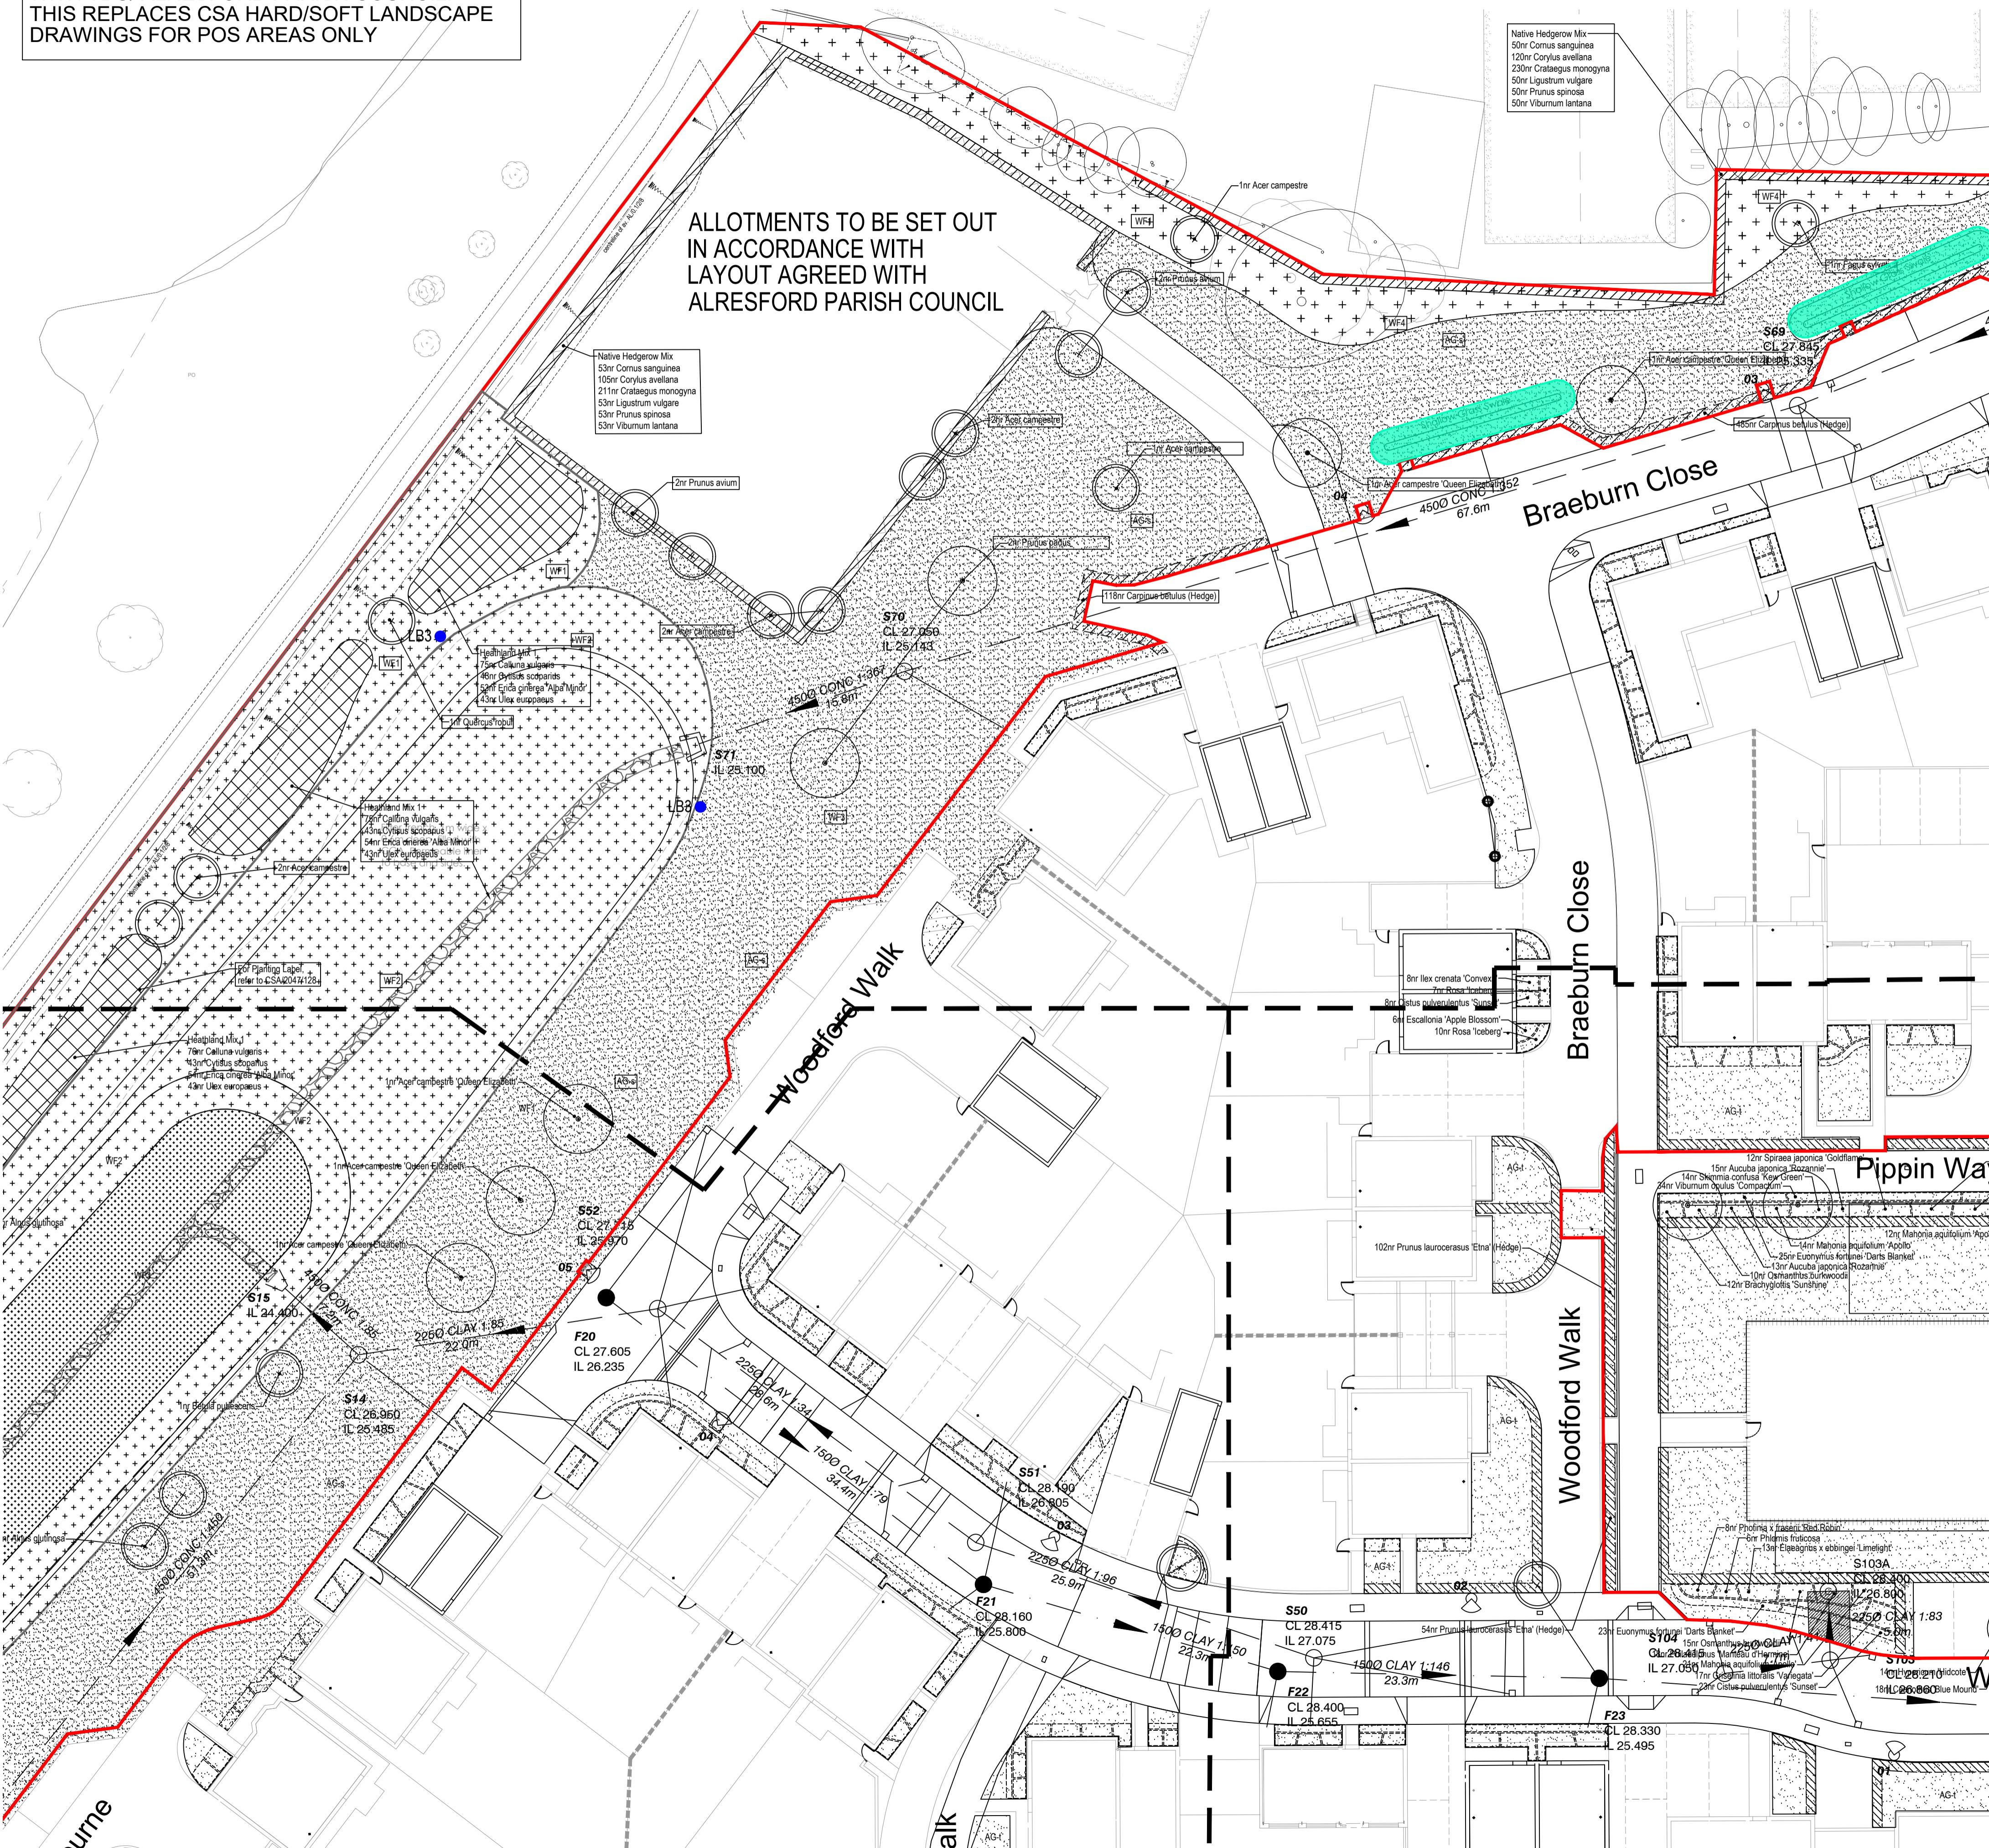

ORIGINAL TREE POSITIONS HAVE BEEN
SET BY PREVIOUS CONSULTANTS AS
BEING SUITABLE FOR LOCATION.
NEW TREE POSITIONS WITHIN POS
HAVE BEEN CHECKED AGAINST
NHBC PN 4.2 (2023) TABLE 5
COLUMN B

NOTE: ALL TREES SET WITHIN 3.0M OF
HIGHWAY BOUNDARY TO HAVE ROOT
BARRIER INSTALLED AT HIGHWAY
BOUNDARY

NOTE: ALL TREES ,HEDGES AND SHRUBS
IN PRIVATE AREAS ARE STILL SHOWN ON
APPROVED DRAWINGS
CSA- 2047-134D-138D

LEGEND

- APPLICATION BOUNDARY
- EXISTING TREES / VEGETATION
- TREES / VEGETATION REMOVED
- Softworks
- WOODLAND MIX
- HEATHLAND MIX
- SEMI-MATURE TREE
- EXTRA HEAVY STANDARD TREE
- STANDARD TREE
- ORNAMENTAL HEDGE PLANTING
- NOTE:
Managed at 1.5m high in POS
- NATIVE HEDGE PLANTING
- NOTE:
Managed at 1.5m high in POS
- ORNAMENTAL SHRUB / HERBACEOUS /
GRASS PLANTING
- CLIMBING SHRUB PLANTING
- AMENITY GRASS SEEDING -
- 'A22 Low Maintenance' seed mix by
Germinal Seeds Ltd or equal and approved.
50g / m², overseed rate; 20g / m²
- AMENITY GRASS TURF -
- 'Medallion' turf by Rolawn or equal and
approved.
- WILDFLOWER MEADOW MIX -
- 'WFG12 Heavy Clay Soil' by Germinal Seeds
Ltd or equal and approved. 5g / m²
- WILDFLOWER MEADOW MIX -
- 'RE12 Drought Land (U16 Grassland)' by
Germinal Seeds Ltd or equal and approved.
5g / m²
- WILDFLOWER MEADOW MIX -
- 'RE3 River Floodplain / Water Meadow (MG8
Grassland)' by Germinal Seeds Ltd or equal
and approved. 5g / m²
- PUBLIC OPEN SPACE BOUNDARY
- B2
- B1
- LB3

Notes:-
1) For Planting Specification refer to 22.5293.05
2) For Planting Schedule refer to 22.5293.02

Andrew Hastings.
Landscape Consultants Ltd.
Chartered Landscape Architects.
The Fairways, 9 Fairways,
Great Bromley, Hare Green,
Essex, CM1 7UF
Tel: 0126 25233.
E Mail: ah@andrewhastingslandscapeconsultants.co.uk
Web: www.andrewhastingslandscapeconsultants.co.uk

Landscape Institute
Registered practice

PLANNING

TAYLOR WIMPEY.

**COCKAINES LANE,
ALRESFORD.
ESSEX.**

**LANDSCAPE INSPECTION 09.07.22
(SHEET 3 of 6)**

SCALE	DATE	DRAWN	CHECKED	DRAWING NUMBER
1:250 @ A1	01.09.22	OB	AH	22.5293.12

All dimensions are to be taken from this drawing
All written dimensions to be checked by the contractor
discrepancies notified immediately to this consultant