

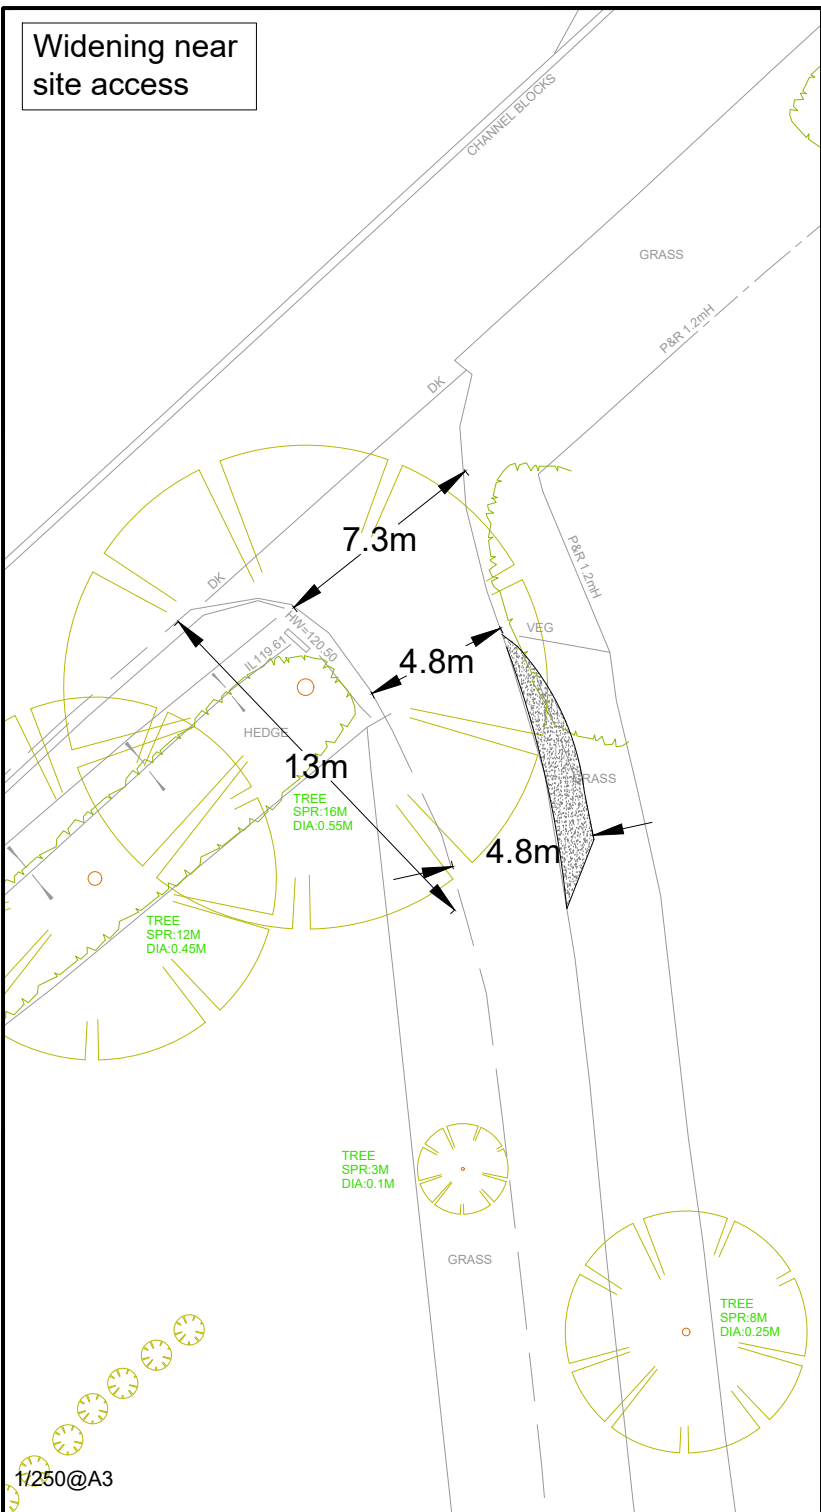


Widening near site access

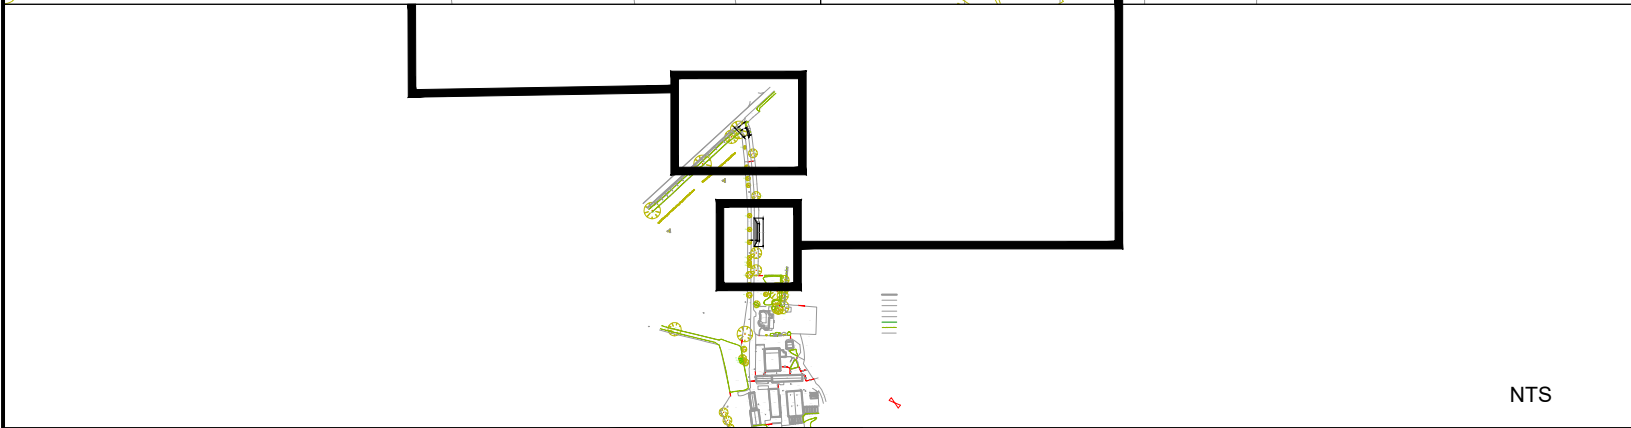

Passing Bay

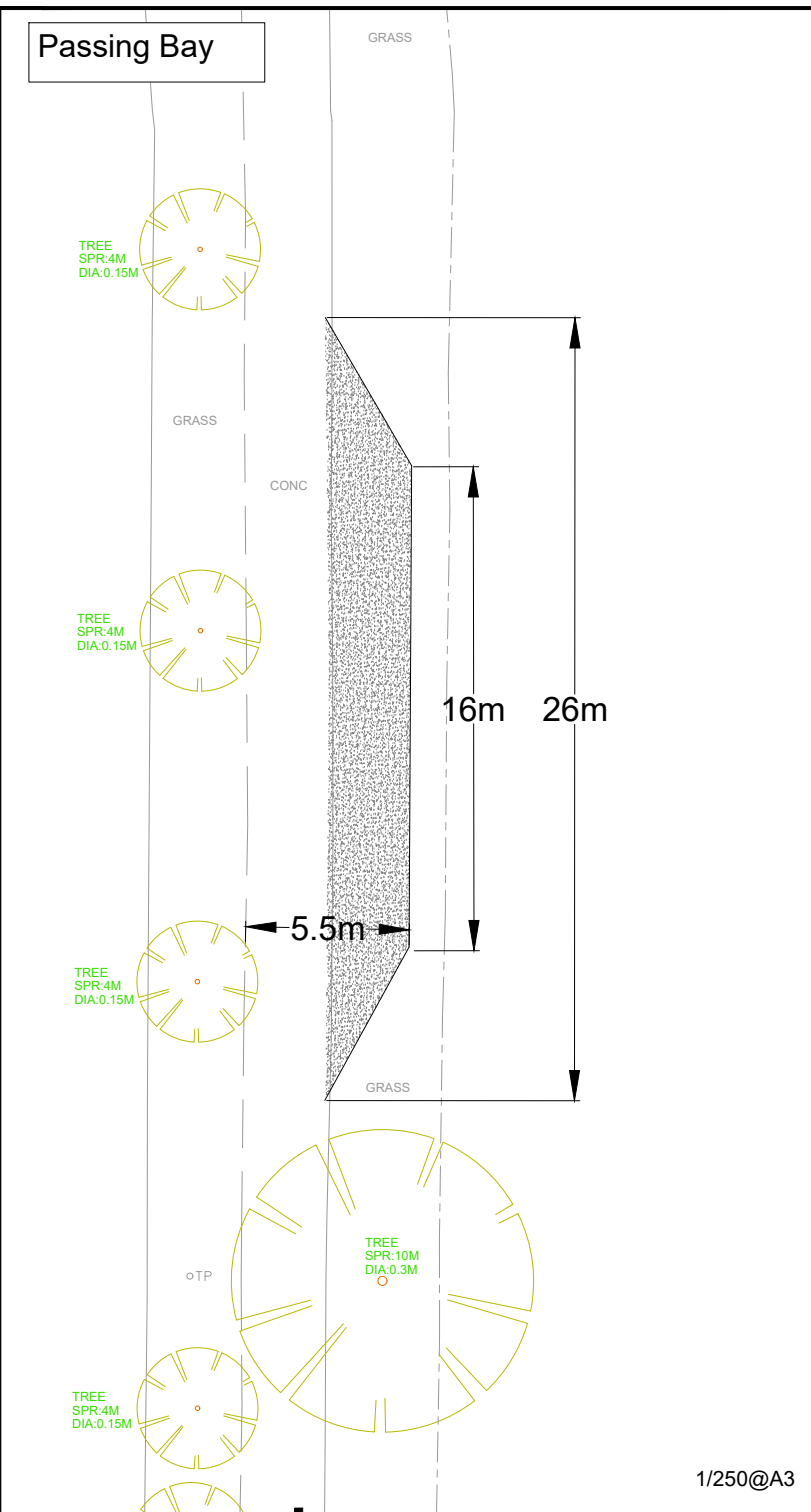

NTS



Recently completed widening works (in general accordance with drawing 23529-02). Construction included Type 6F2 base and tarmac planings.

(all land under the control of the applicant outside of the public highway)



Recently completed passing bay (in accordance with drawing 23529-02). Construction included Type 6F2 base and tarmac planings. To level the passing bays the base was built up to match the existing driveway height and the sides were battered with top soil.

Based upon the ORDNANCE SURVEY MAPS with the permission of THE CONTROLLER OF HER MAJESTY'S STATIONERY OFFICE © Crown Copyright AL 100030412 © David Tucker Associates

REV	DESCRIPTION	DRAWN	INITIALS	DATE

JOB TITLE Mount Pleasant Farm, Stewkley		CLIENT Webb Developments	
DRAWING TITLE Access Track Improvements			
Completed Works			
SCALE See Plan	DRAWN BY DN	DATE Aug 23	DRAWING No 23529-05
			REVISION A