

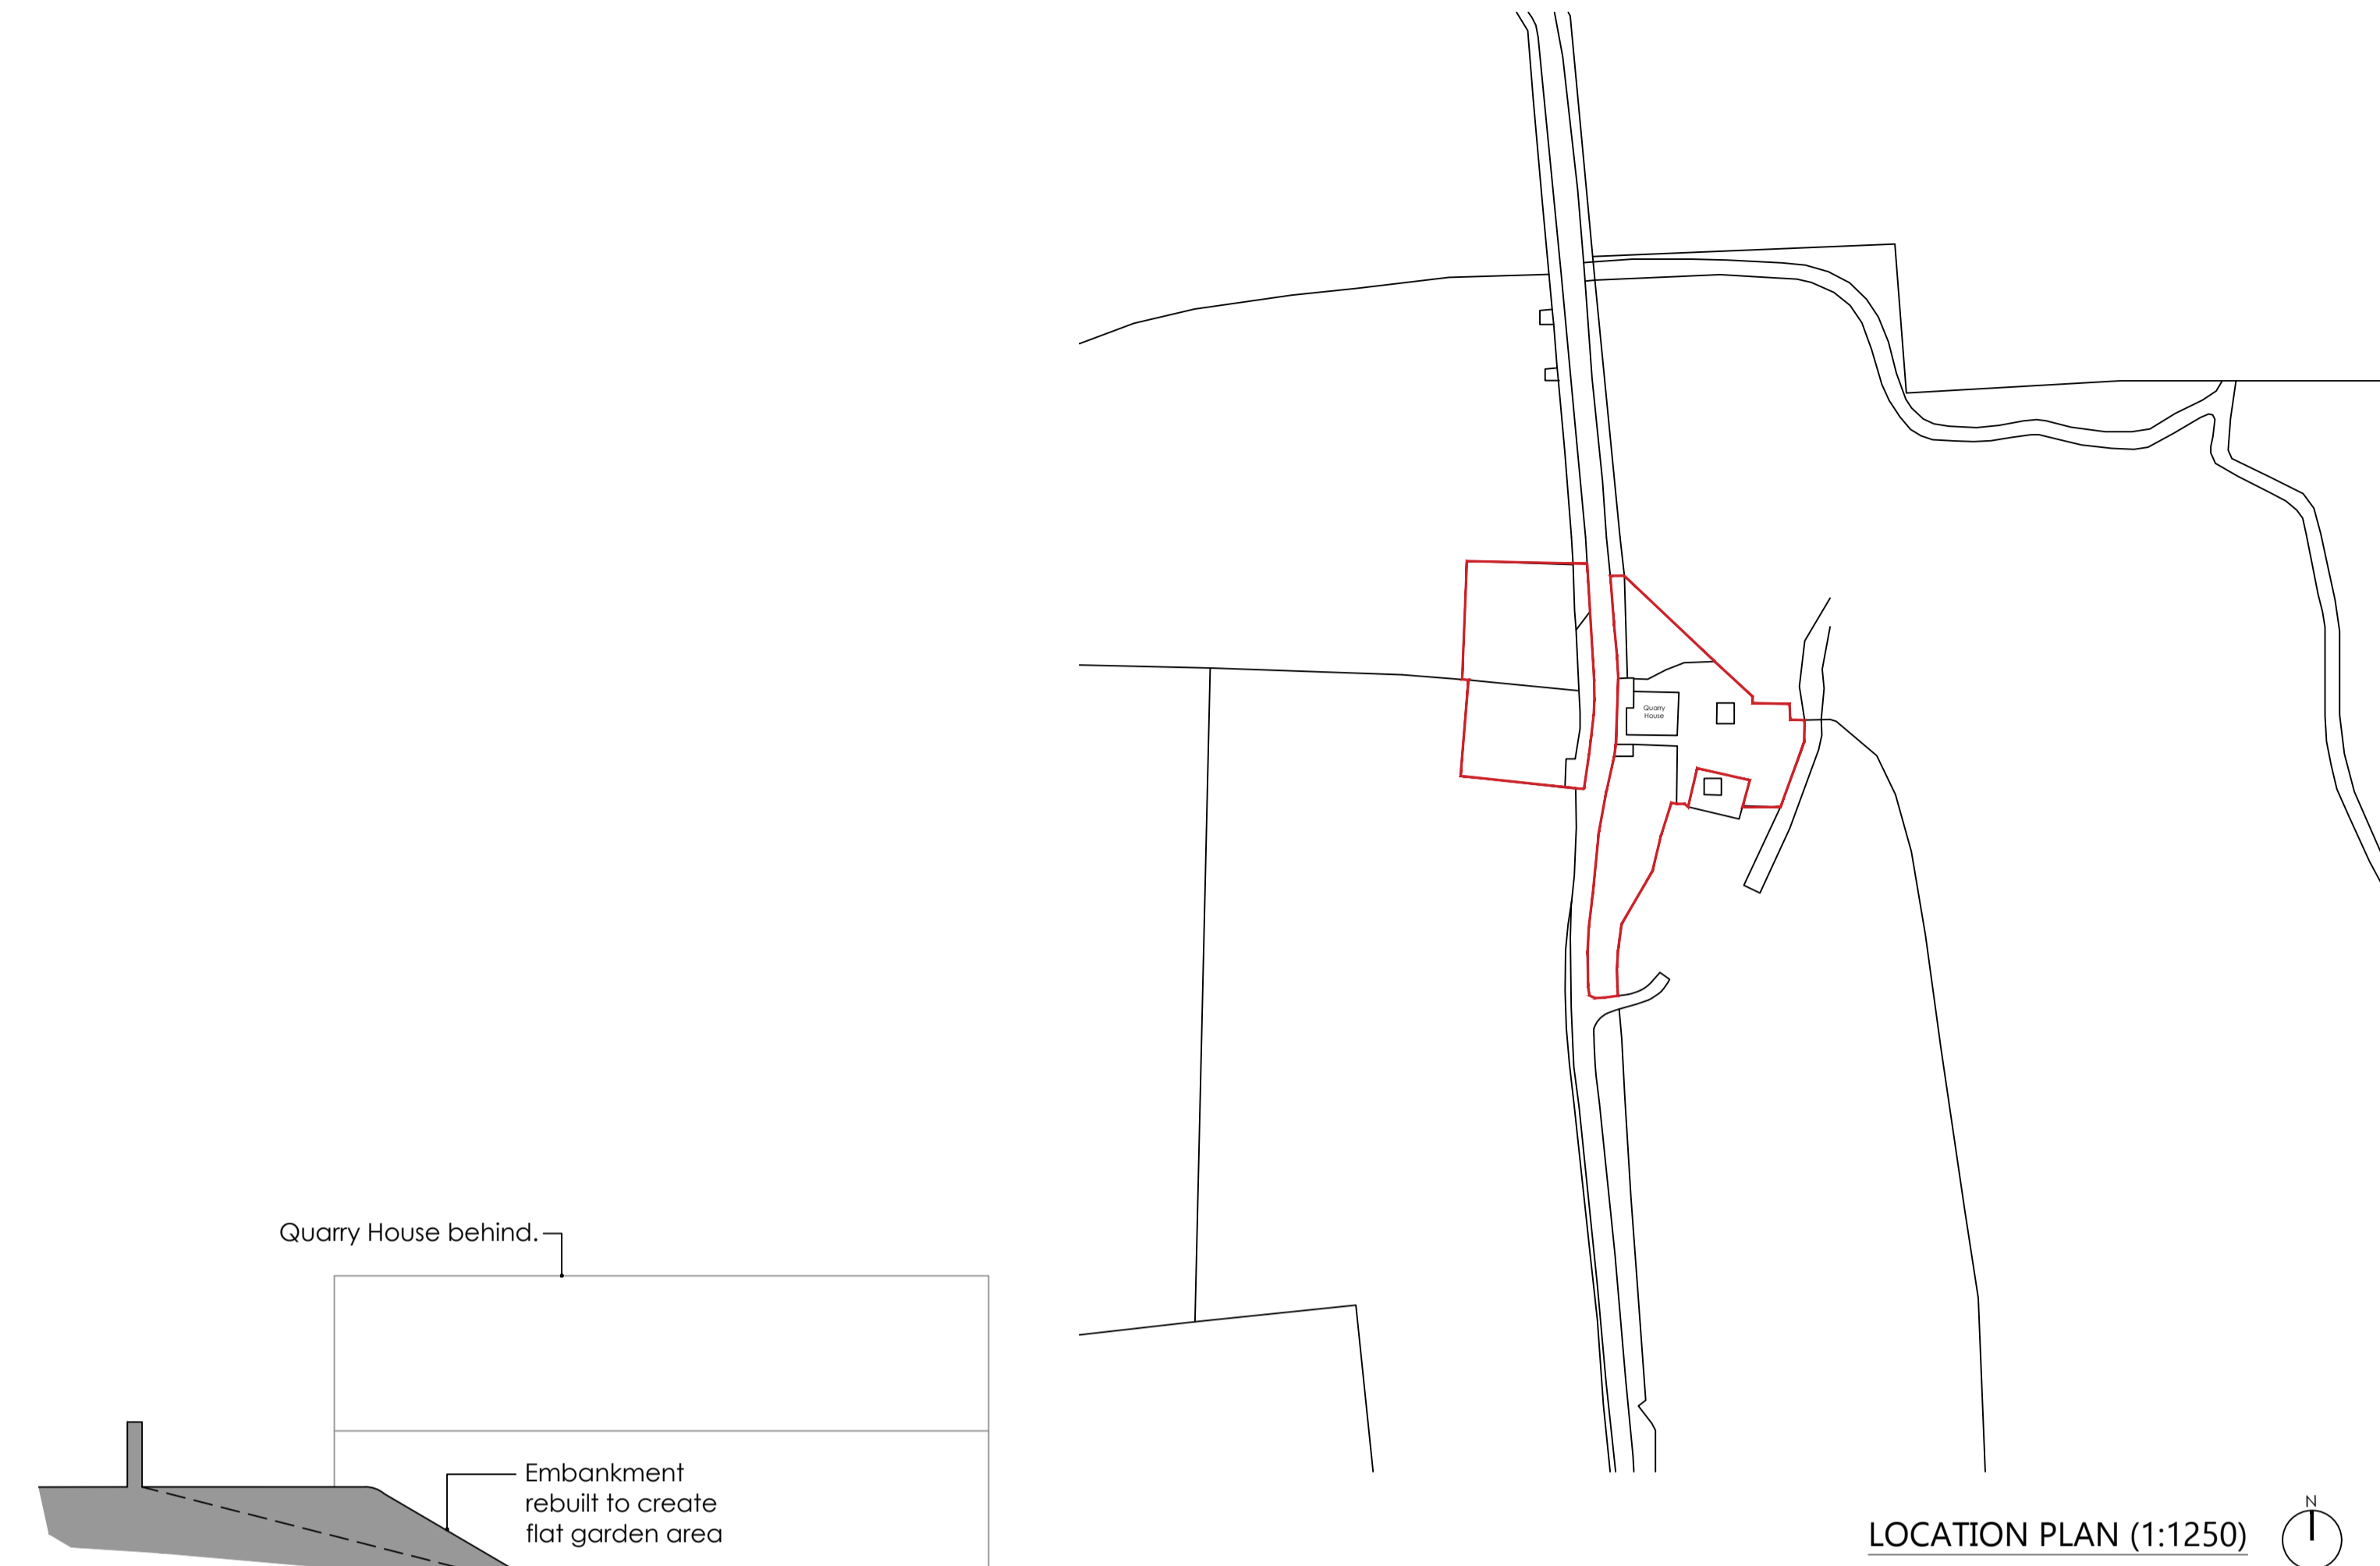



SITE PLAN AS BUILT (1:200 @ A1)

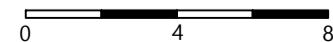


Section C-C

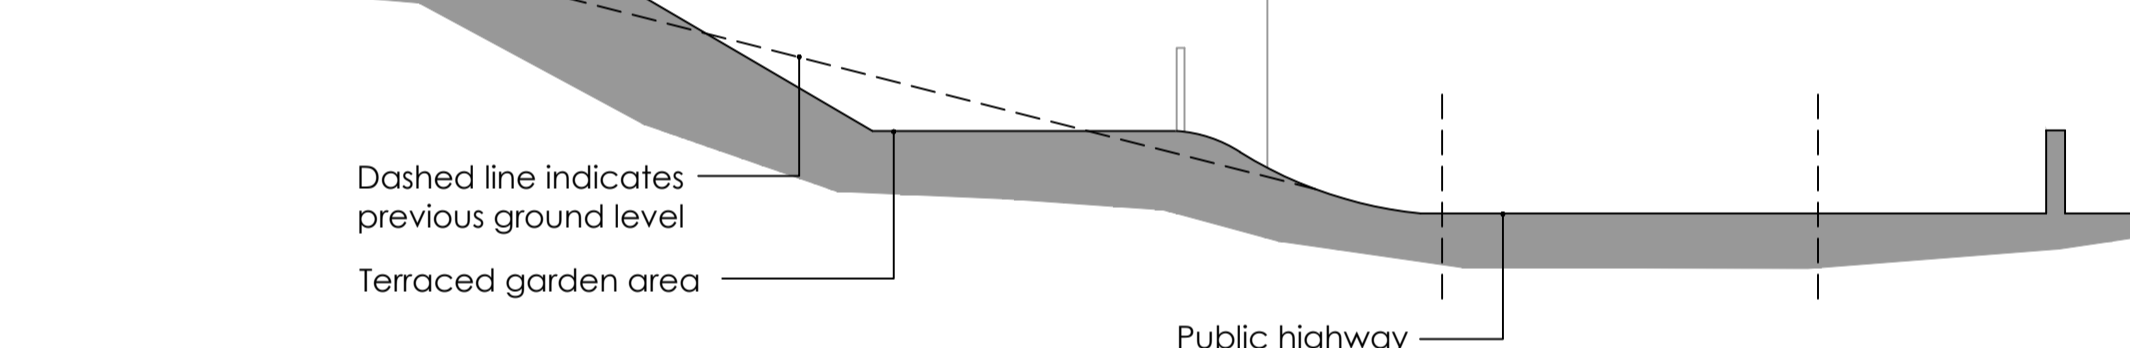


Section B-B

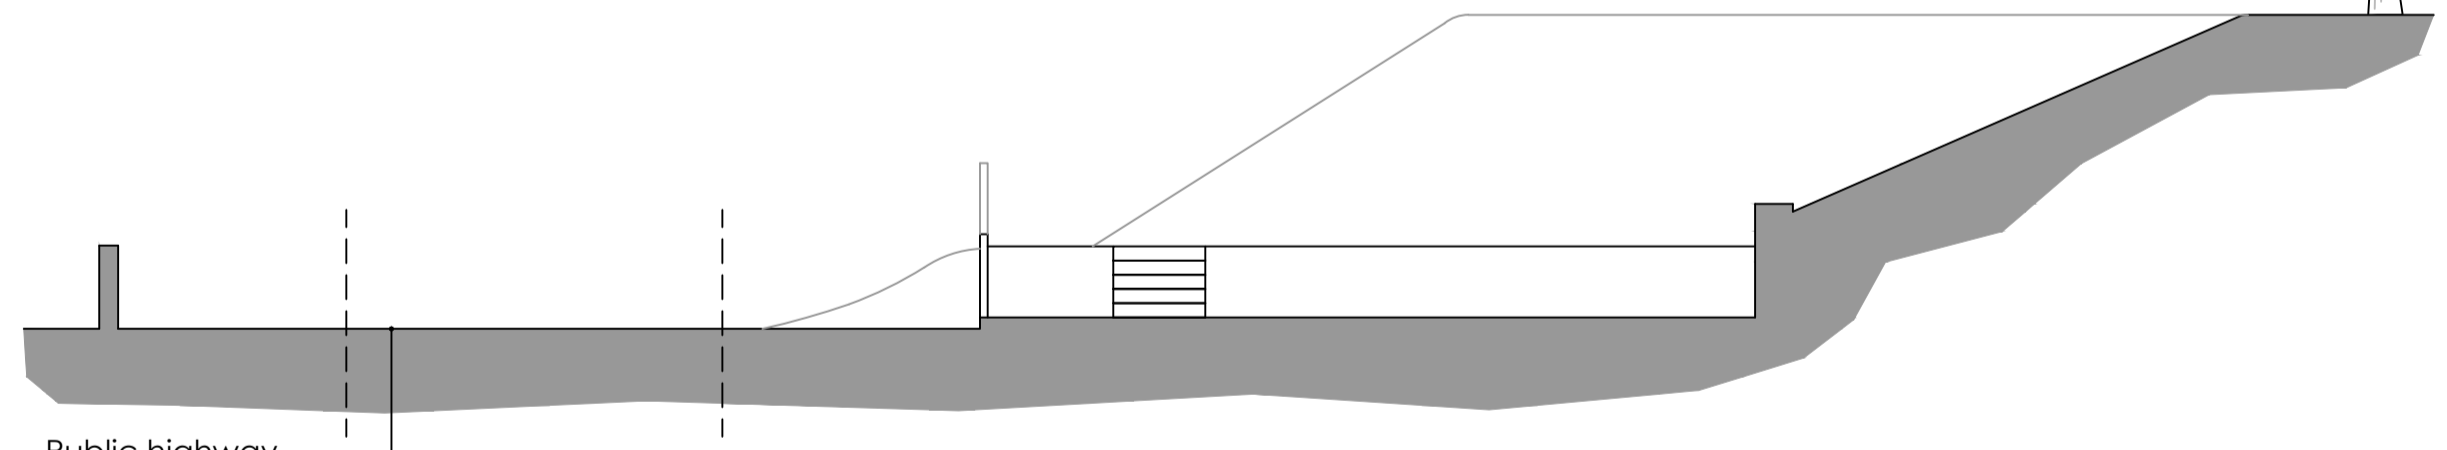

Section A-A

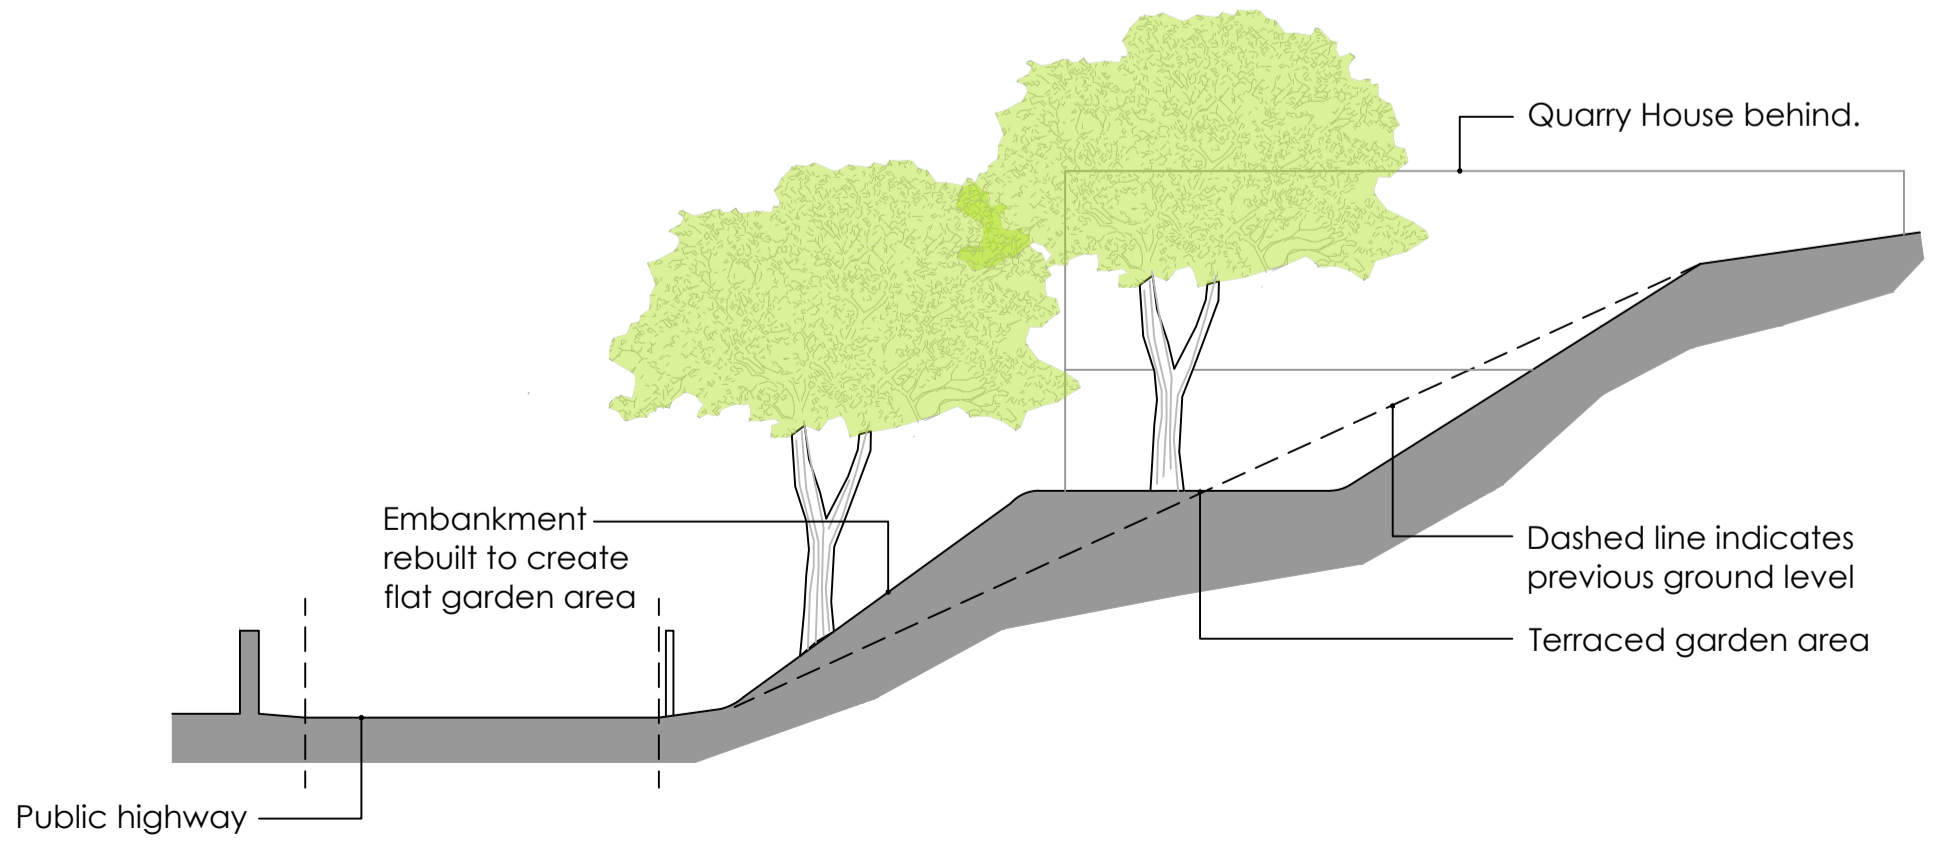

SITE SECTIONS AS BUILT (1:100 @ A1)

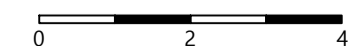

REV	DATE	BY	AMENDMENTS
Ascent Design + Architecture m. 07402664505 e. info@ascentdesign.uk			
DATE:	SCALE:	DRAWN BY:	
AUG 2023	AS INDICATED	OPR	
DWG TITLE:			
AS BUILT SITE PLAN AND SECTIONS			
PROJECT:			
QUARRY HOUSE			
DWG No.	A010		Rev. P1