


Approved West Elevation

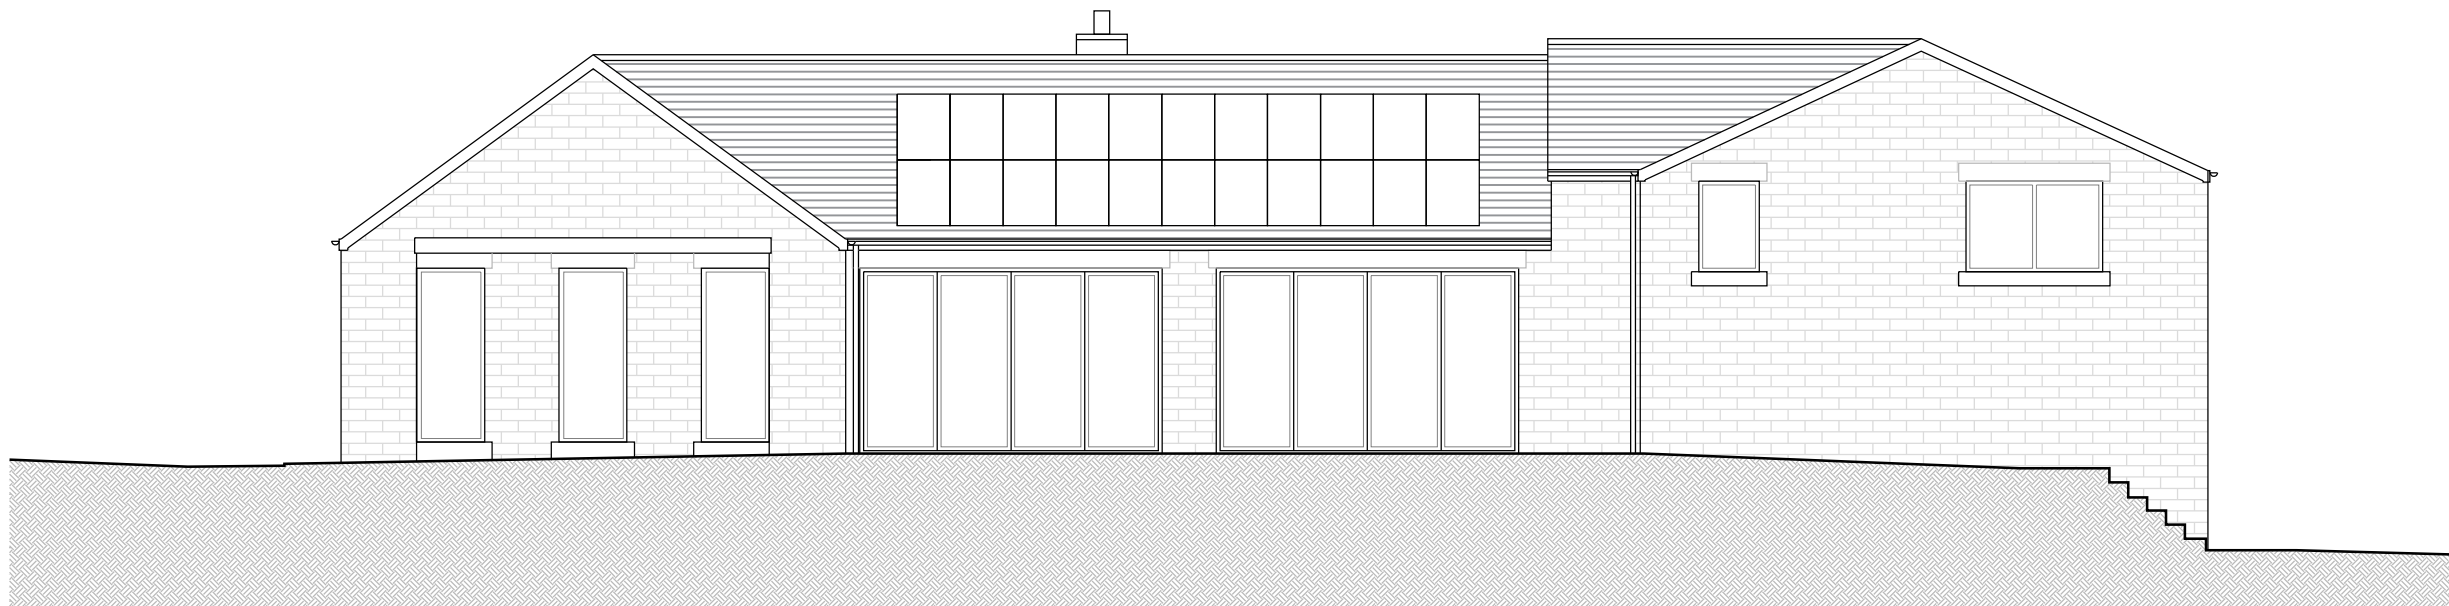

As-built West Elevation

Copyright Notice:  
This drawing is the copyright of Design Studio - North LLP (Architects) and shall not be reproduced without permission. © 2023

General Notes

No.	Revision / Issue	Date

**ds-n**  
DESIGN STUDIO NORTH  
ARCHITECTS

17-19 Stott Hill Cathedral Quarter Bradford BD1 4EH  
Tel : (01274) 727745 - Fax : (01274) 726817  
Email : mail@ds-n.co.uk

Issue purpose

**Planning**

Client  
**Mr M. Heneghan**

Project  
**New Residential Property  
Bay Horse Lane  
Scarcroft, Leeds  
LS17 9JN**

Dwg. Title  
**Proposed West Elevations  
Comparison**

Dwg. No. **432-002-1035** Rev.

Scale **1:100 @ A3** Date **September 2023**  
Drawn by **GSB** Checked **DKW**