

Drawings By :
Kristian Ndreu
 Contact :
 mob: +44 77 32641492
 email: kristi_ndreu@gmail.com

For :
Clinical Eye Service Ltd
Headcorn Eye Centre

Project Title:
25 High Street,
Headcorn

Revisions

No		Date


General Notes

Drawing Title:
Rear & AC Unit Elevations

Drawing Loc:

Date: 12.10.2023 Page Size: A3

Scale: 1:50 / 1:20 Page nr:

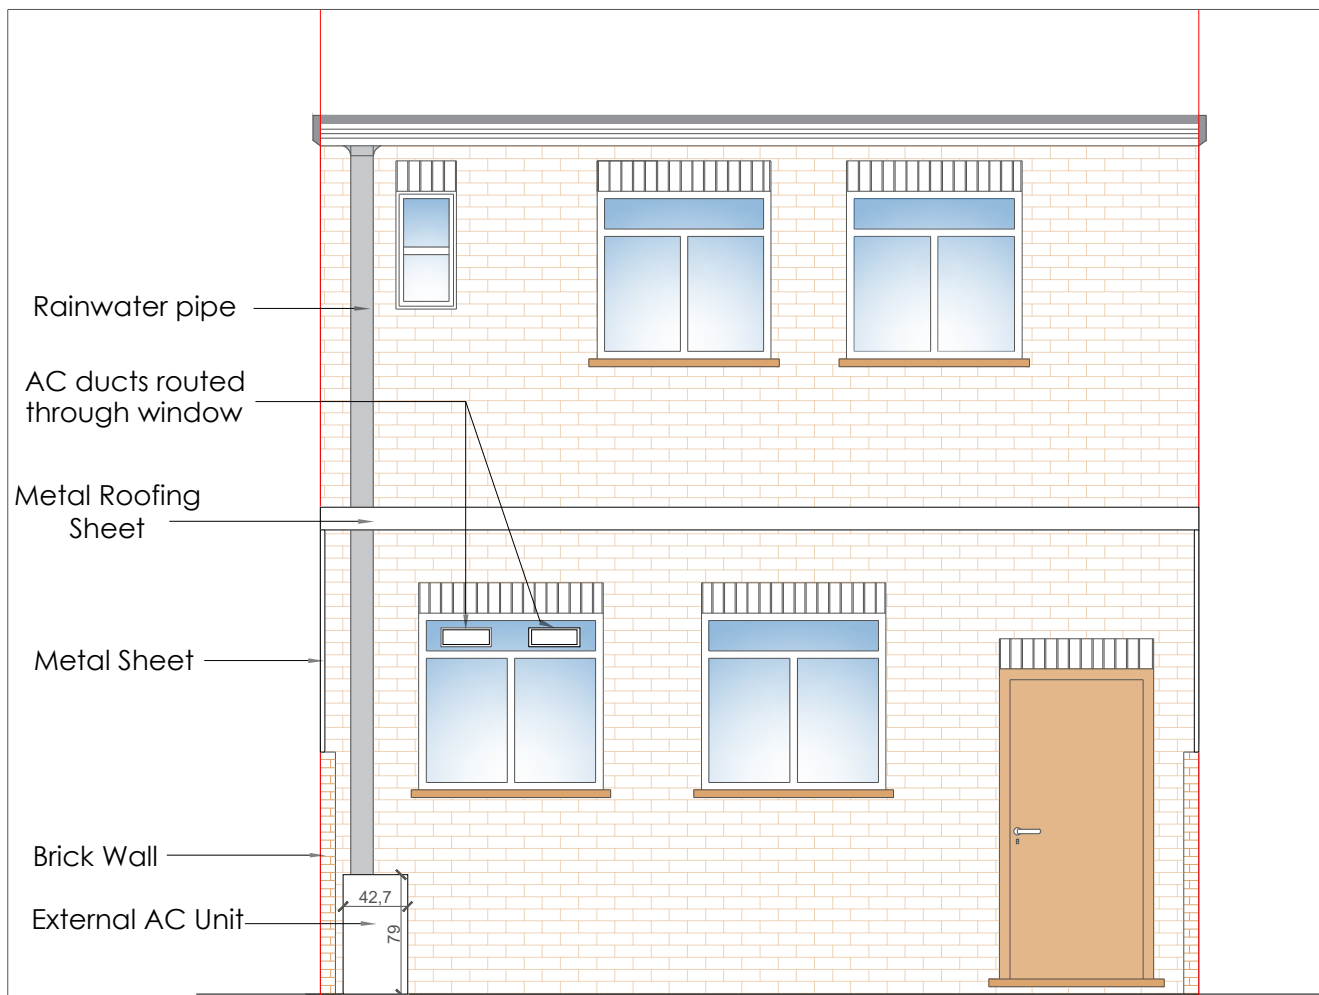

REAR ELEVATION 01
(From within storage area)_
As-Built / 1:50



REAR ELEVATION 02_As-Built
1:50



AC Unit Elevations / 1:20

