





EXISTING GROUND FLOOR

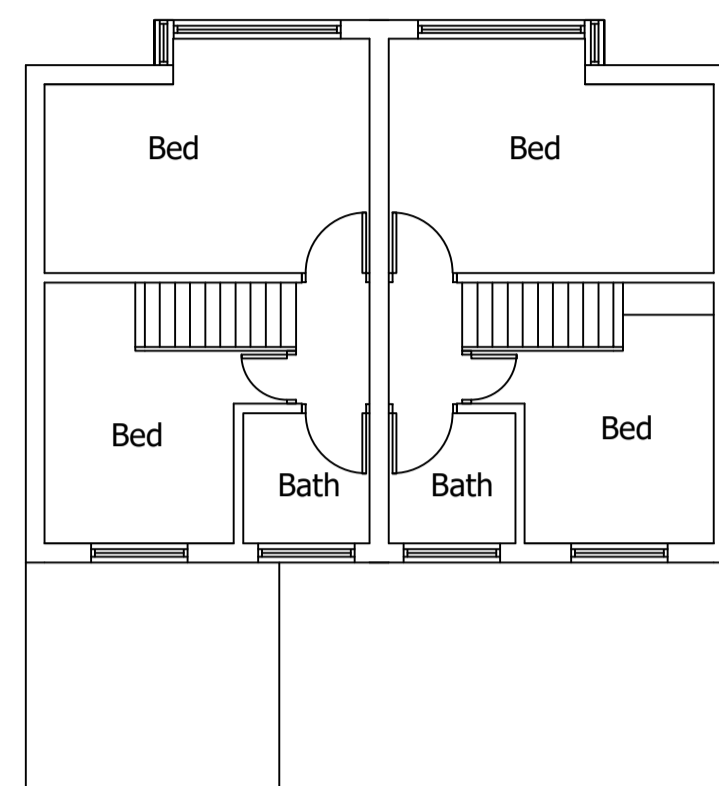

EXISTING FIRST FLOOR

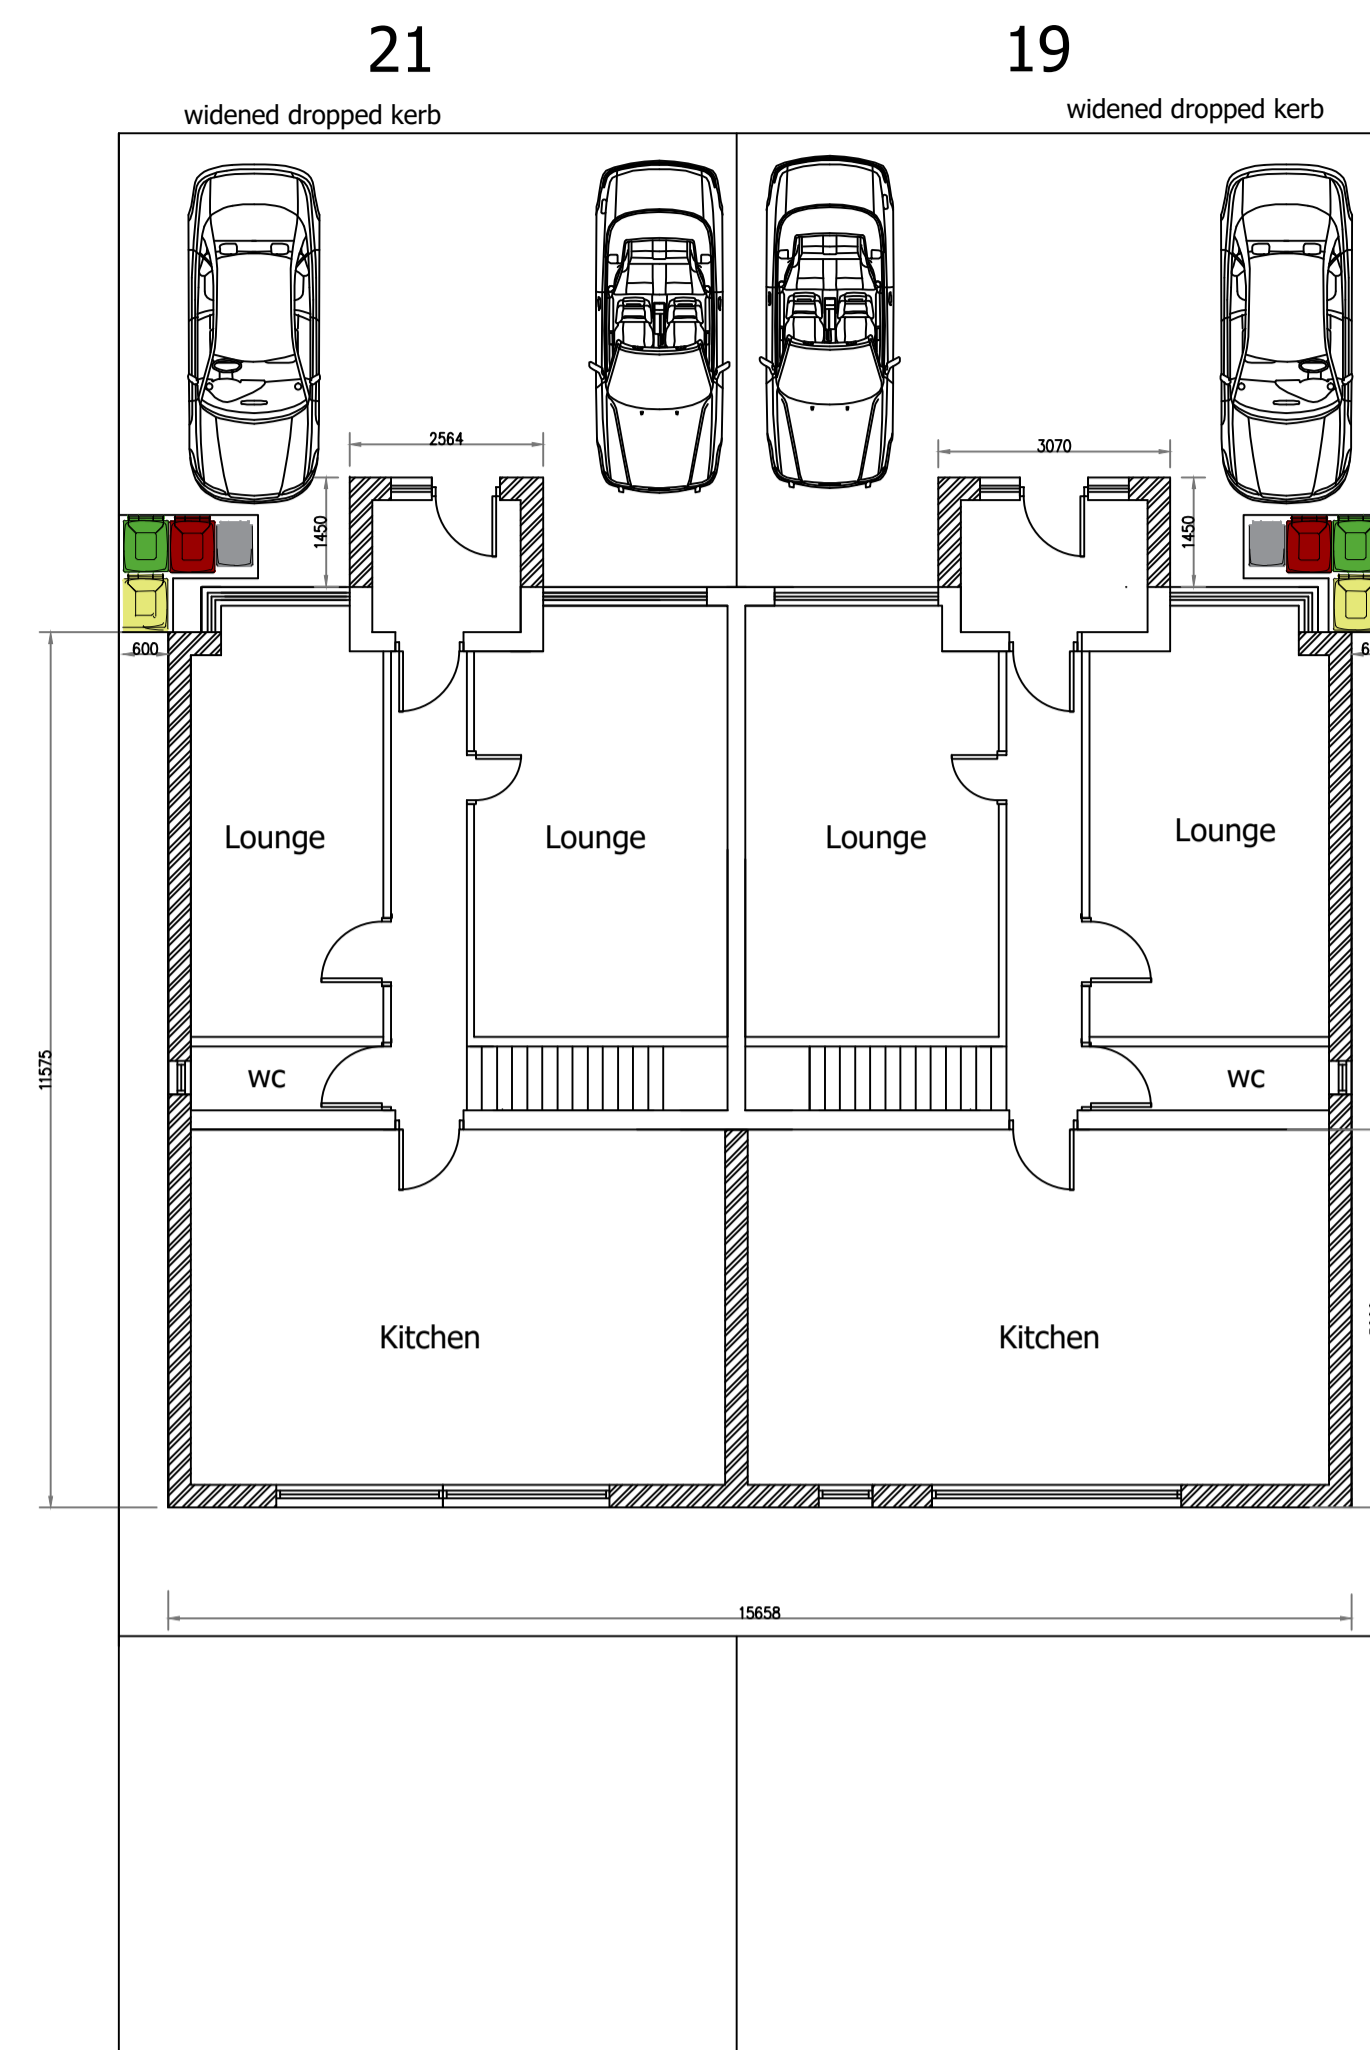

PROPOSED GROUND FLOOR

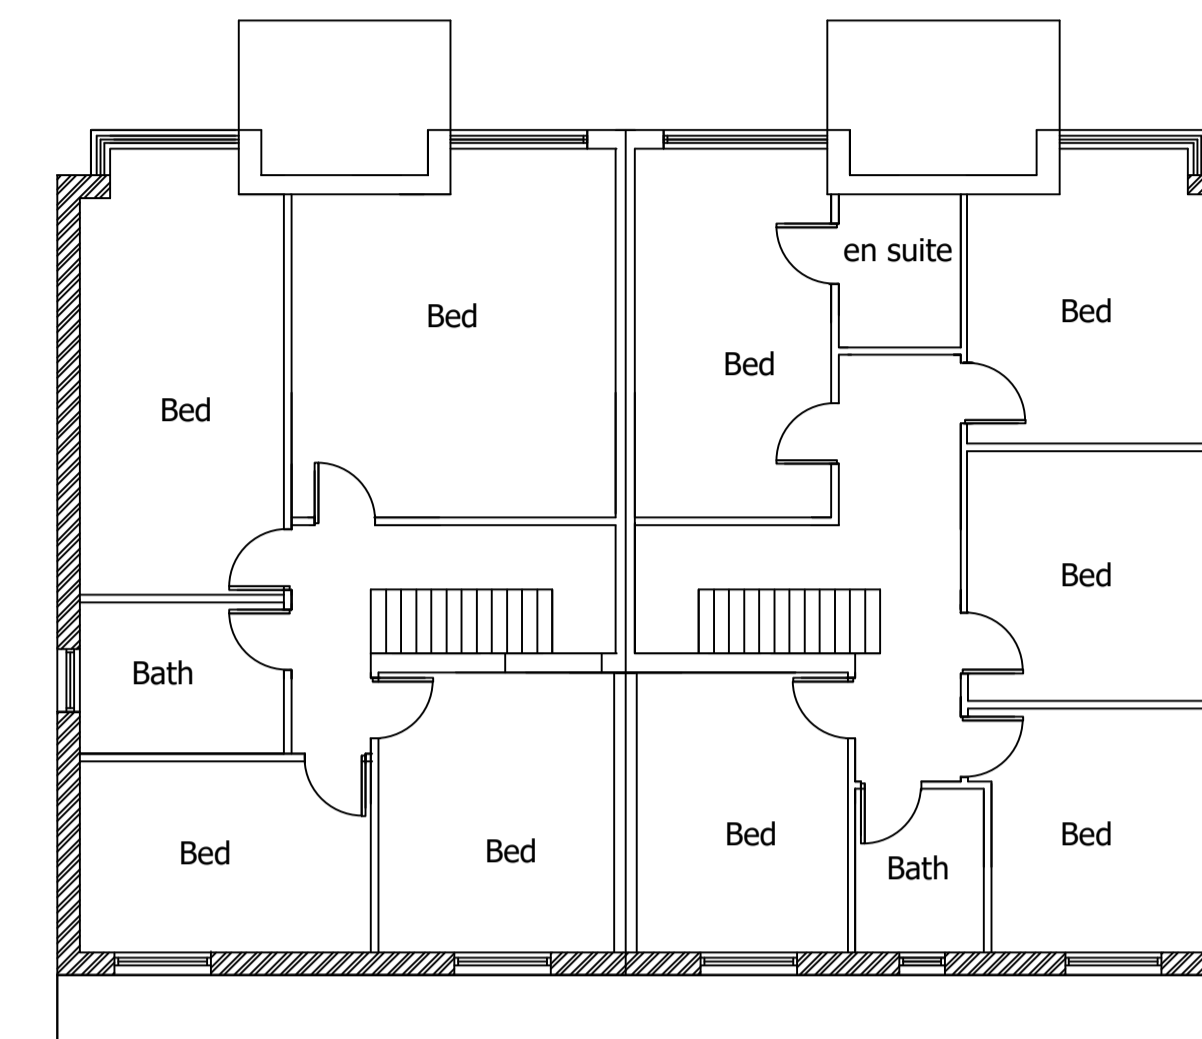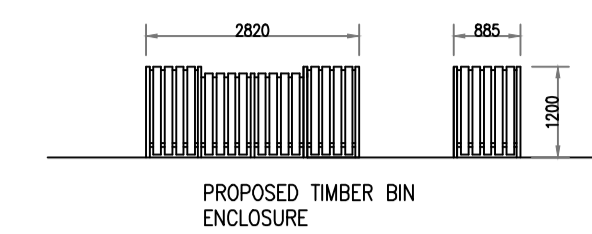

PROPOSED FIRST FLOOR



EXISTING FRONT ELEVATION



EXISTING SIDE (1) ELEVATION




EXISTING SIDE (2) ELEVATION




EXISTING REAR ELEVATION



PROPOSED FRONT ELEVATION

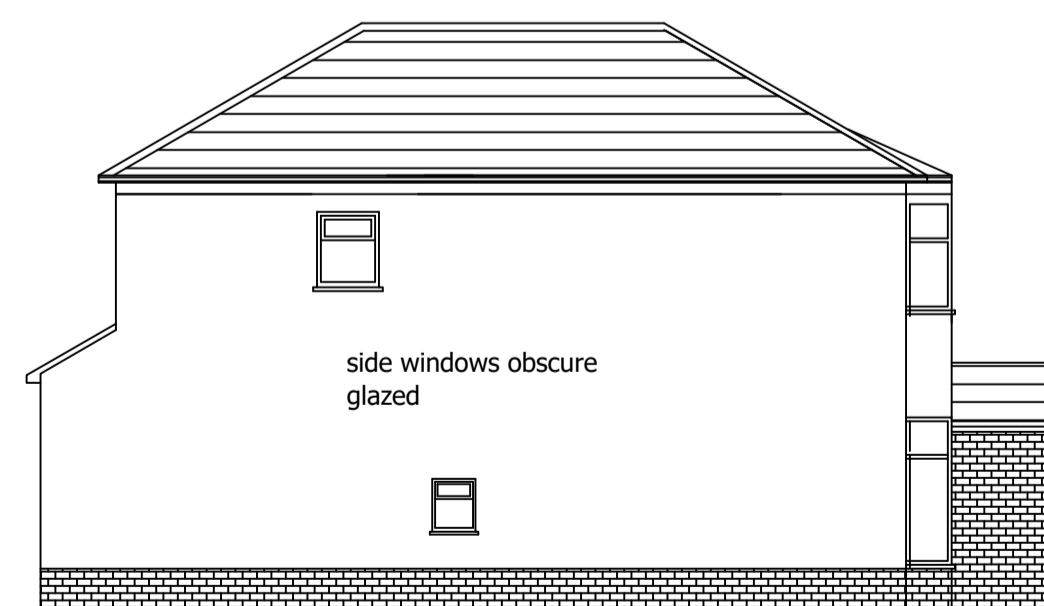

PROPOSED SIDE (1) ELEVATION

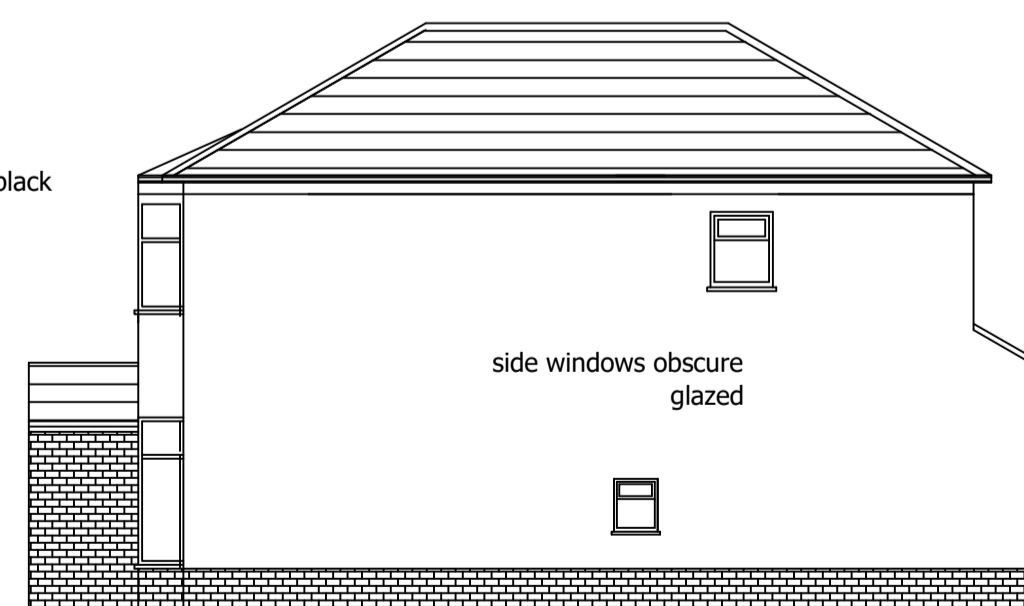

PROPOSED SIDE (2) ELEVATION



PROPOSED REAR ELEVATION

Date	Rev.	Description	Initials
22/1/23	A.	Reduced proposal	RA
17/2/23	B.	Amended plans	RA
26/10/23	C.	As built plans	RA

This drawing is subject to copyright and is not to be reproduced in part or whole without approval.
 Figured dimensions take precedence over scaled measurements from the drawing. All dimensions to be checked by Contractor and discrepancies clarified with the Client prior to commencement.
 The whole of the works to comply with current Building Regulations. No work to commence without Building Regulations approval.
 The client must ensure the project complies with the Construction Design and Management Regulations 2015

Notes

RAD

The White House,
 42-44 Chorley New Road,
 Bolton
 BL1 4AP

Tel : 01204 322196
 Fax : 01204 214110
 Mob: 07790 361104
 Email: info@radesignprojects.co.uk

Project
 19/21 WINIFRED ROAD
 FARNWORTH
 BOLTON
 BL4 0HH

Title
 EXISTING & PROPOSED PLANS

Client
 FARUKH IQBAL

Drawn
 RA

Date
 JULY 2022

Scale
 1:100 @ A1

Drawing Number
 RAD/2685/22/1/RevC