



As Built Ground Floor Plan

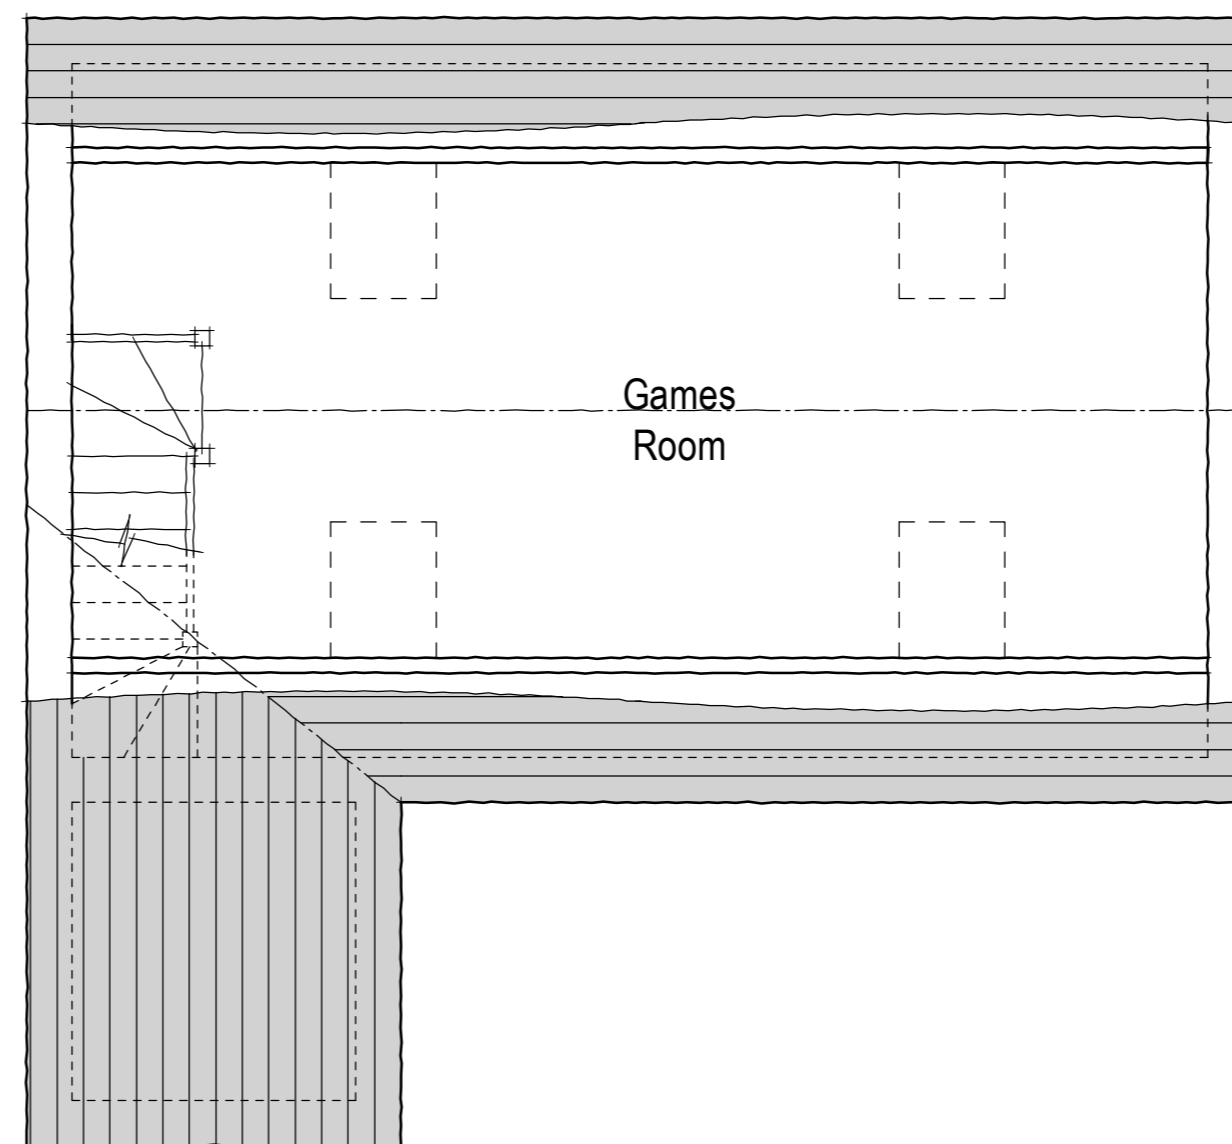

As Built Roof Space Plan

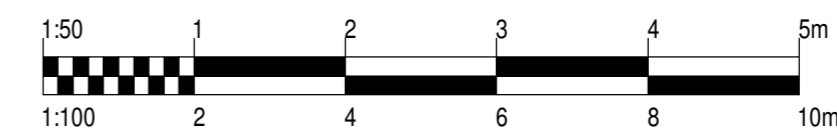

REV.	DATE	DESCRIPTION	BY
<p>GD Designs Architectural Services</p> <p>49, The Crescent, Cradley Heath, West Midlands. B64 7JS Tel: [REDACTED] Mob: [REDACTED]</p> <p>contract DETACHED ANCILLARY BUILDING 41, WARWICK ROAD, OLDBURY. B68 ONE</p> <p>drawing AS BUILT PLANS & ELEVATIONS</p> <p>client [REDACTED]</p> <p>scale date drawn by 1:50/1:100@A2 JULY 2023 GCD</p> <p>drawing no rev plot cad lines GD2538/03 1 T:\43716 D & T E 14/07/2023</p>			