

Lightbox Architects

1 Kings Meadow
 Osney Mead
 Oxford
 OX2 0DP
 t 07901 521084
 lightboxarchitects.com




title
 alterations and additions to
 44 Charlbury Road
 Oxford
 OX2 6UX
 for Mrs Huaying Ding and Mr Hu Wang

drawing
 existing loft and roof plan


drawing number
CHA 012

scale at A3 1:100 date October 2020 drawn by jmac

RECORD DRAWING

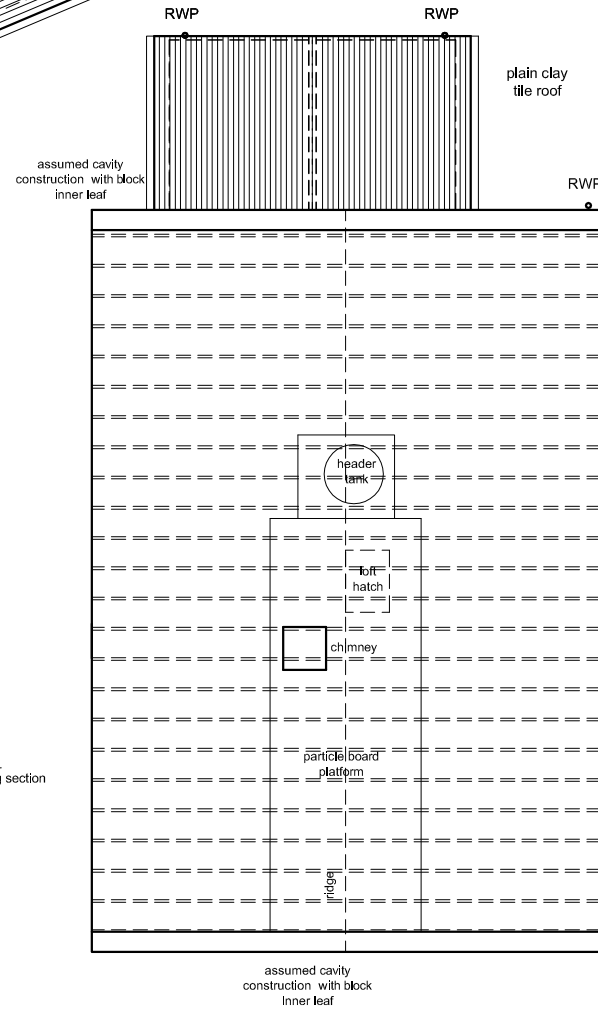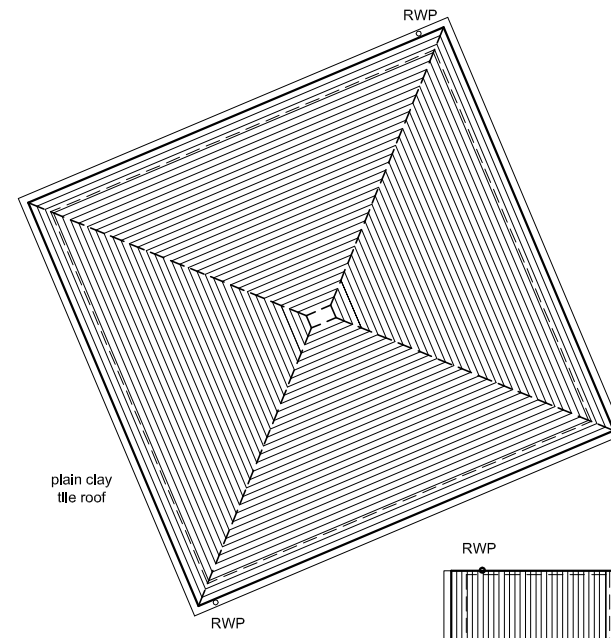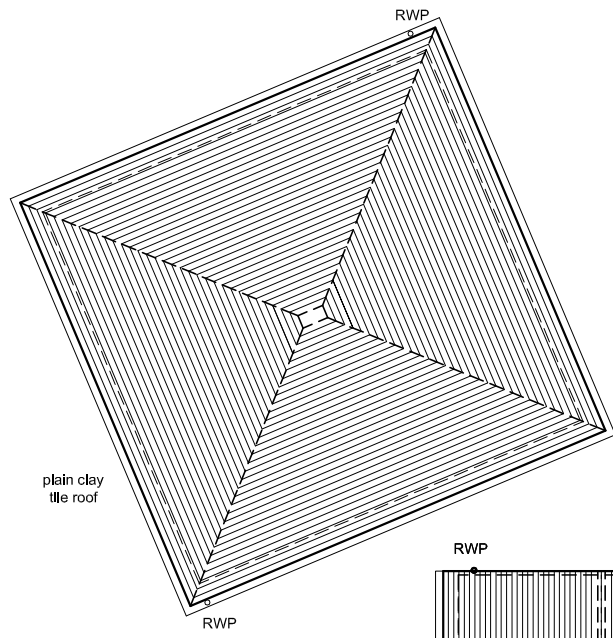

loft floor plan

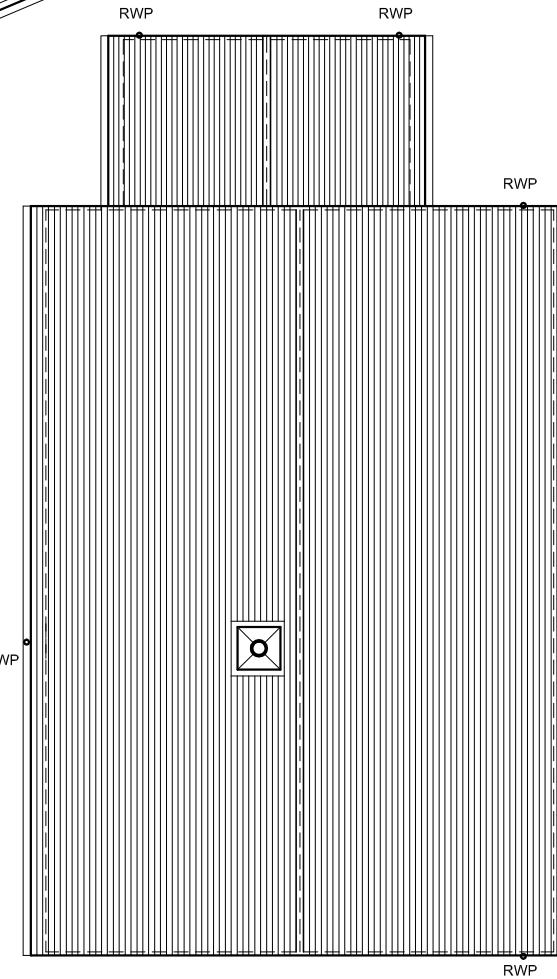

roof plan

existing section

roof trusses at 400mm centres

existing section

existing section

existing section

