

Lightbox Architects

1 Kings Meadow
Osney Mead
Oxford
OX2 0DP
t 07901 521084
lightboxarchitects.com


title
alterations and additions to
44 Charlbury Road
Oxford
OX2 6UX
for Mrs Huaying Ding and Mr Hu Wang

drawing
existing ground floor plan

drawing number
CHA 010

scale at A3 1:100 date October 2020 drawn by jmac

RECORD DRAWING

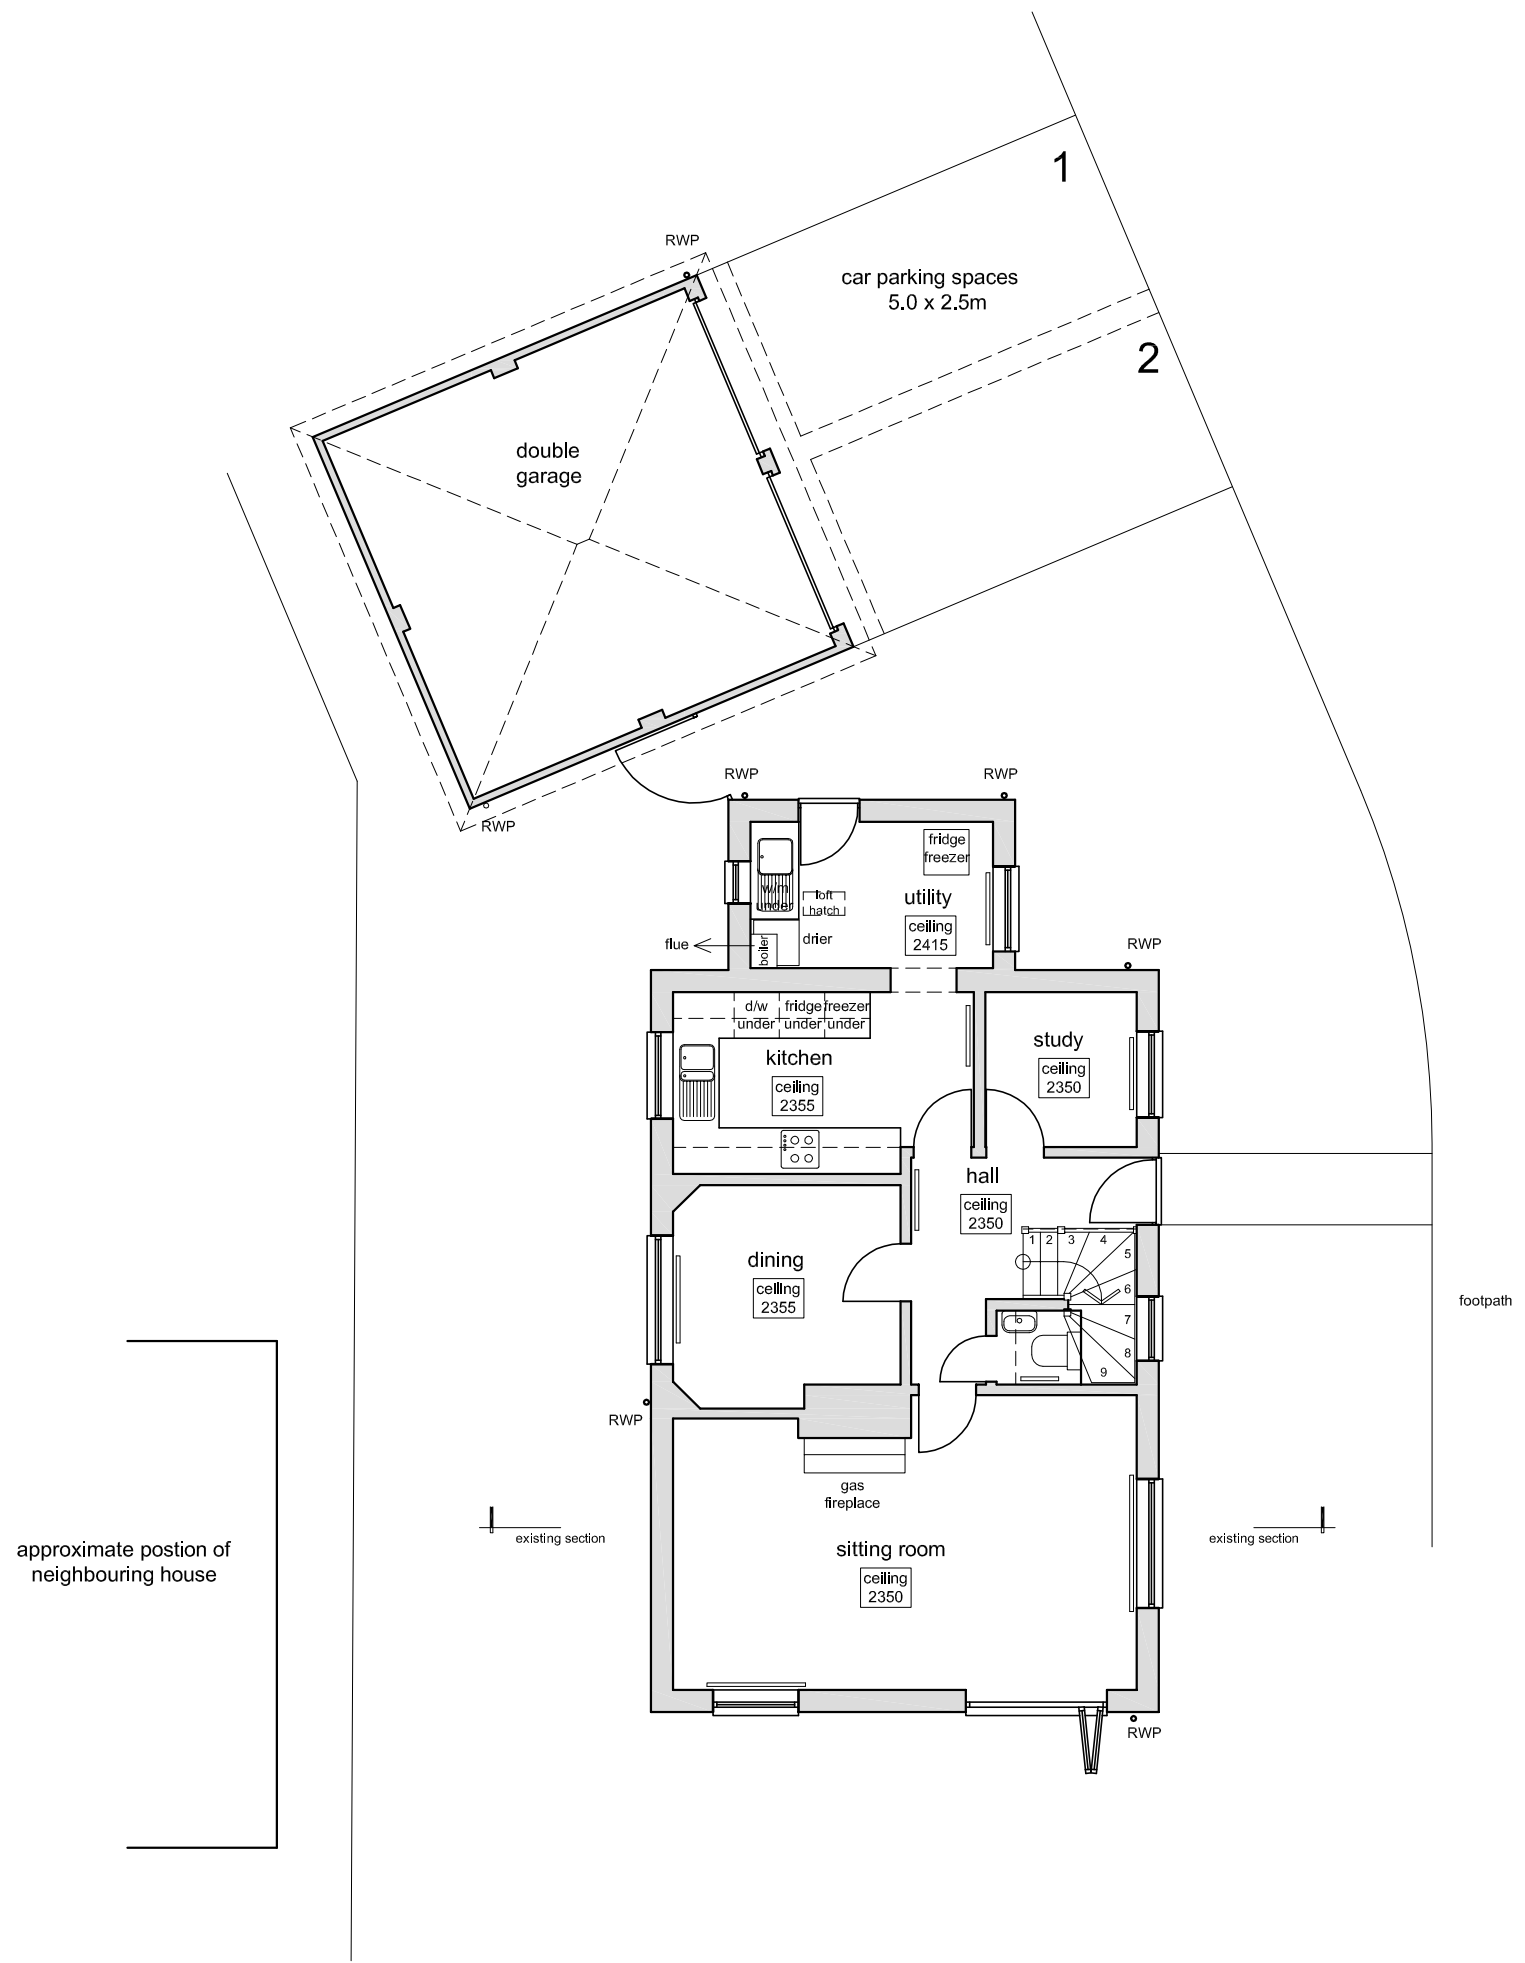

ground floor plan

