



south (side) elevation

# Lightbox Architects

1 Kings Meadow  
Osney Mead  
Oxford  
OX2 0DP  
t 07901 521084  
lightboxarchitects.com

title  
alterations and additions to  
44 Charlbury Road  
Oxford  
OX2 6UX  
for Mrs Huaying Ding and Mr Hu Wang

drawing  
existing side (north and south) elevations  
and existing section

drawing number  
**CHA 016B**

scale at A3 1:100      date October 2020      drawn by jmac


## RECORD DRAWING

Revisions  
A  
garage added to North elevation, dwg title amended.  
jmac


B  
north elevation with garage omitted for clarity added  
jmac 12.10.23



north (side) elevation with garage

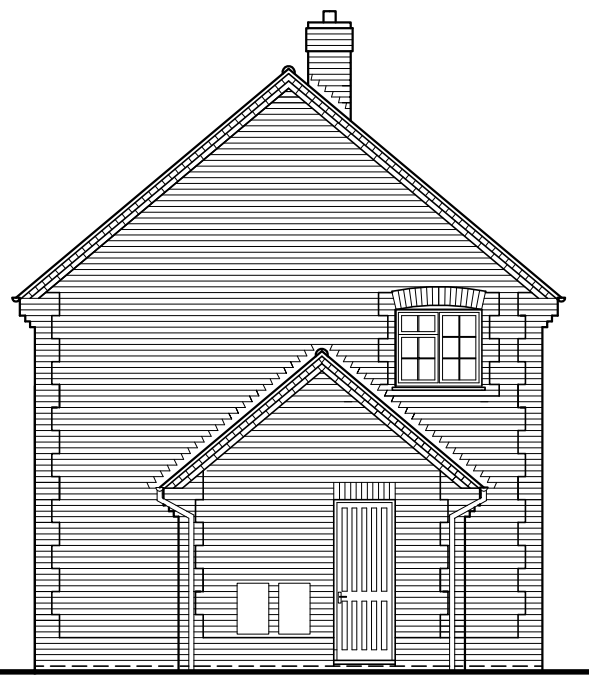

north (side) elevation with garage  
omitted for clarity

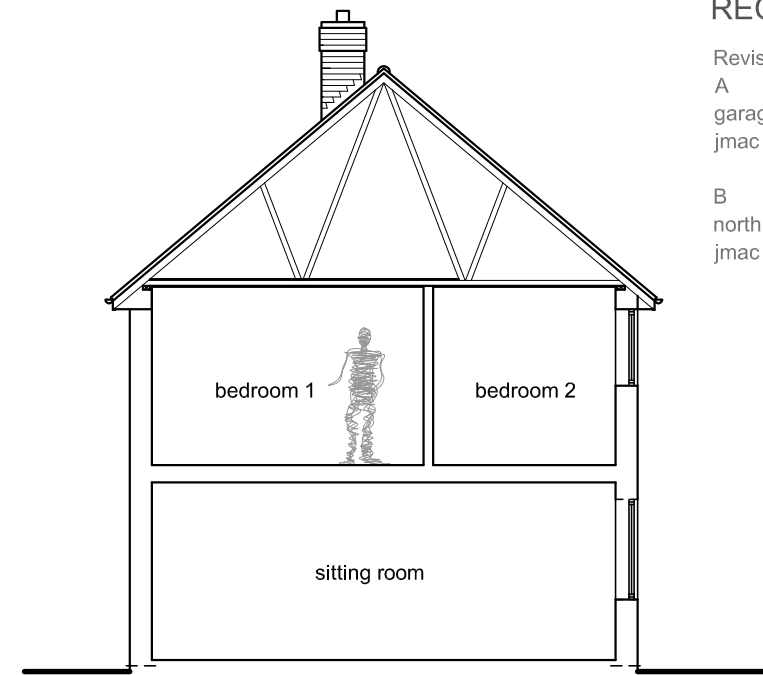

existing section

