





PRE-EXISTING FRONT ELEVATION




AS BUILT FRONT ELEVATION

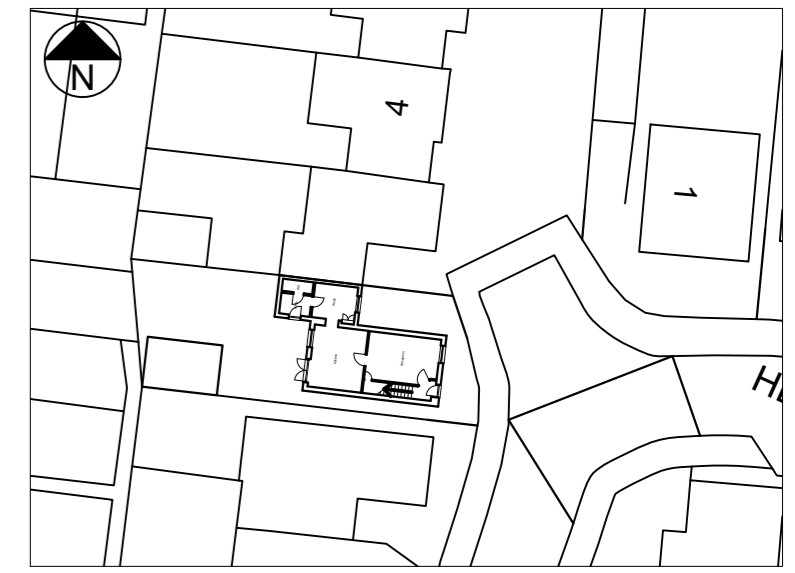


BLOCK PLAN (1:500)

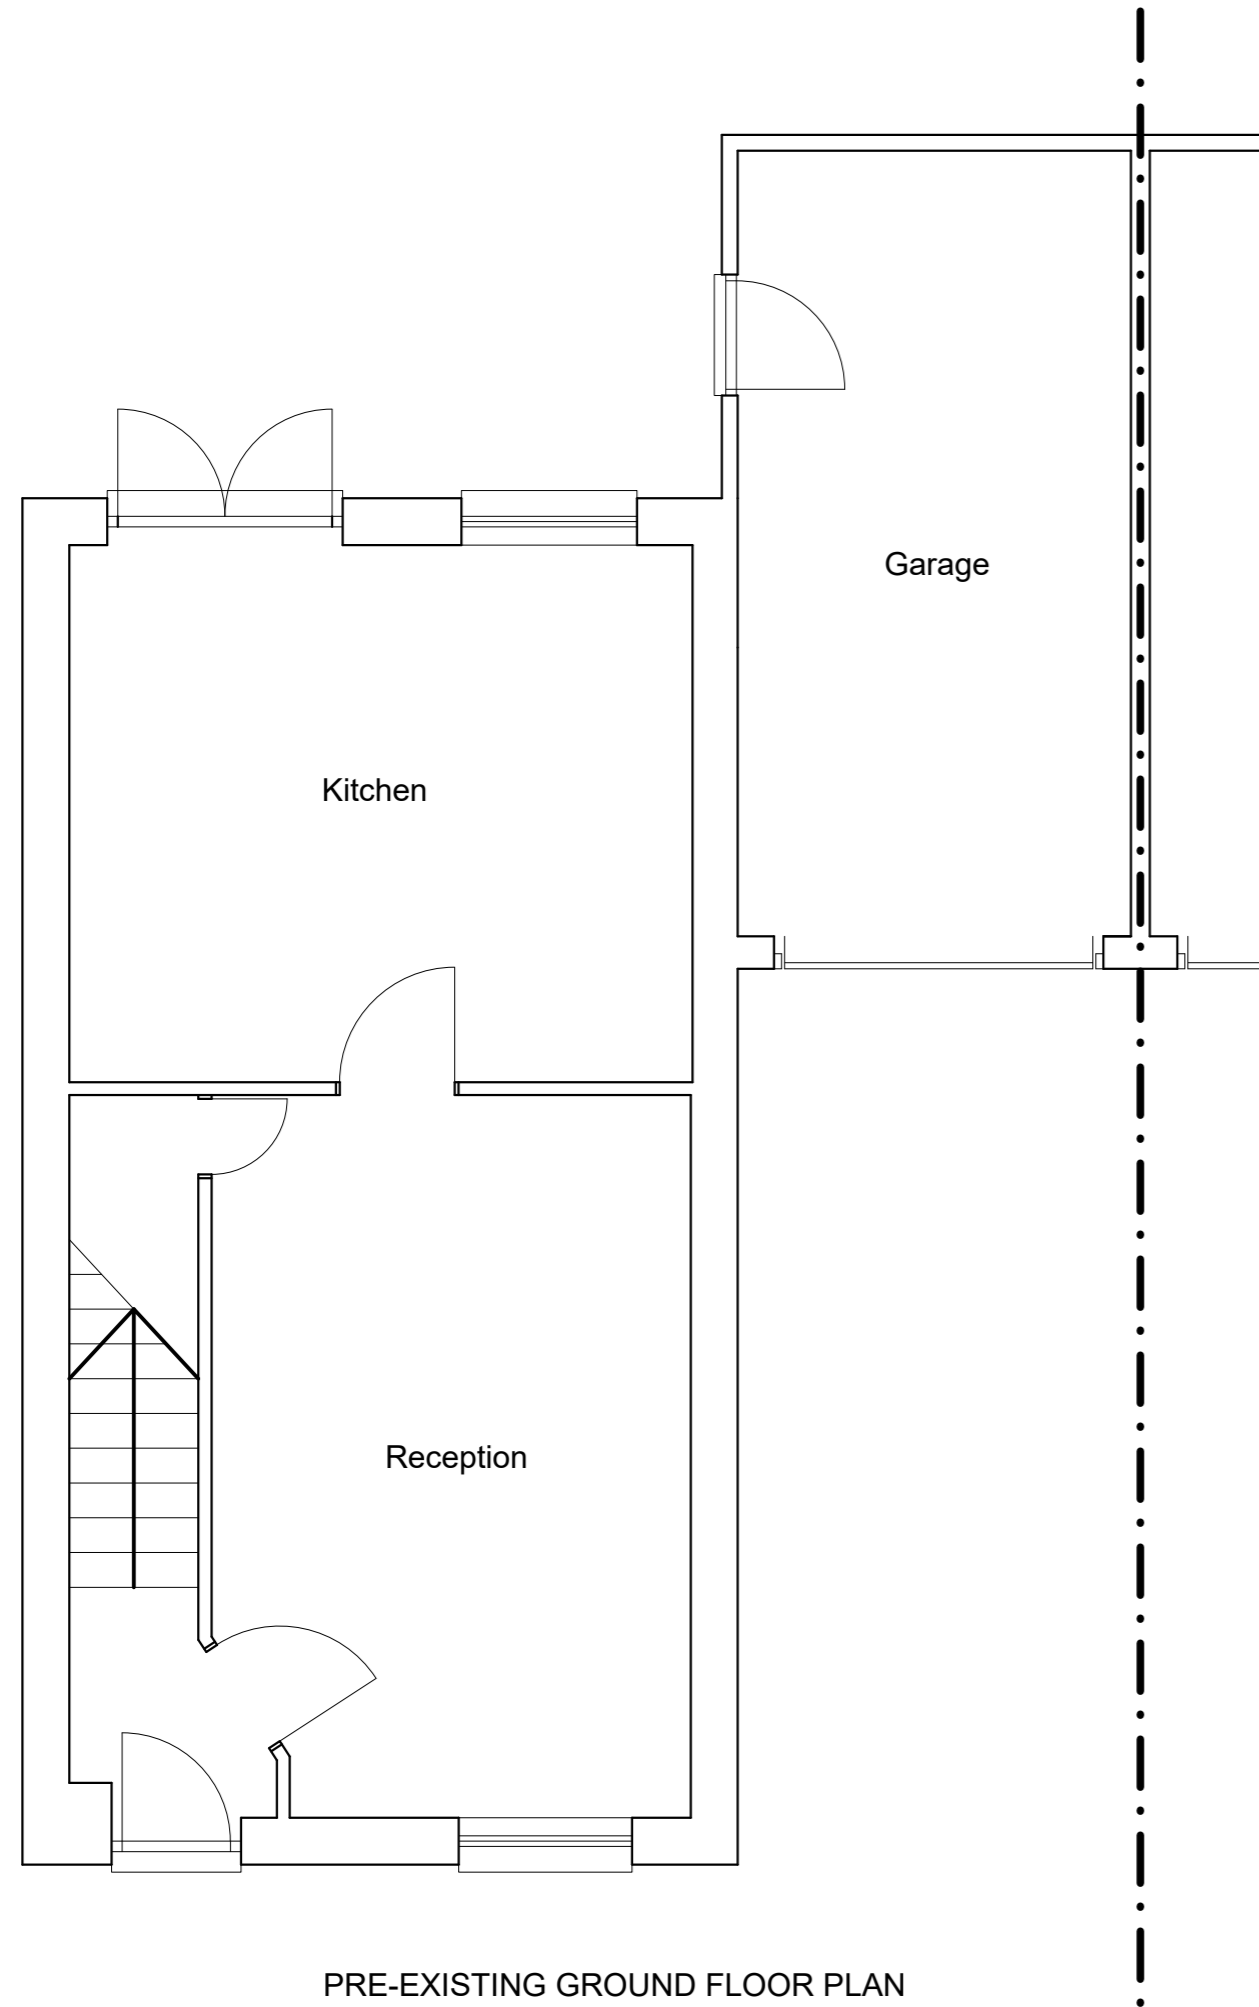

PRE-EXISTING GROUND FLOOR PLAN

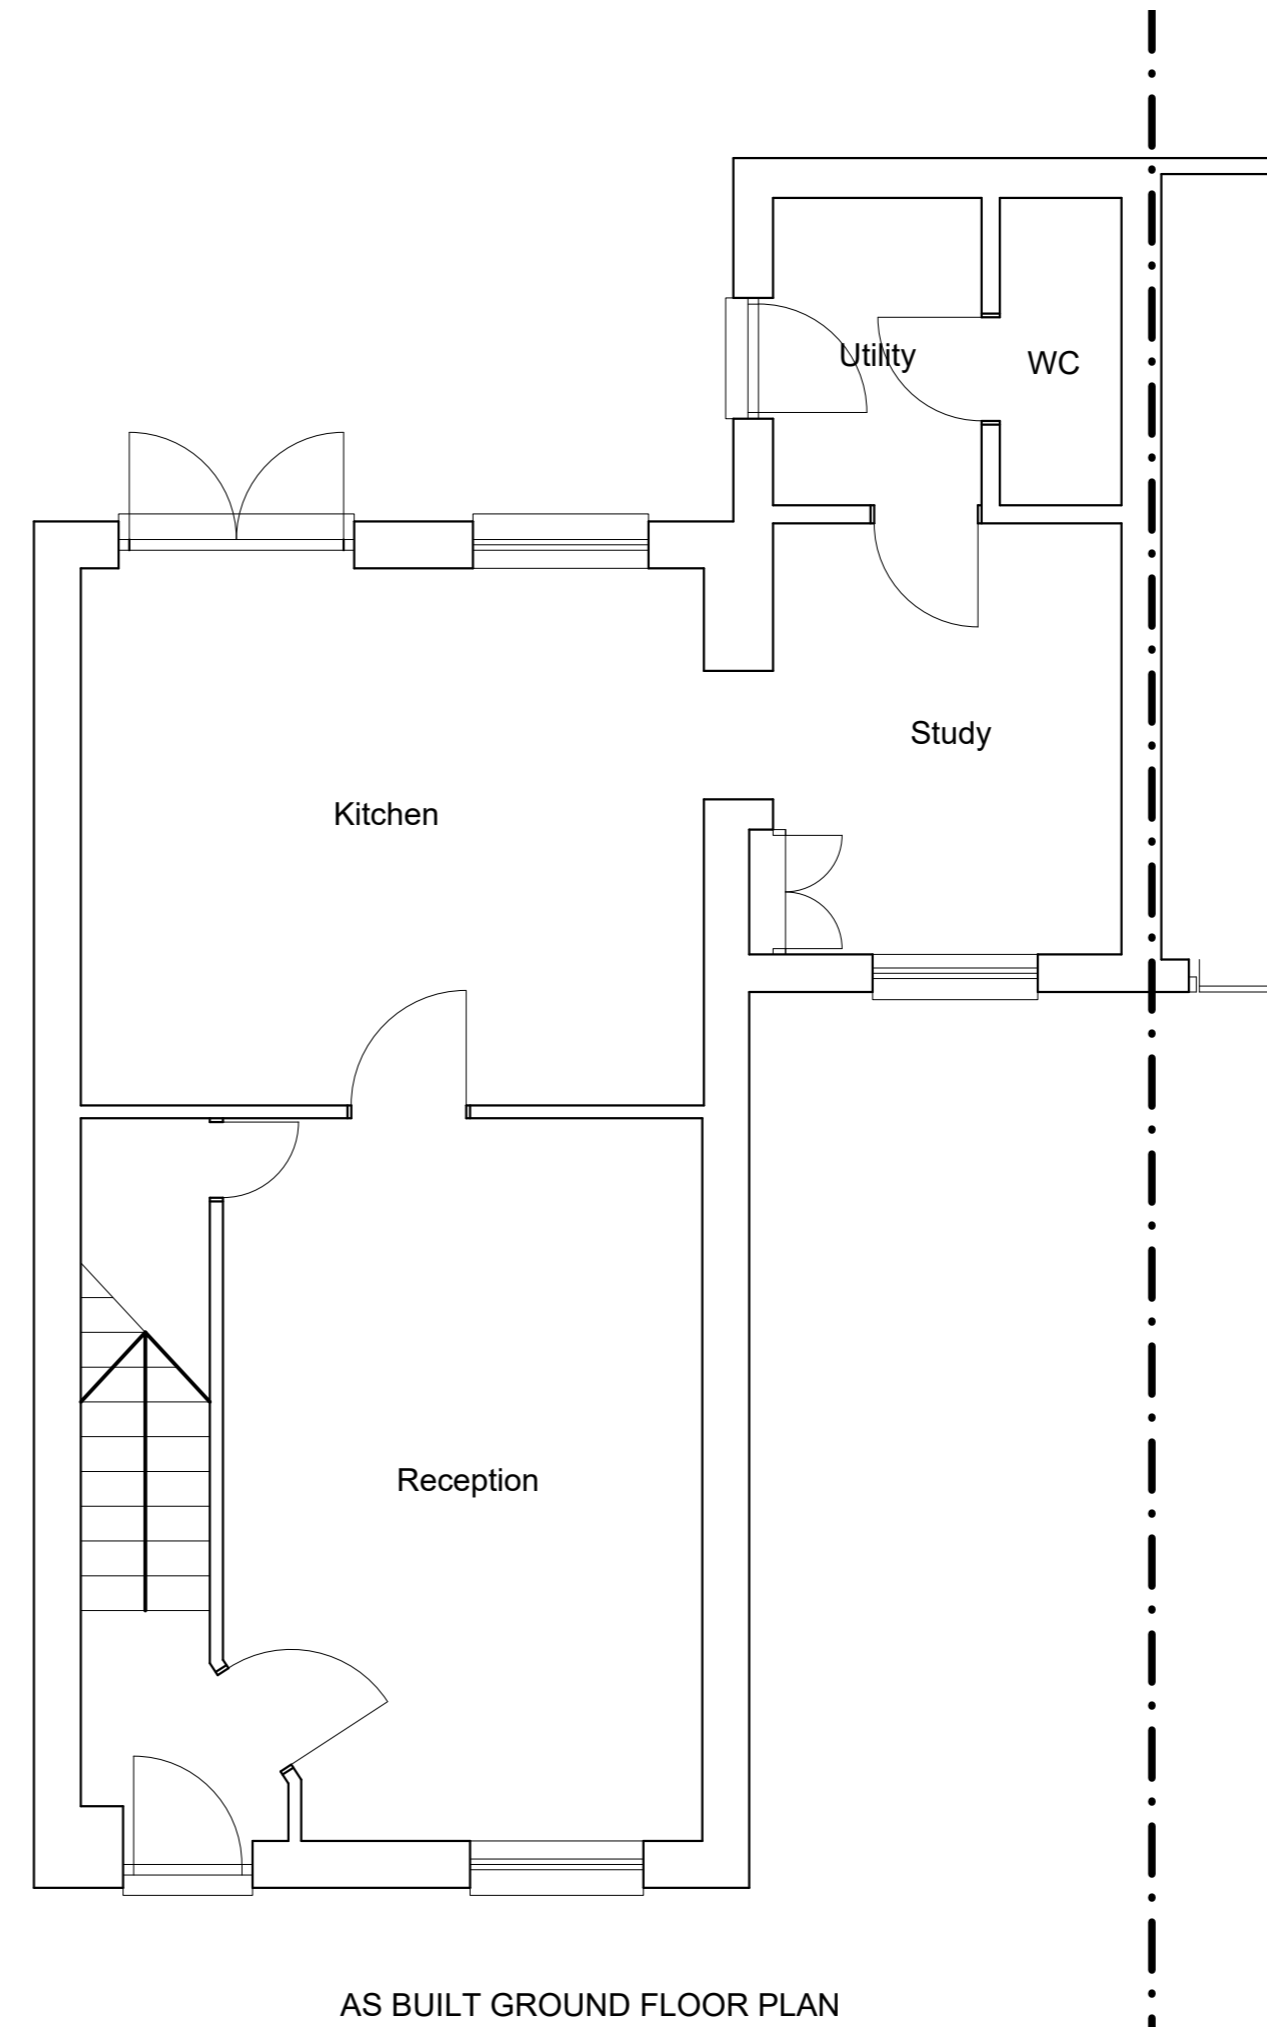


AS BUILT GROUND FLOOR PLAN

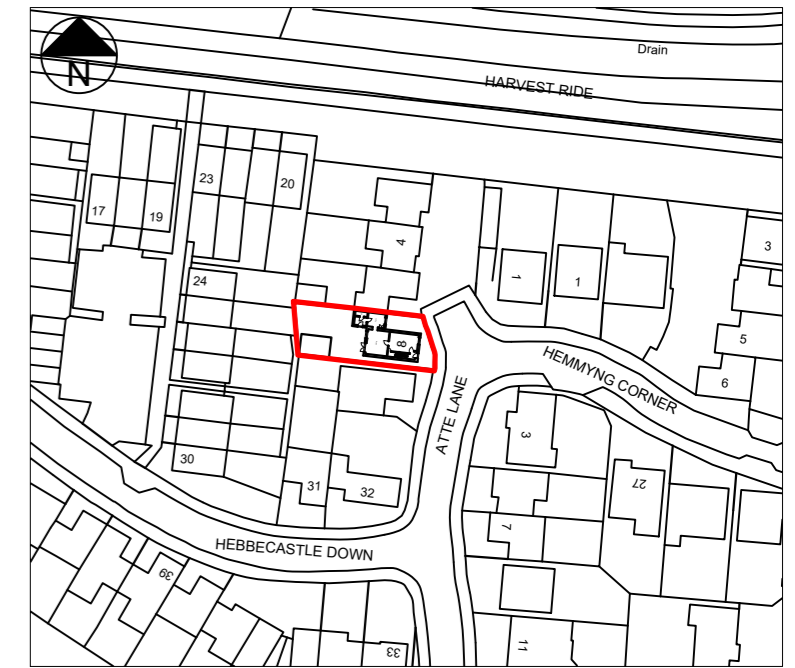

LOCATION PLAN (1:1250)



SCALE BAR 1:50

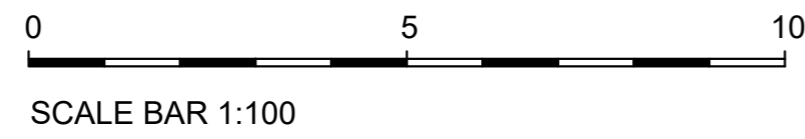

SCALE BAR 1:100

T R Harris Design & Surveying Services
 559 Rayners lane, Pinner, Middlesex HA5 5HP
 www.trharrisdesign.co.uk Tel: 020 8868 5048

PROJECT

8 Atte Lane
 Warfield
 BRACKNELL
 RG42 2QQ

TITLE

Plans & Elevations

SCALE	1:50 & 1:100 @ A2	DRAWING NO.	23/8AL/01
DATE	October 2023		