

0 1 2 3 4 5 6 7 8 9 10 SCALE (METRES)

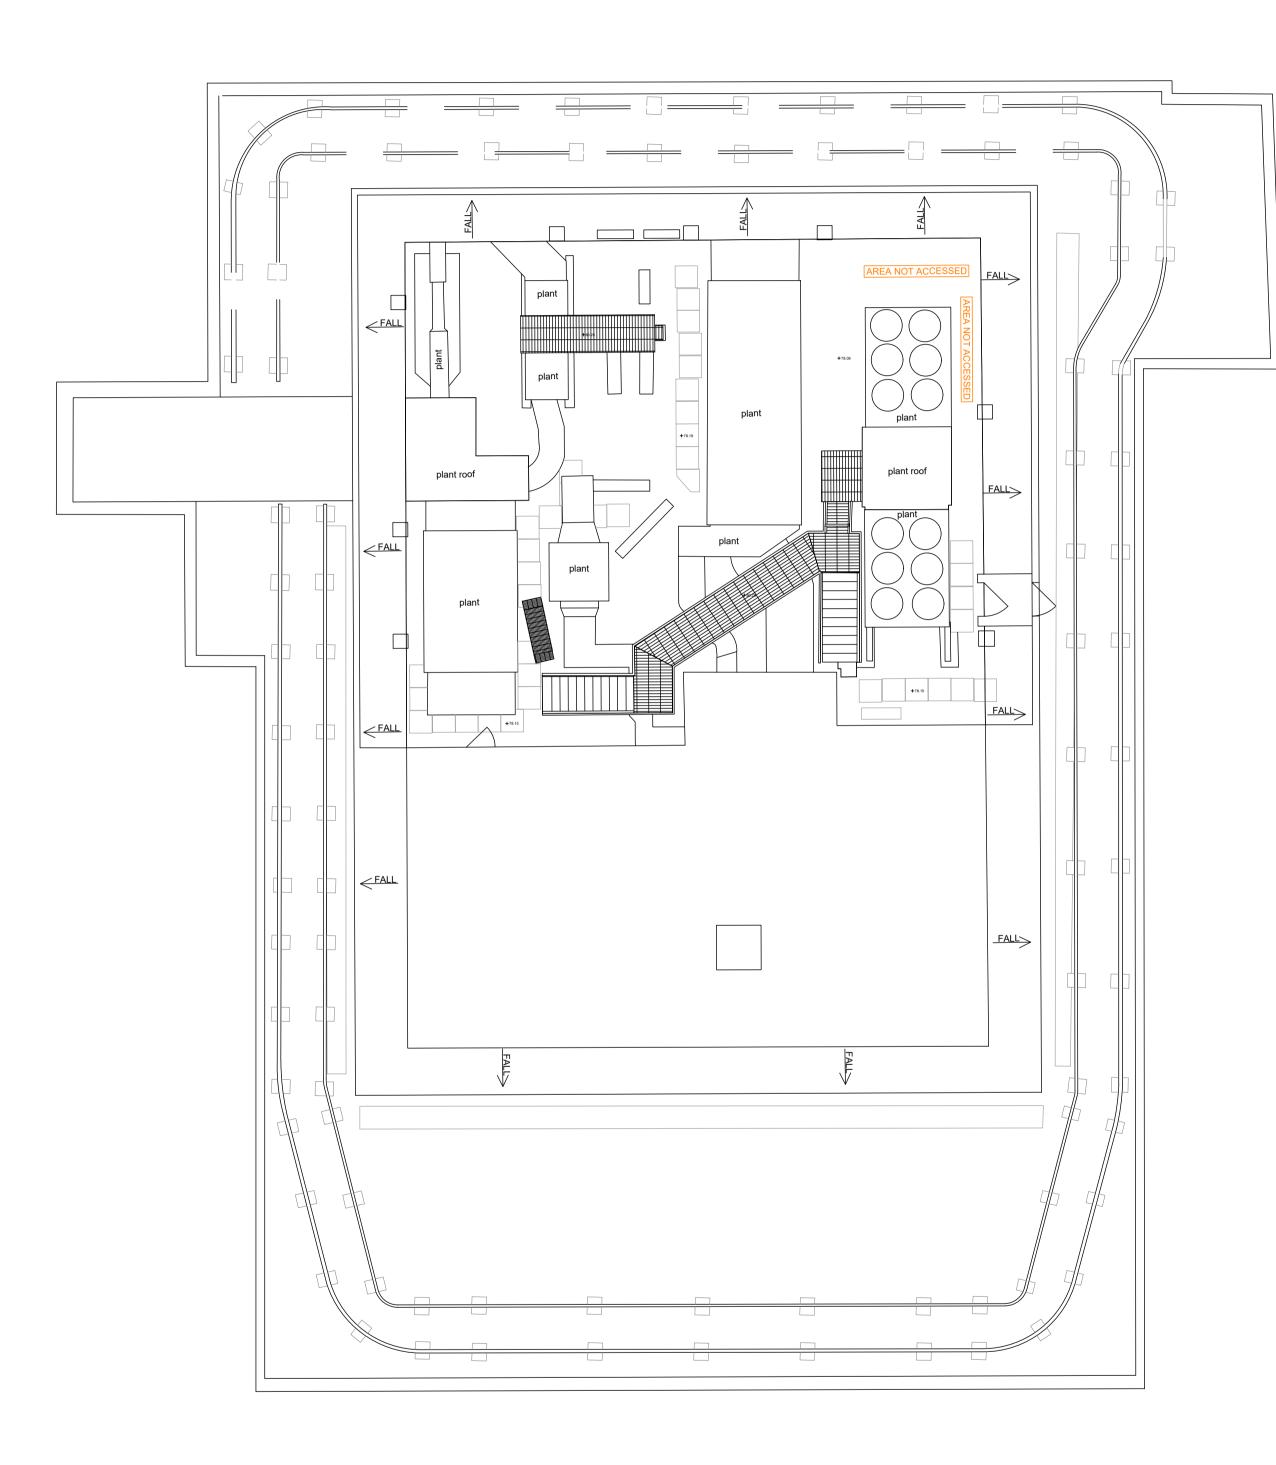

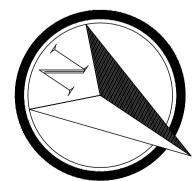

## DISCLAIMER:

This drawing should not be scaled. The contractor is to check all dimensions on site and inform the contract administrator/project manager of any discrepancies. All work is to comply in every aspect with the Building Regulations, Codes of Practice and British Standards. This drawing is to be read in conjunction with all other contract drawings and specifications.

This drawing is copyrighted and must not be reproduced in any format or disclosed to any third party without the written consent of Tuffin Ferraby Taylor LLP.

REV	REVISION	DATE	PROD	CKD
3	Re-Sheeting	07-11-23	-	-

## LEGEND

+ 10.00	FLOOR/ROOF LEVEL
87.76	CEILING OR UNDERSIDE OF BEAM LEVEL (m)
(88.07)	SUSPENDED CEILING LEVEL (m)
[88.07]	FALSE CEILING LEVEL (m)
4201	FLOOR TO UNDERSIDE OF CEILING OR BEAM HEIGHT (mm)
2594 F/C	FLOOR TO UNDERSIDE OF FALSE CEILING HEIGHT (mm)
2716 S/C	FLOOR TO UNDERSIDE OF SUSPENDED CEILING HEIGHT (mm)
3075 ST	FLOOR TO UNDERSIDE OF STEEL HEIGHT (mm)
H=2.00	FLOOR TO DOOR HEAD HEIGHT
HL=82.25	FLOOR HEAD LEVEL
S=1.00	FLOOR TO WINDOW/HATCH SILL HEIGHT
H=2.00	FLOOR TO WINDOW/HATCH HEAD HEIGHT
SL=86.05	WINDOW SILL LEVEL
HL=87.85	WINDOW HEAD LEVEL
gу	GULLY
svp	SOIL VENT PIPE
rwp	RAINWATER PIPE
cv	COVER
ACU	AIR CONDITIONING UNIT
htr	HEATED TOWEL RAIL



t: +44 (0) 20 3479 77 77 e: enquiries@tftconsultants.com w: www.tftconsultants.com

CLIENT The Crown Estate						
PROJECT	15 Regent Street London SW1Y 4LR					
DRAWING TITLE	Existing Roof Plan					
DRAWING No.	230546-R-2					
PROJECT No.	230546	DATE	25-10-2023			
scale 1:100	SIZE SIZE A1	REVISION 3	JB			
AS BUILT						

APPROXIMATE NORTH