

DISCLAIMER:
This drawing should not be scaled. The contractor is to check all dimensions on site and inform the contract administrator/project manager of any discrepancies. All work is to comply in every aspect with the Building Regulations, Codes of Practice and British Standards. This drawing is to be read in conjunction with all other contract drawings and specifications. This drawing is copyrighted and must not be reproduced in any format or disclosed to any third party without the written consent of Tuffin Ferraby Taylor LLP.

REV	REVISION	DATE	PROD	CKD
2	Re-Sheeting	07-11-23	-	-


LEGEND

- + 10.00 FLOOR/ROOF LEVEL
- [87.76] CEILING OR UNDERSIDE OF BEAM LEVEL (m)
- (88.07) SUSPENDED CEILING LEVEL (m)
- [88.07] FALSE CEILING LEVEL (m)
- (4201) FLOOR TO UNDERSIDE OF CEILING OR BEAM HEIGHT (mm)
- (2594 F/C) FLOOR TO UNDERSIDE OF FALSE CEILING HEIGHT (mm)
- (2716 S/C) FLOOR TO UNDERSIDE OF SUSPENDED CEILING HEIGHT (mm)
- (3075 ST) FLOOR TO UNDERSIDE OF STEEL HEIGHT (mm)
- H=2.00 FLOOR TO DOOR HEAD HEIGHT
- HL=82.25 FLOOR HEAD LEVEL
- S=1.00 FLOOR TO WINDOW/HATCH SILL HEIGHT
- H=2.00 FLOOR TO WINDOW/HATCH HEAD HEIGHT
- SL=86.05 WINDOW SILL LEVEL
- HL=87.85 WINDOW HEAD LEVEL
- gy GULLY
- svp SOIL VENT PIPE
- rwp RAINWATER PIPE
- cv COVER
- ACU AIR CONDITIONING UNIT
- htr HEATED TOWEL RAIL



LOCAL DATUM: 45.00m

Elevation A

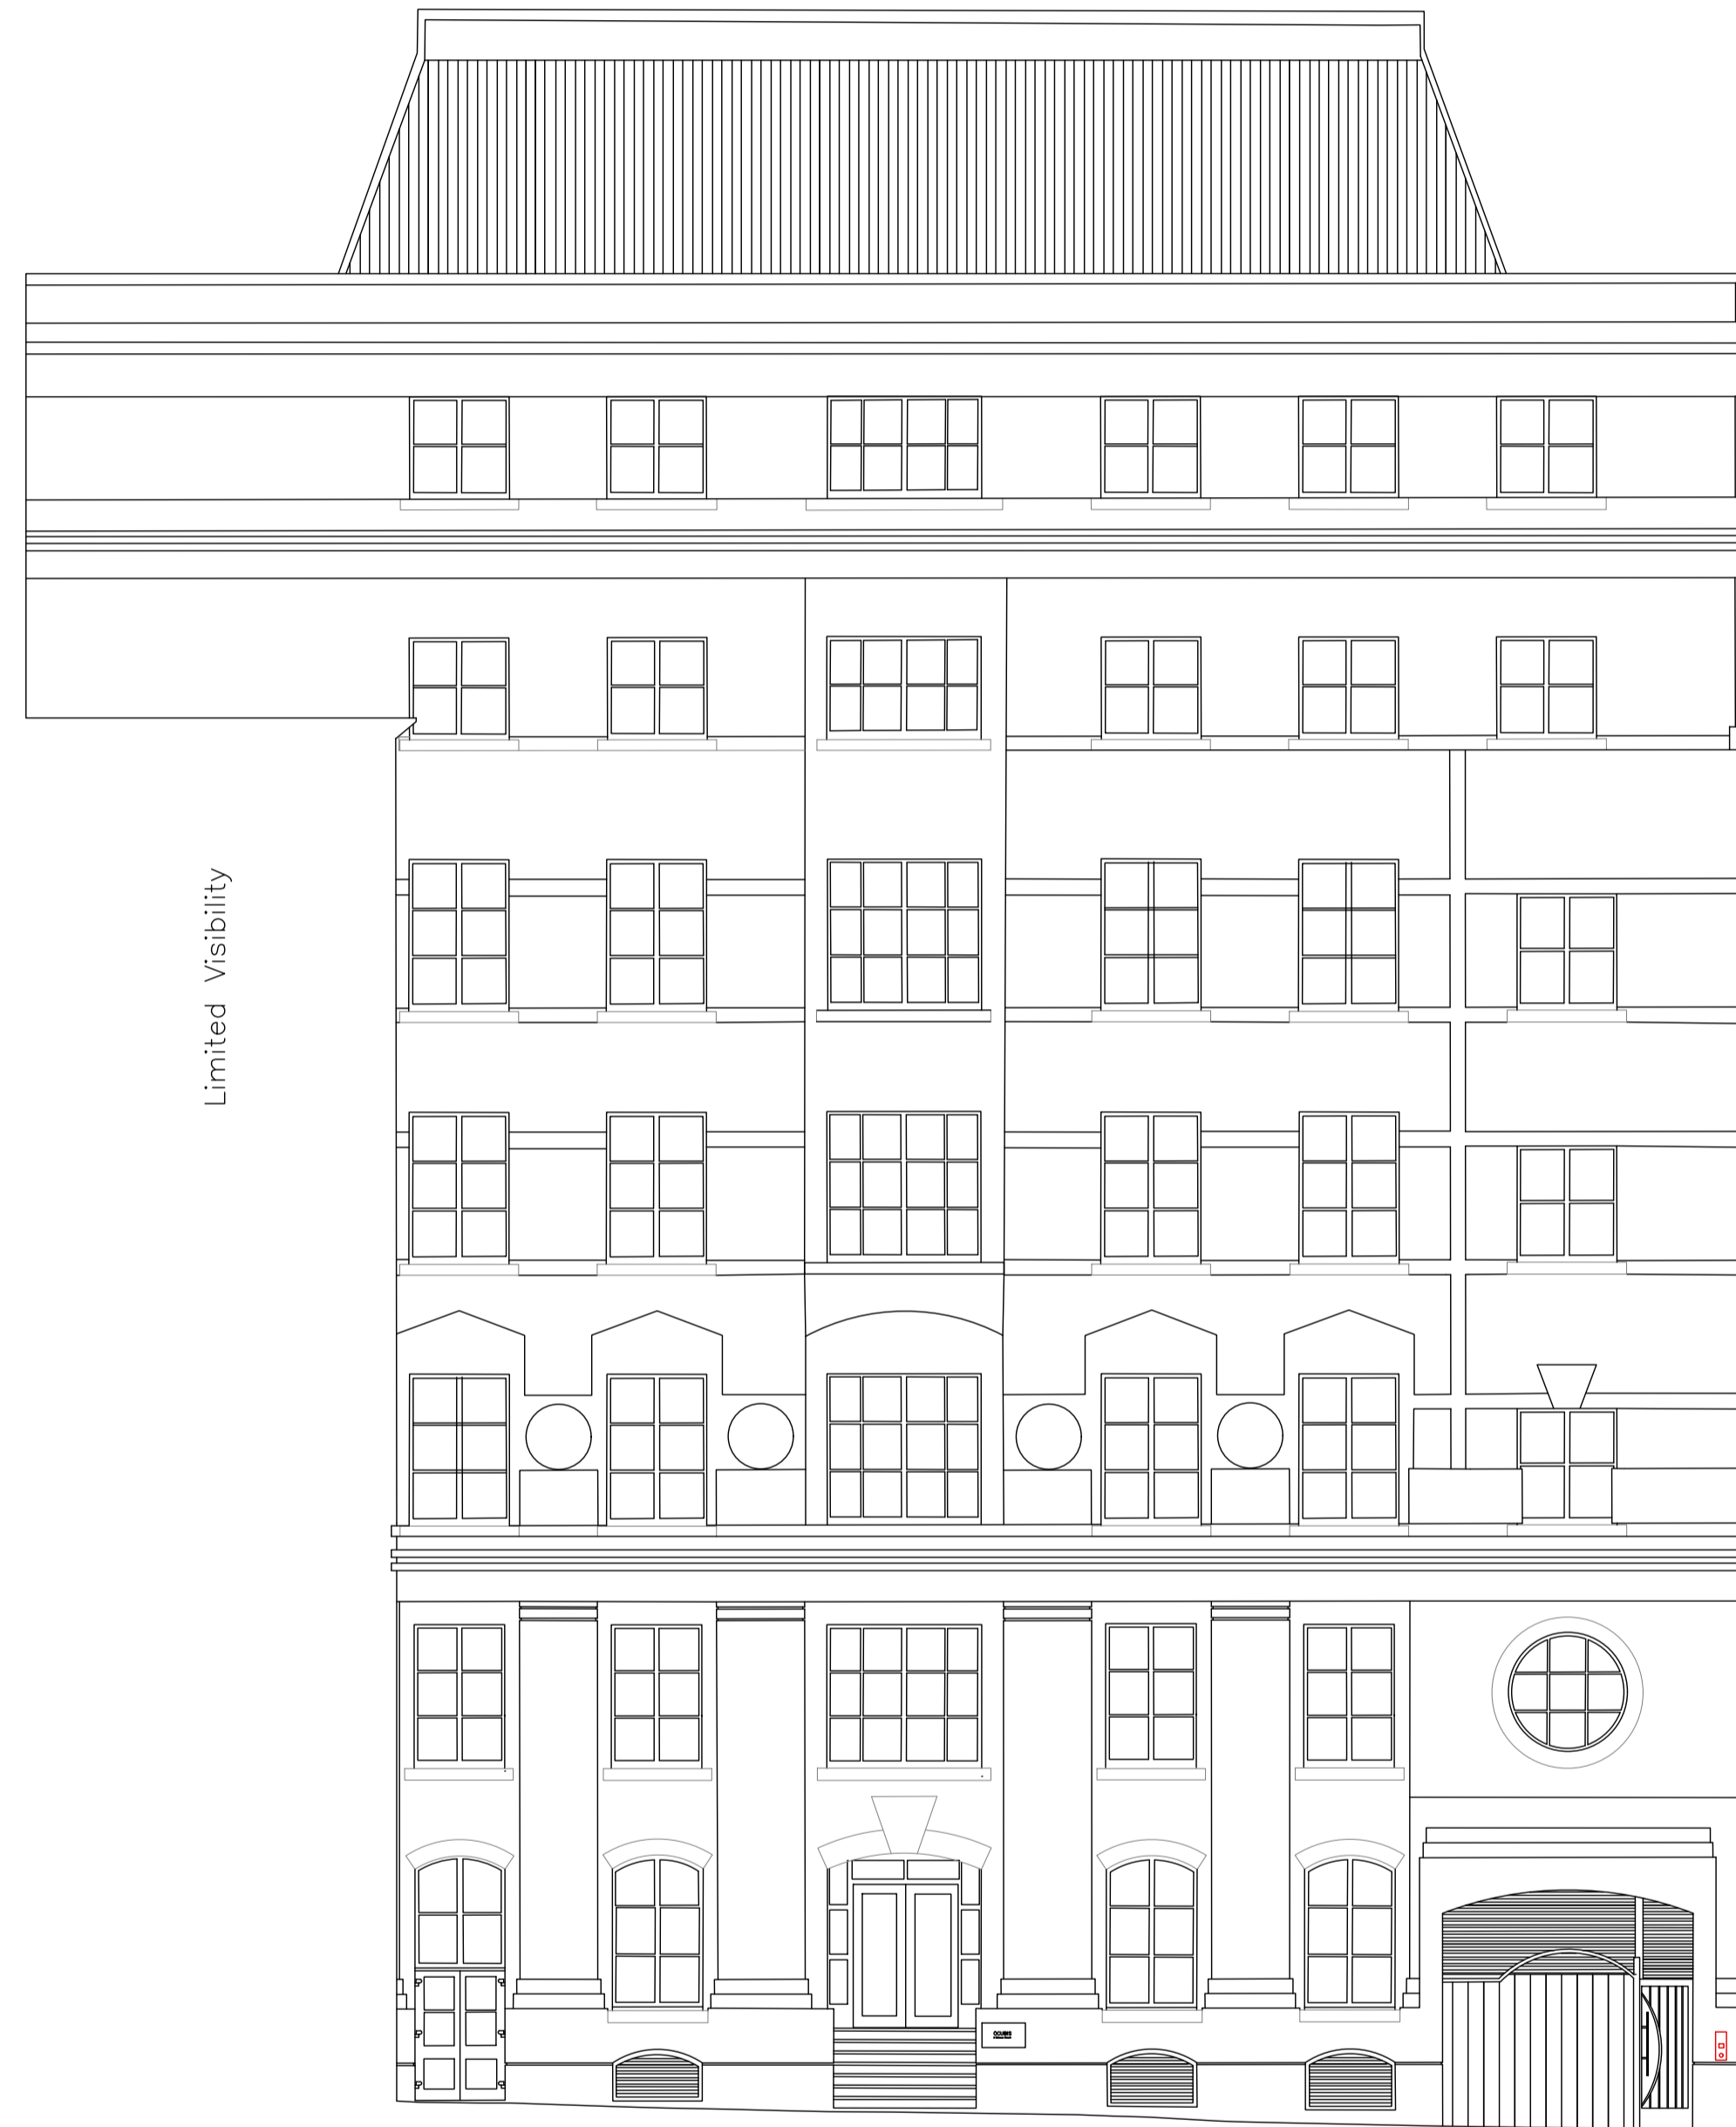

LOCAL DATUM: 45.00m




Elevation B



t: +44 (0) 20 3479 77 77
e: enquiries@tftconsultants.com
w: www.tftconsultants.com

CLIENT		The Crown Estate	
PROJECT		15 Regent Street London SW1Y 4LR	
DRAWING TITLE Existing Elevations - 1			
DRAWING No. 230546-E-1			
PROJECT No.	230546	DATE	17-10-2023
SCALE	1:100	SIZE	A1
REVISION	2	DRAWN	JB
AS BUILT			

REV 1.1

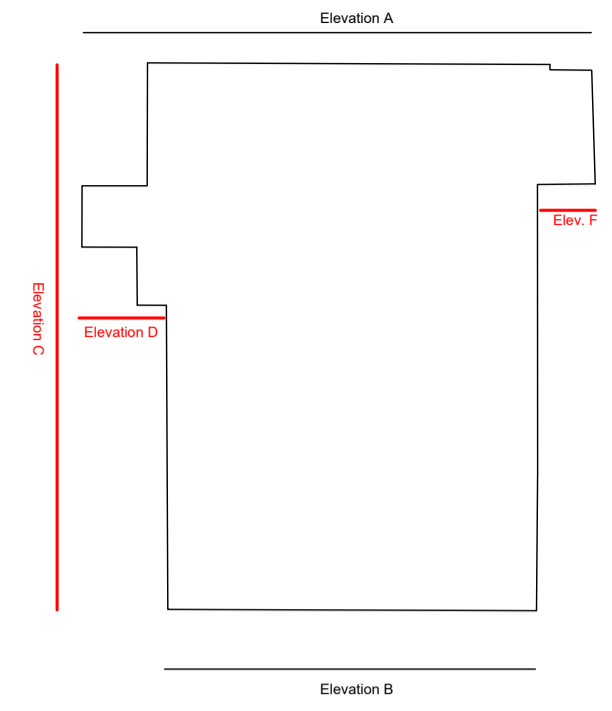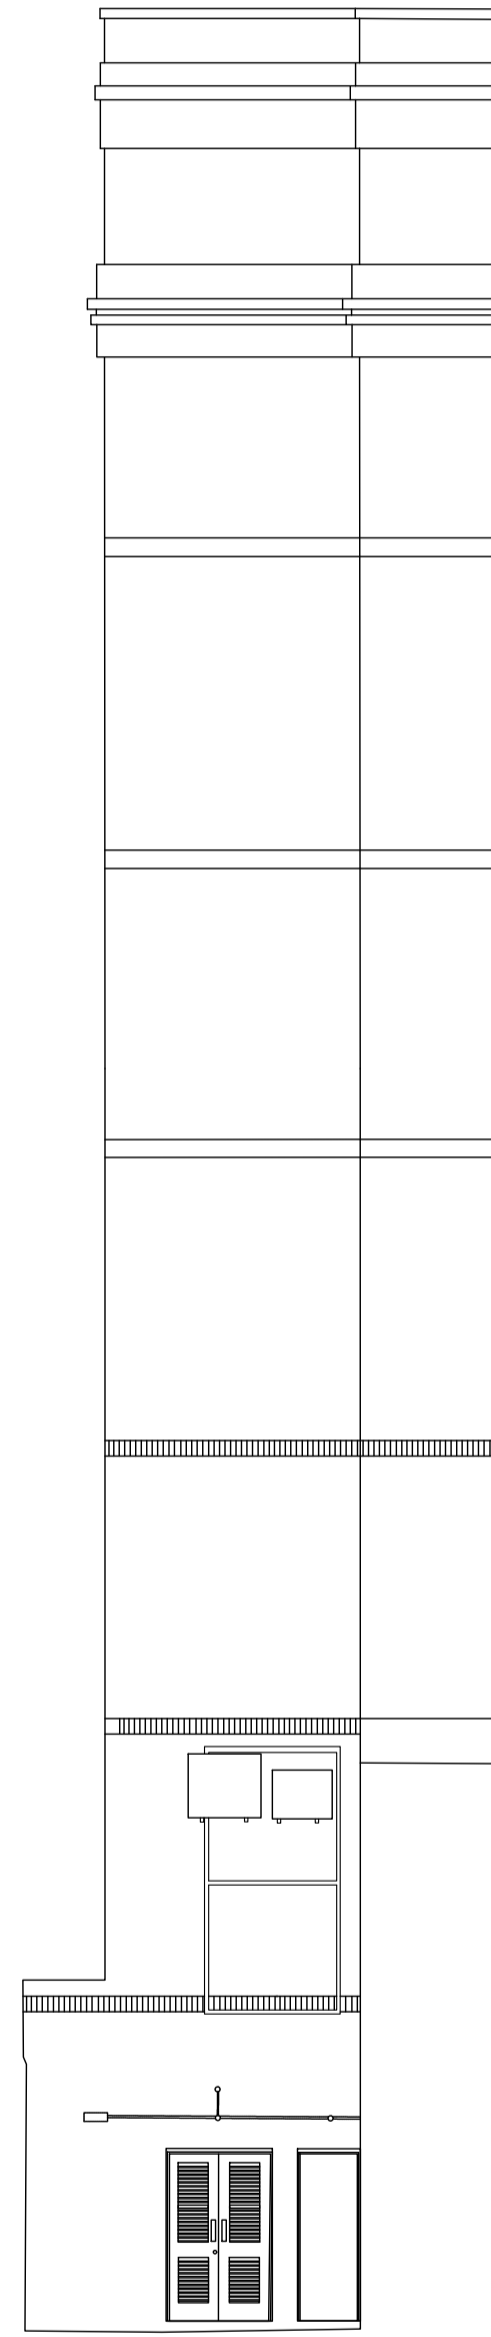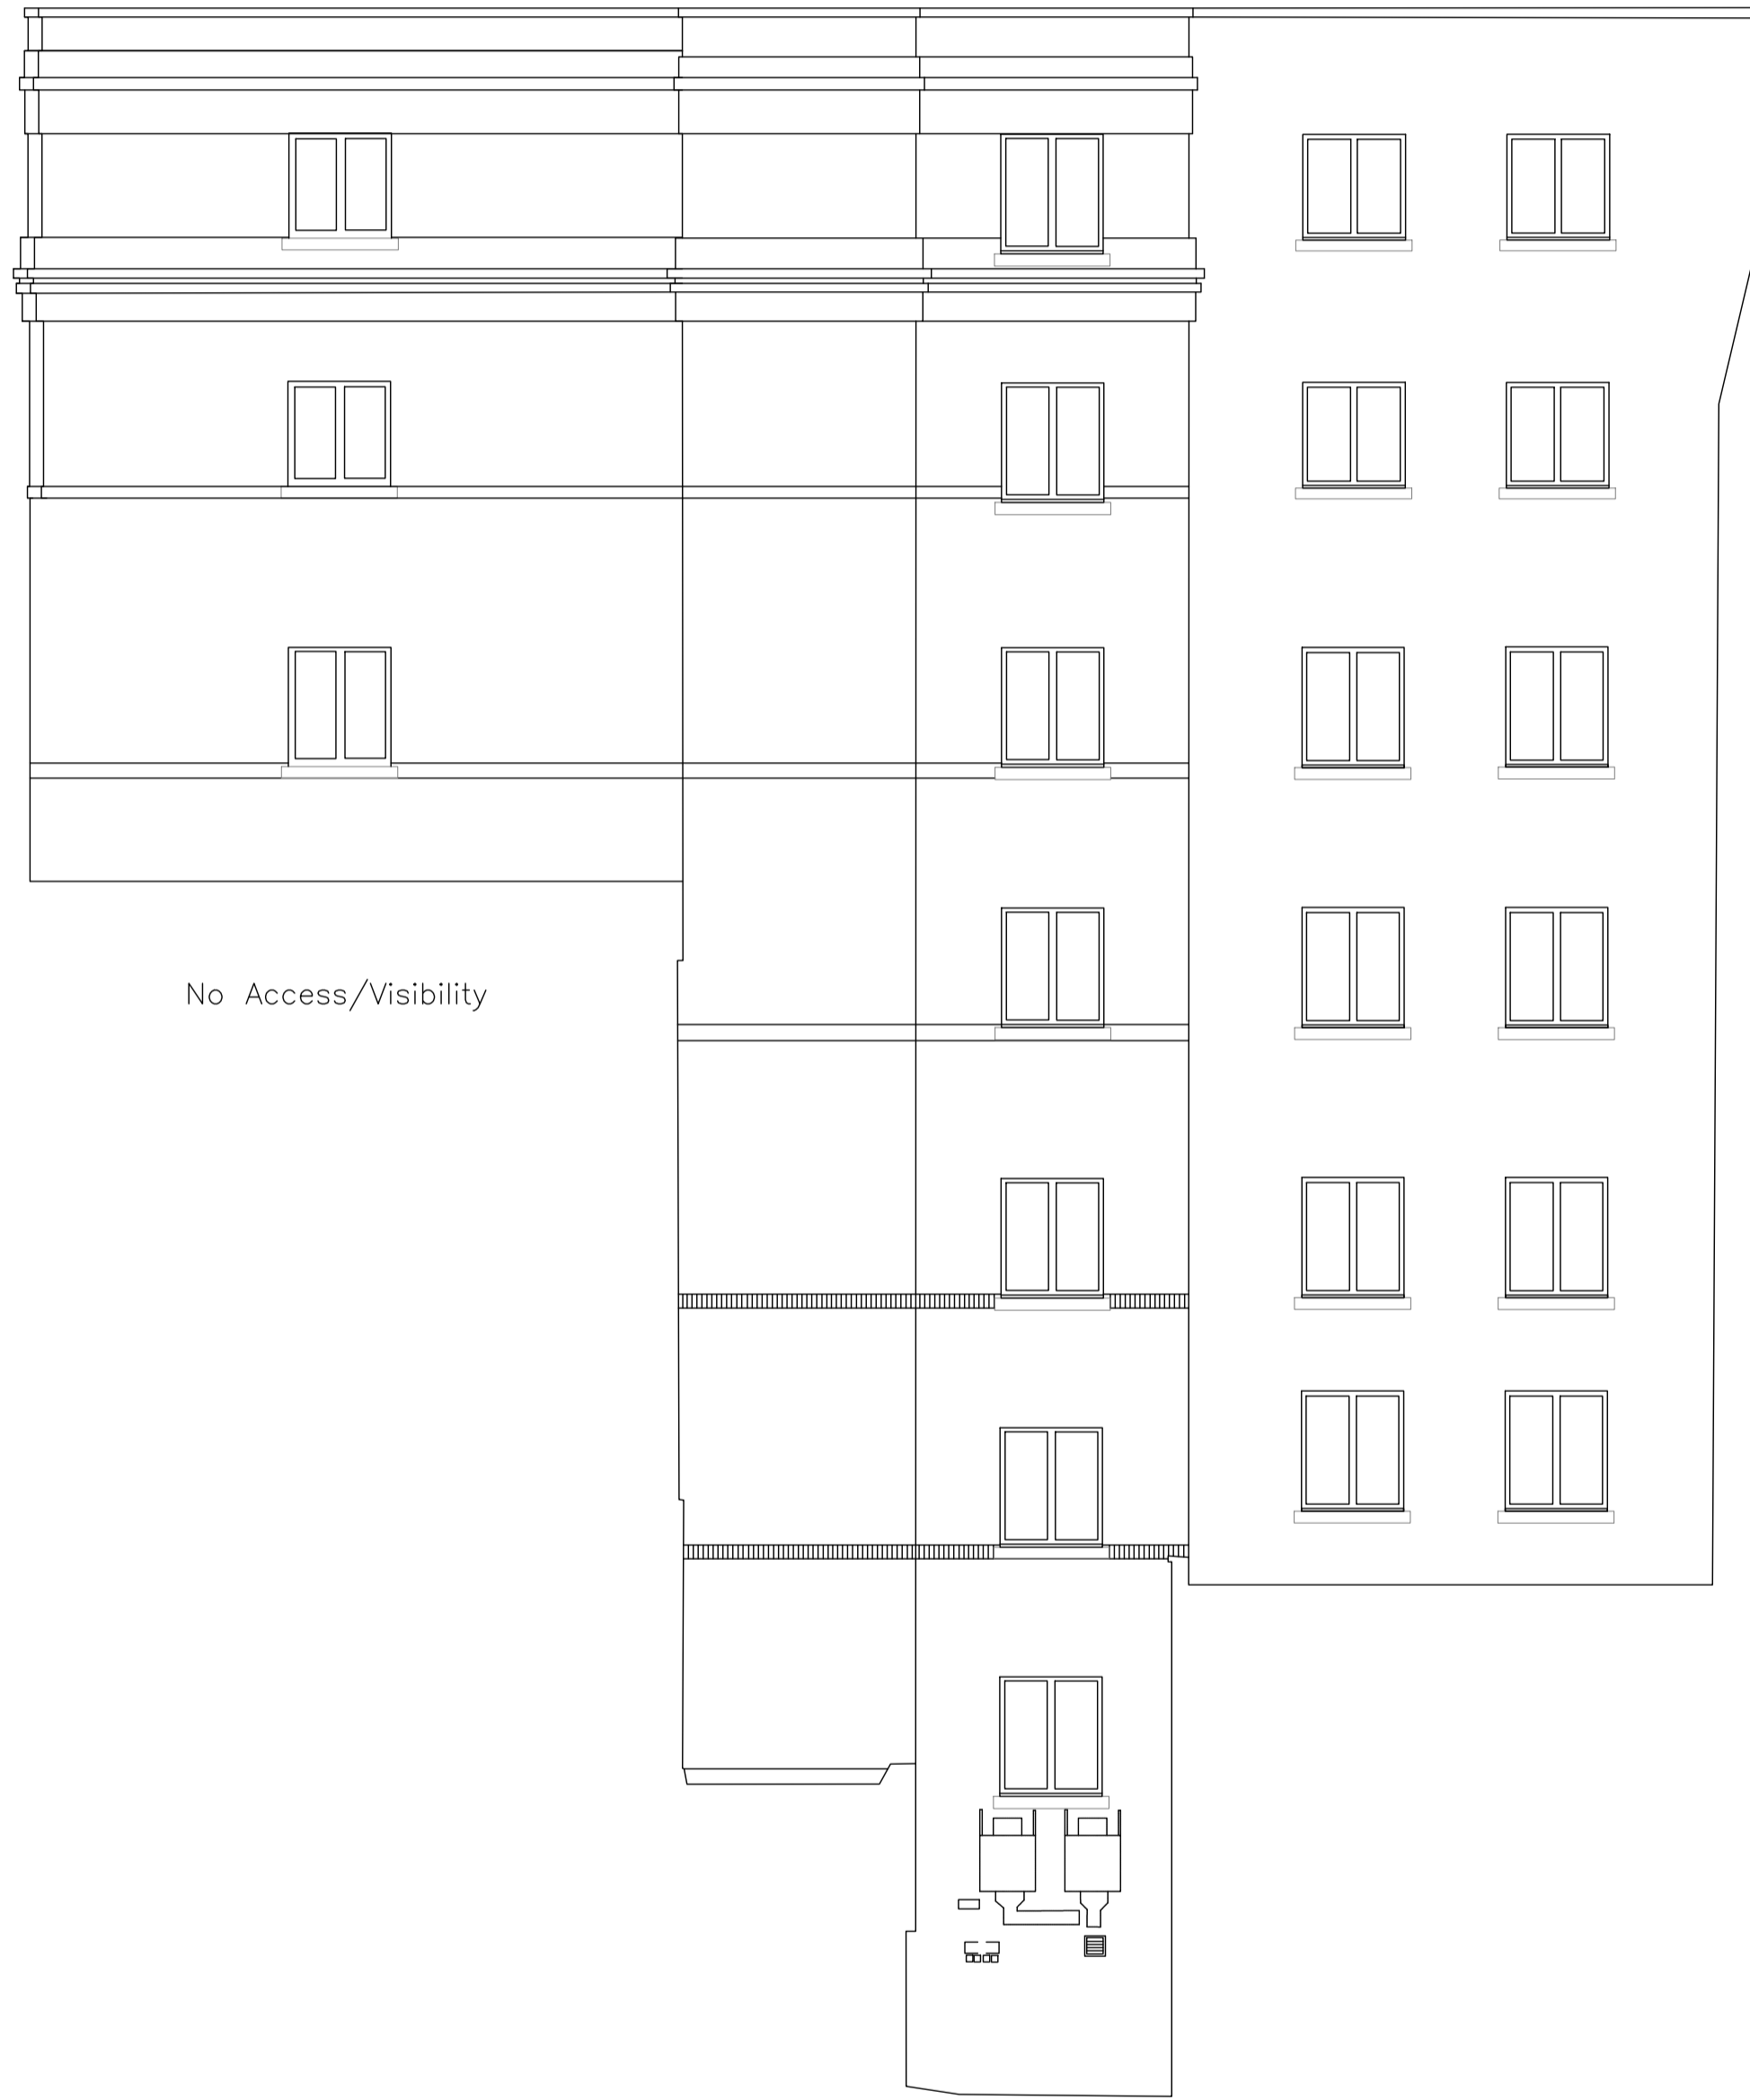

DISCLAIMER:
This drawing should not be scaled. The contractor is to check all dimensions on site and inform the contract administrator/project manager of any discrepancies. All work is to comply in every aspect with the Building Regulations, Codes of Practice and British Standards. This drawing is to be read in conjunction with all other contract drawings and specifications. This drawing is copyrighted and must not be reproduced in any format or disclosed to any third party without the written consent of Tuffin Ferraby Taylor LLP.

REV	REVISION	DATE	PROD	CKD
2	Re-Sheeting	07-11-23	-	-

LEGEND

- + 10.00 FLOOR/ROOF LEVEL
- [87.76] CEILING OR UNDERSIDE OF BEAM LEVEL (m)
- (88.07) SUSPENDED CEILING LEVEL (m)
- [88.07] FALSE CEILING LEVEL (m)
- (4201) FLOOR TO UNDERSIDE OF CEILING OR BEAM HEIGHT (mm)
- (2594 F/C) FLOOR TO UNDERSIDE OF FALSE CEILING HEIGHT (mm)
- (2716 S/C) FLOOR TO UNDERSIDE OF SUSPENDED CEILING HEIGHT (mm)
- (3075 ST) FLOOR TO UNDERSIDE OF STEEL HEIGHT (mm)
- H=2.00 FLOOR TO DOOR HEAD HEIGHT
- HL=82.25 FLOOR HEAD LEVEL
- S=1.00 FLOOR TO WINDOW/HATCH SILL HEIGHT
- H=2.00 FLOOR TO WINDOW/HATCH HEAD HEIGHT
- SL=86.05 WINDOW SILL LEVEL
- HL=87.85 WINDOW HEAD LEVEL
- gy GULLY
- svp SOIL VENT PIPE
- rwp RAINWATER PIPE
- cv COVER
- ACU AIR CONDITIONING UNIT
- htr HEATED TOWEL RAIL

LOCAL DATUM: 45.00m

Elevation C

Elevation D

Elevation E

Elevation F



t: +44 (0) 20 3479 77 77
e: enquiries@tftconsultants.com
w: www.tftconsultants.com

CLIENT		The Crown Estate	
PROJECT		15 Regent Street London SW1Y 4LR	
DRAWING TITLE Existing Elevations - 2			
DRAWING No. 230546-E-1			
PROJECT No.	230546	DATE	17-10-2023
SCALE	1:100	SIZE	A1
REVISION	2	DRAWN	JB
AS BUILT			

REV 1.1