



FIRST FLOOR

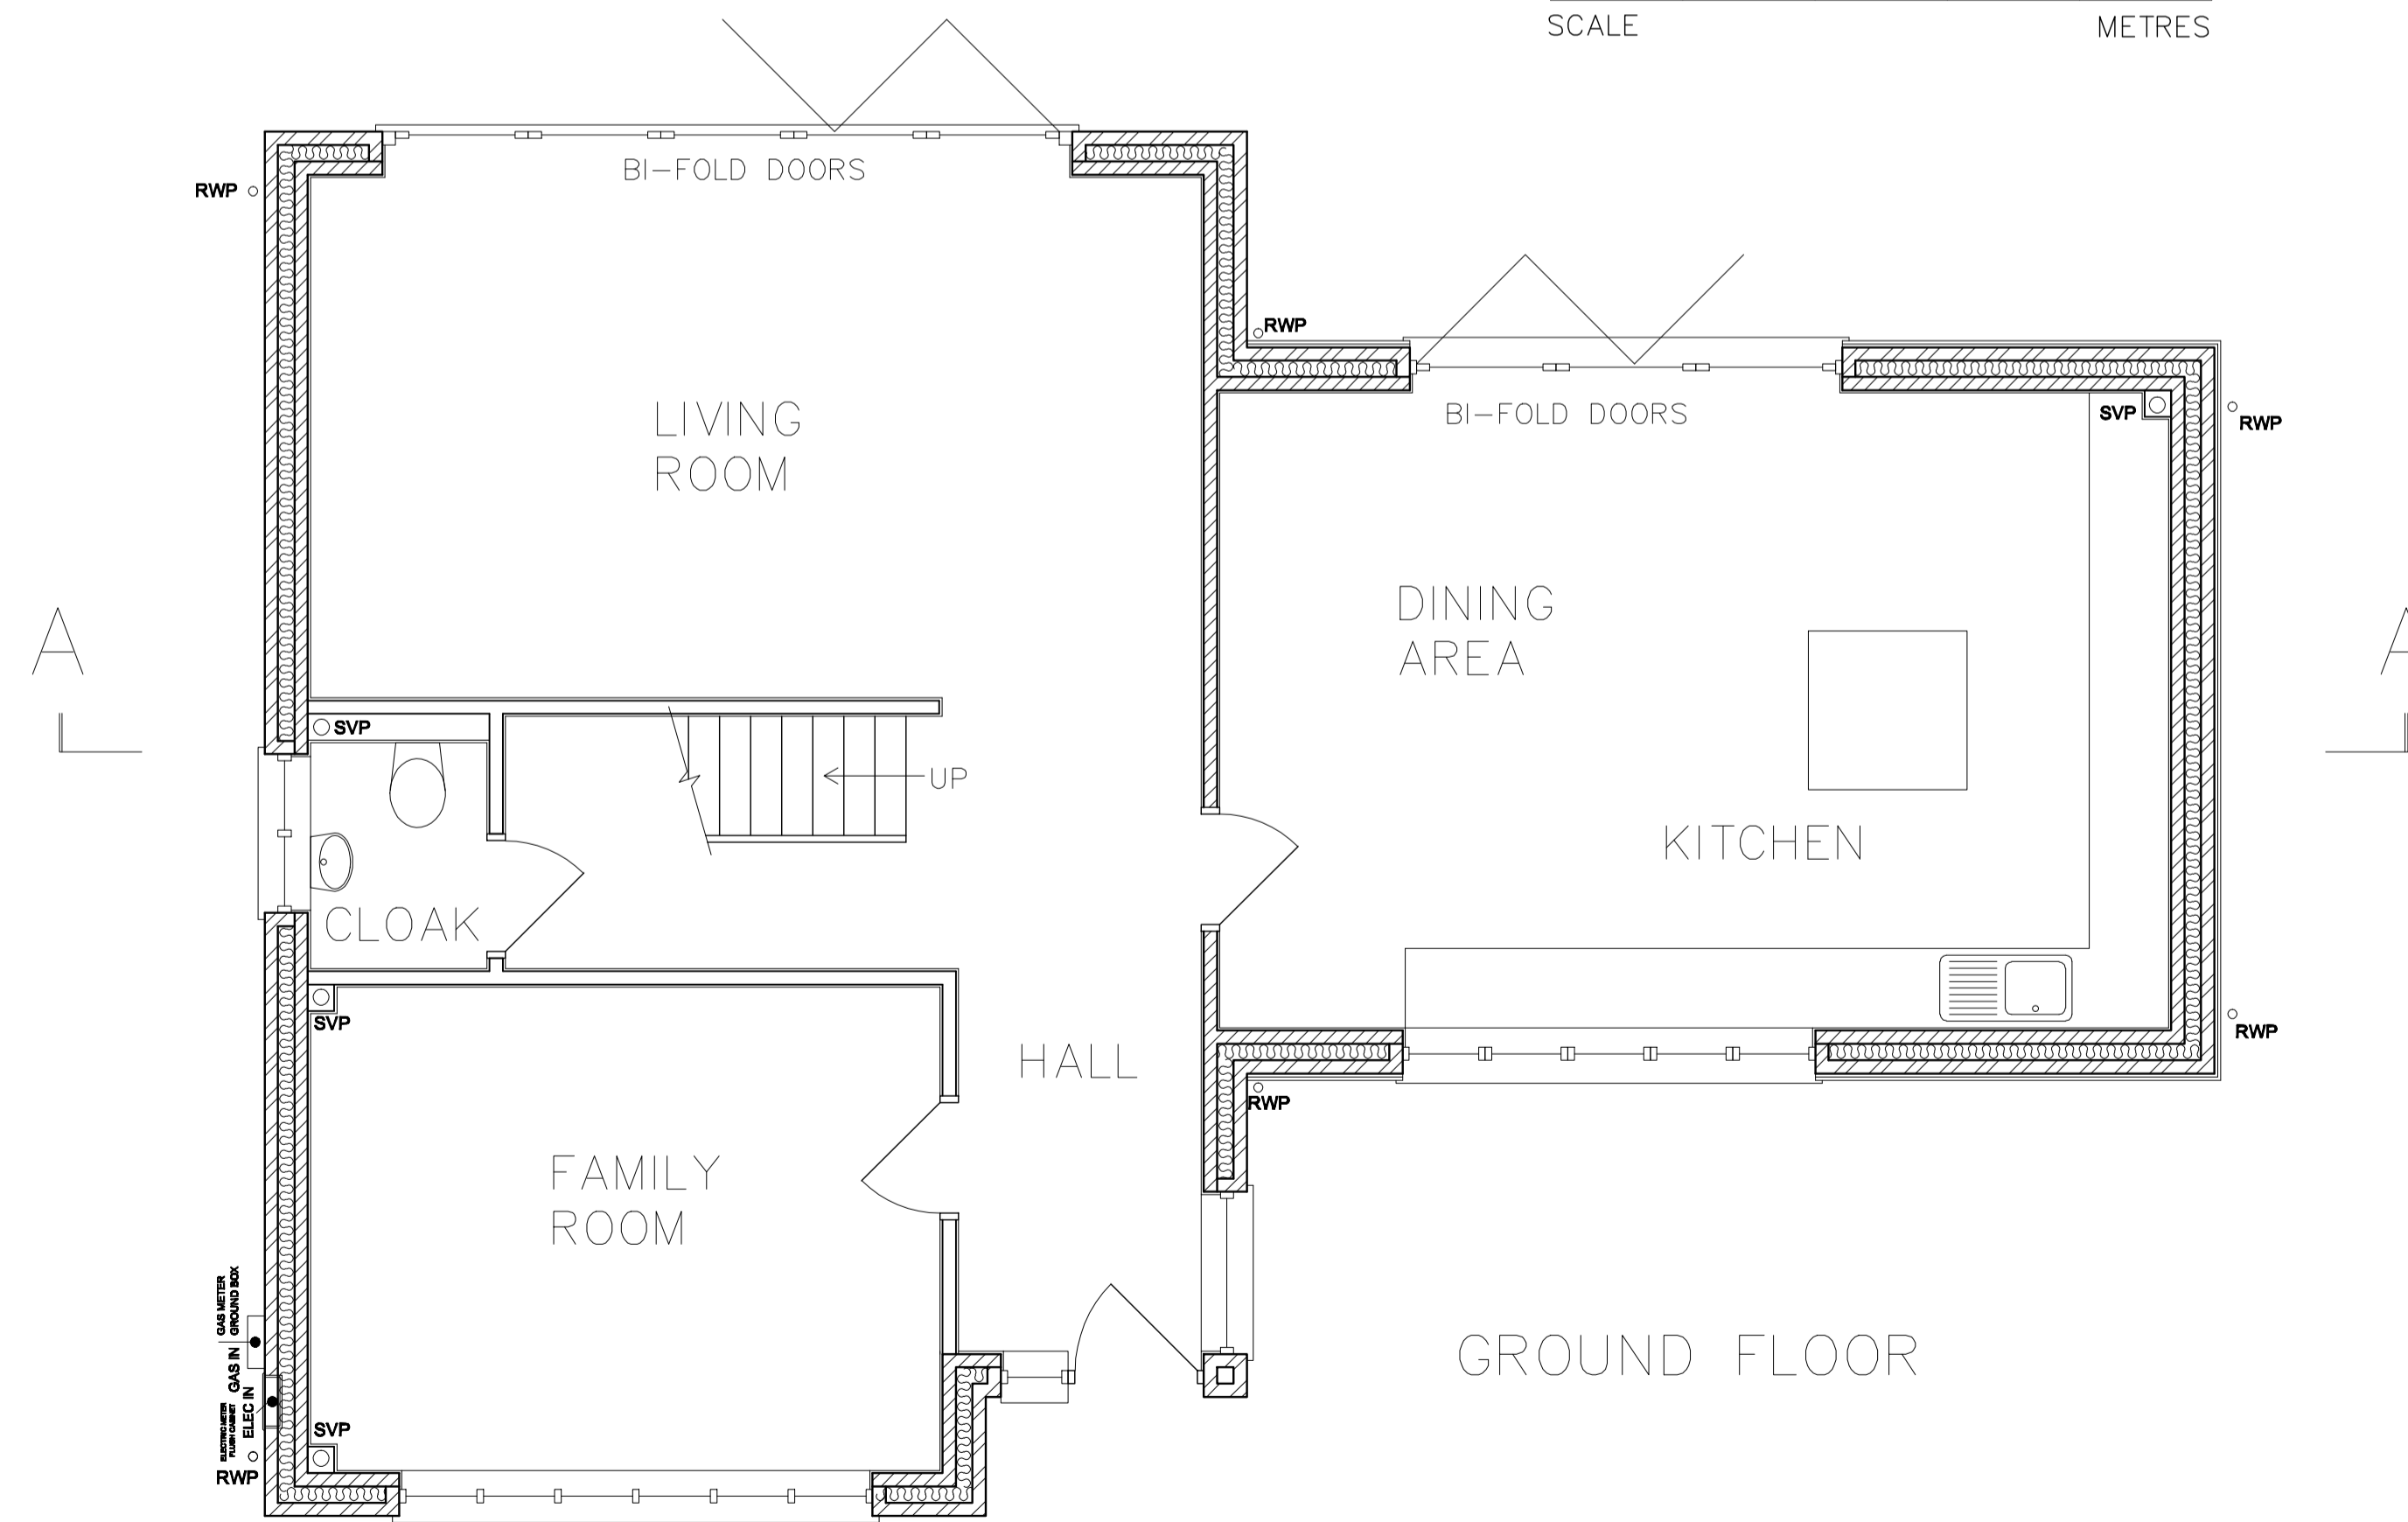

GROUND FLOOR

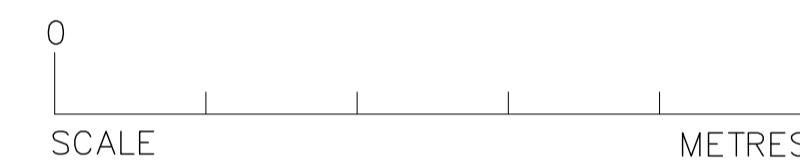

MICHAEL HARRIS ASSOCIATES  
 BUILDING DESIGN MANAGEMENT  
 The Granary, Halden Place, Halden Lane  
 Rolvenden, Kent TN17 4JG  
 Tel: 01580 241278  
 www.michaelharrisassociates.com

Rev E As built 23-10-23  
 Rev C layout amended to suit 'as built' foundations & walls (see dwg WLO/07A)  
 Rev A master bedroom layout & window amends 23-8-22

No.7 Worm Lake Orchard,  
 Maidstone road, Sutton Valence  
 PROPOSED DEVELOPMENT PLOT 7  
 for Mr J Tyler  
 PLOT 7 HOUSE PLANS  
 Scale 1:50 @ A1 Jan 2022 WLO/01E