



FRONT (SOUTHEAST) ELEVATION




SIDE (SOUTHWEST) ELEVATION

MATERIALS/FINISHES

BRICKWORK- FRESHFIELD LANE FIRST QUALITY STOCKS
 WEATHERBOARDING- WHITE FEATHER EDGE WEATHERBOARD
 ROOF TILING- REDLAND DUO-PLAIN TILES, RUSTIC BROWN
 ENTRANCE, BI-FOLD & SLIDING DOORS- ALUMINIUM, ANTHRACITE RAL 7016
 WINDOWS- ALUMINIUM, ANTHRACITE RAL 7016
 FASCIA, SOFFIT & BARGEBOARDS- MARLEY CEDRAL BOARD, COLOUR PEWTER (C54)



REAR (NORTHWEST) ELEVATION

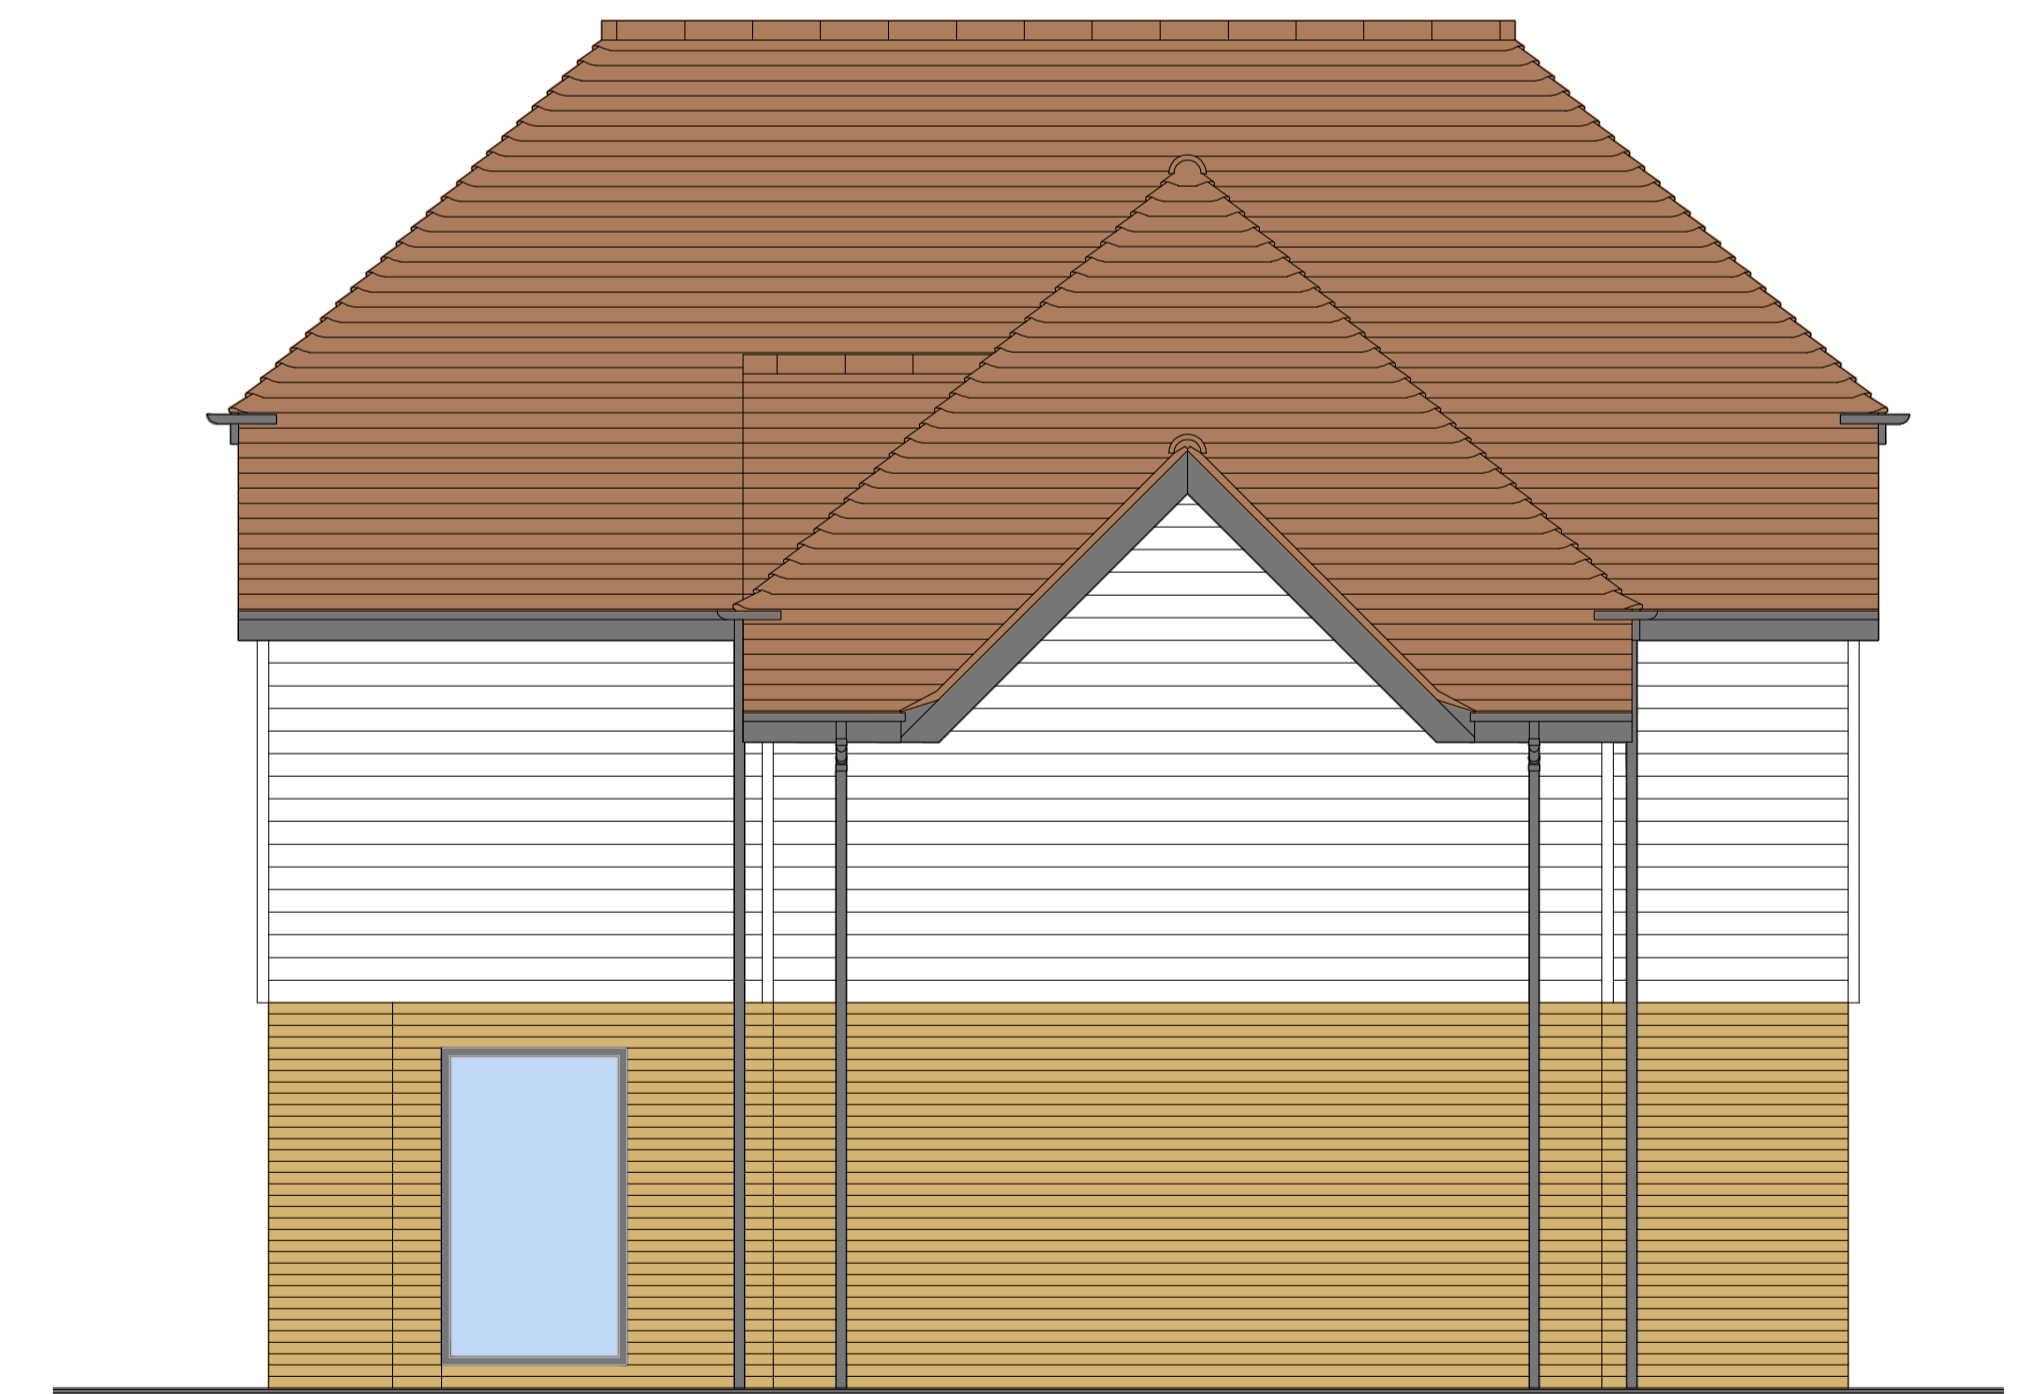

SIDE (NORTHEAST) ELEVATION



MICHAEL HARRIS ASSOCIATES
 BUILDING DESIGN MANAGEMENT
 The Granary, Halden Place, Halden Lane
 Rolvenden, Kent TN17 4JG
 Tel: 01580 241278
 www.michaelharrisassociates.com

Rev G 'As built' 23-10-23

No.8 Warm Lake Orchard,
 Maidstone road, Sutton Valence
 PROPOSED DEVELOPMENT PLOT 8
 for Mr J Tyler
 PLOT 8 HOUSE ELEVATIONS-AS BUILT
 Scale 1:50 © A1 Jan 2022 WLO/02G