



### As Built Ground Floor

1 : 100

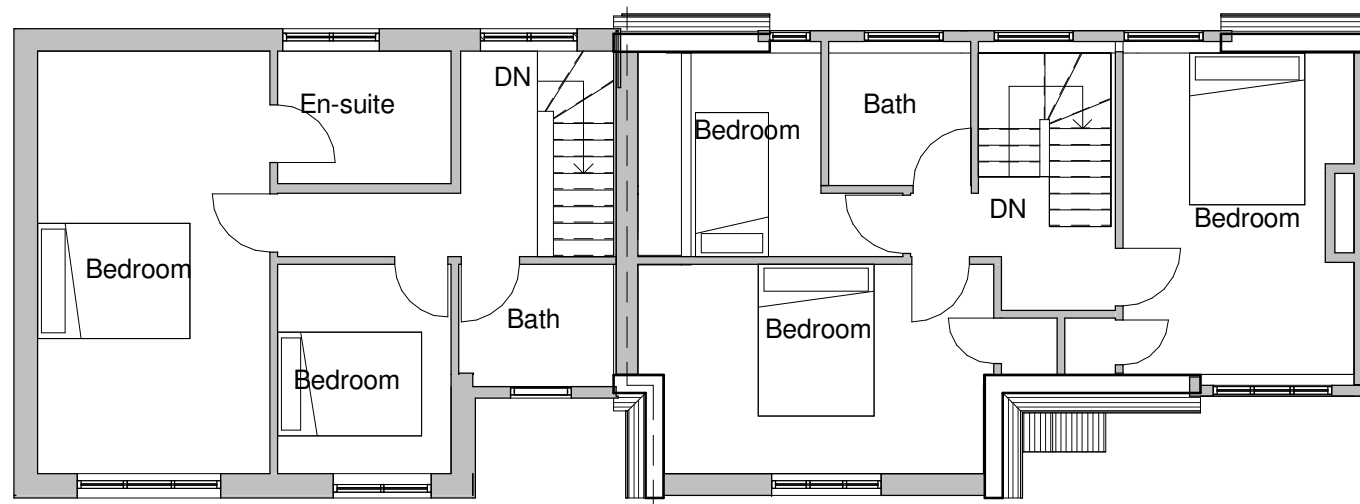

### As Built First Floor

1 : 100

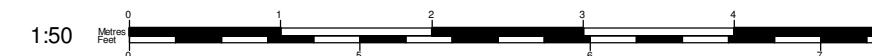

Tel: 01243 908064  
www.yourhomeplans.co.uk



These drawings are for approval purposes. Materials and products should not be ordered based on scaling from drawings as errors may occur along existing building lines. All measurements and supporting elements are to be checked on site. Refer to Your Home Plans if any discrepancies are found.

Mr & Mrs Thompson  
Copper Beech  
Church Lane  
Birdham  
West Sussex  
PO20 7AT

### As Built Floor Plans

Project number	COPPER-23	<b>A104</b>
Date	17th October 2023	
Drawn by	June Grinstead	
Checked by	Checker	
Scale A3		1 : 100