




As Built South West Elevation

1 : 100

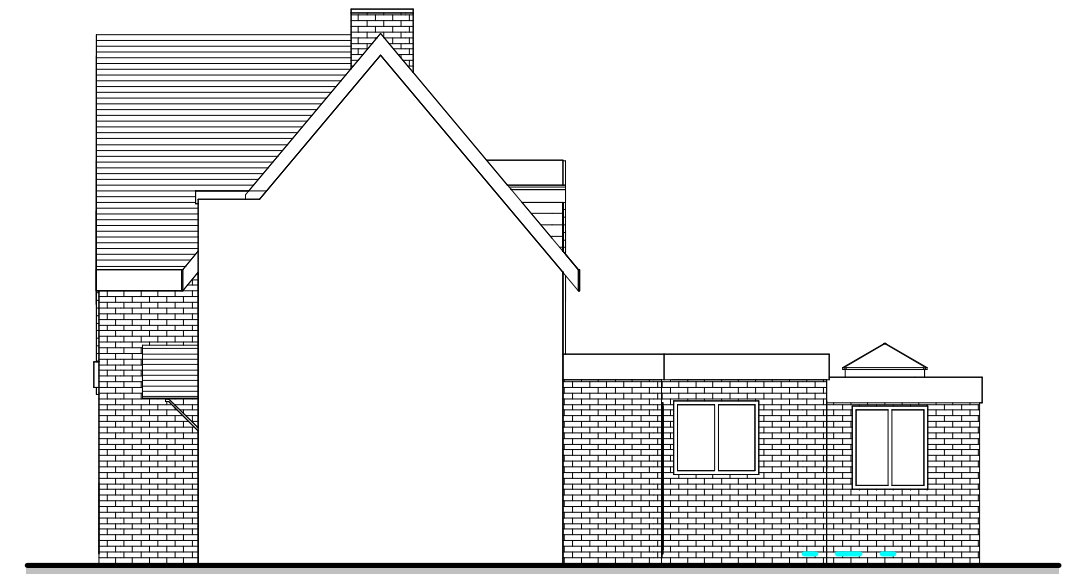


As Built South East Elevation

1 : 100



As Built North East Elevation

1 : 100

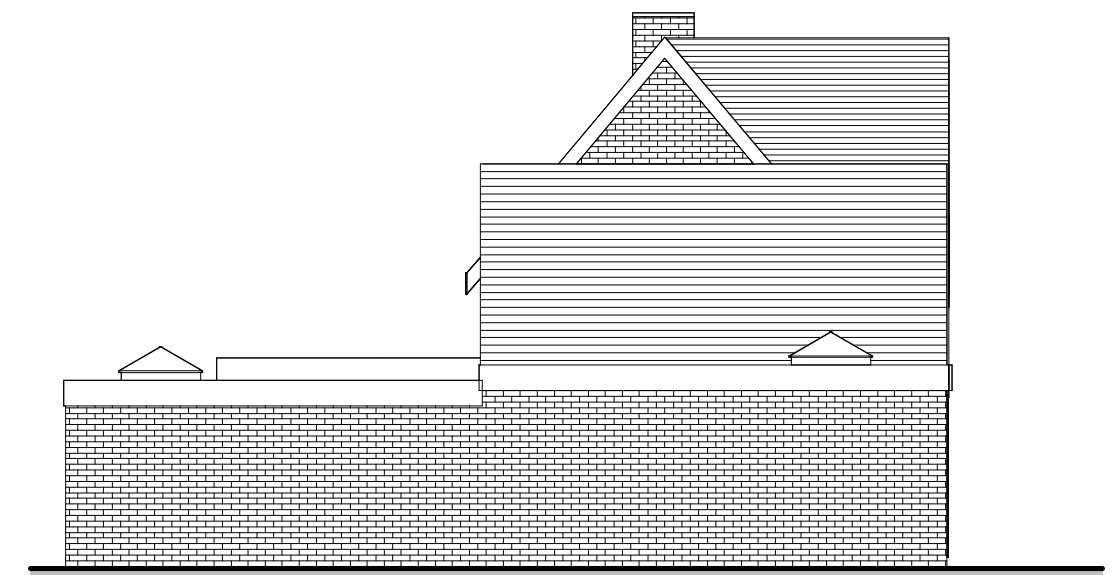

As Built North West Elevation

1 : 100

