




**HOMES DESIGN**


40 WISE LANE  
MILL HILL  
LONDON NW7 2RE  
MOB: 07946 872537

www.homesdesignltd.co.uk


title AS BUILT ELEVATIONS & SECTION	
project 93 ORBITAL CRESCENT WATFORD WD25 0HB	
drawing no ABC224/8001	
drawn by R. L	contract no. ABC224
scale 1:100 @ A3	date 11/2023

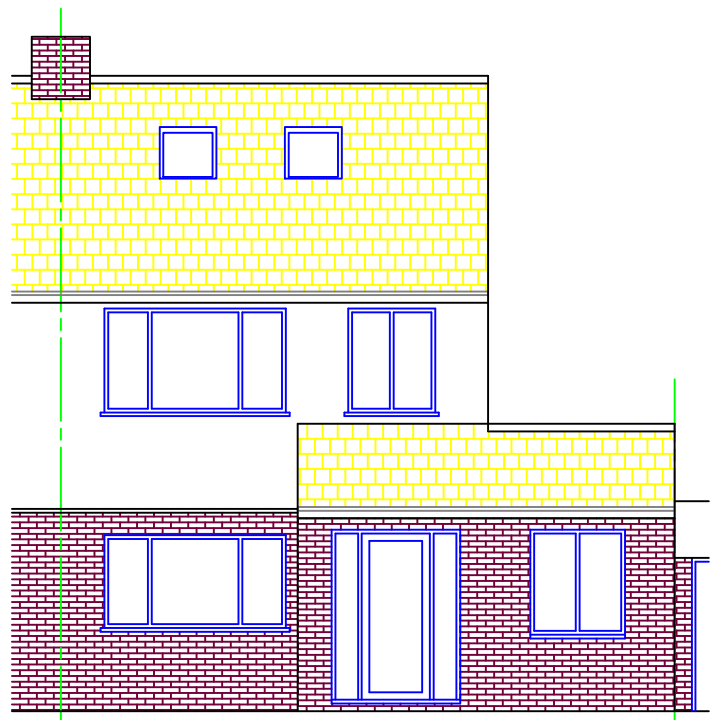


AS-BUILT FRONT ELEVATION

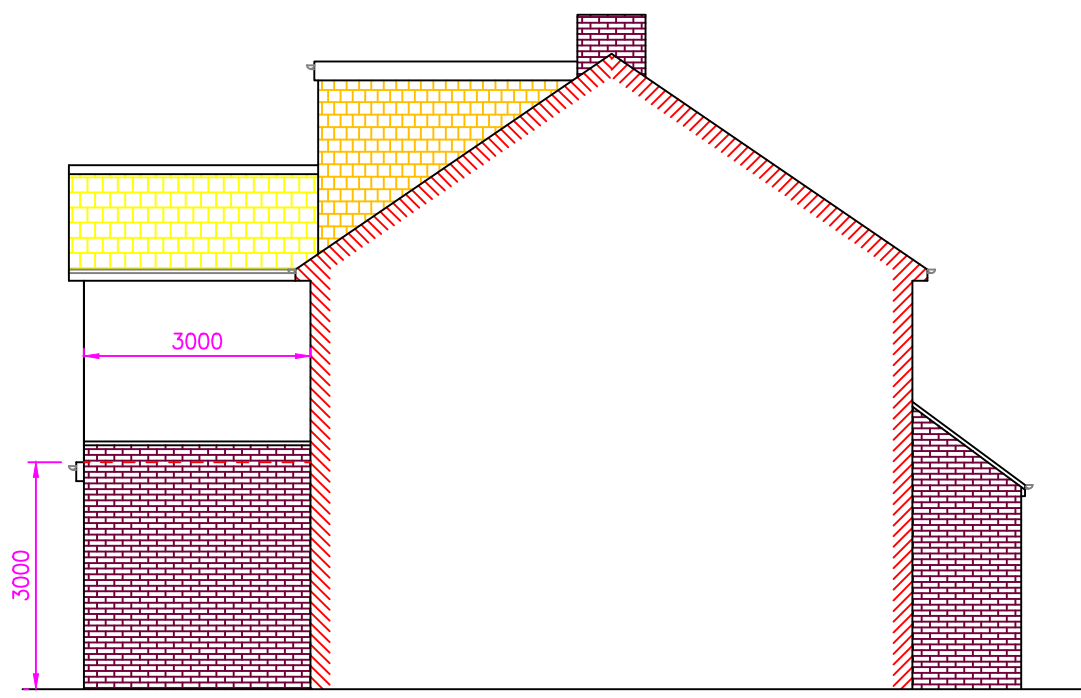


AS BUILT SIDE ELEVATION

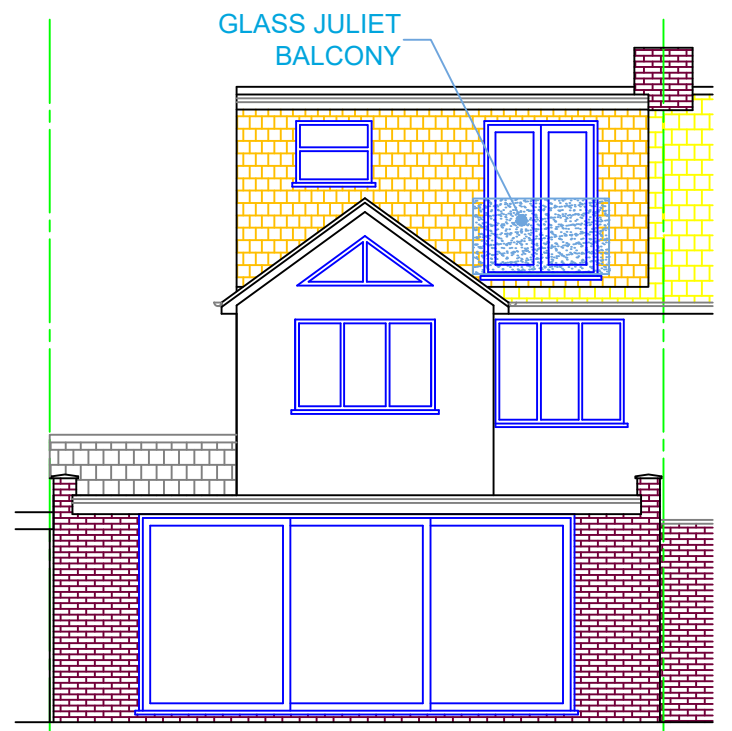

AS BUILT REAR ELEVATION

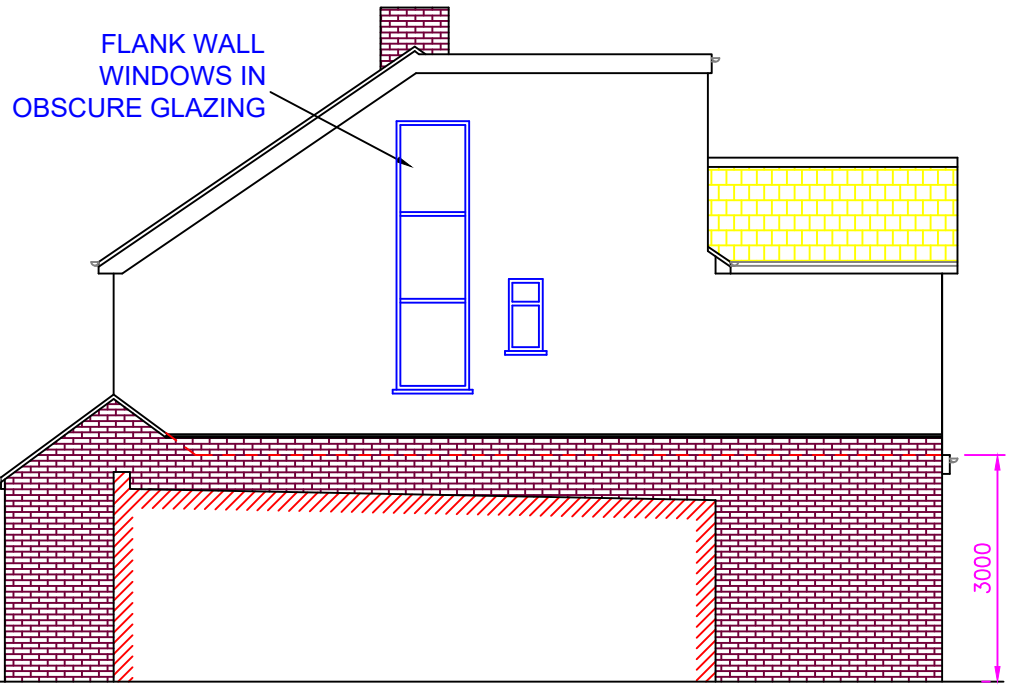

AS BUILT SIDE ELEVATION

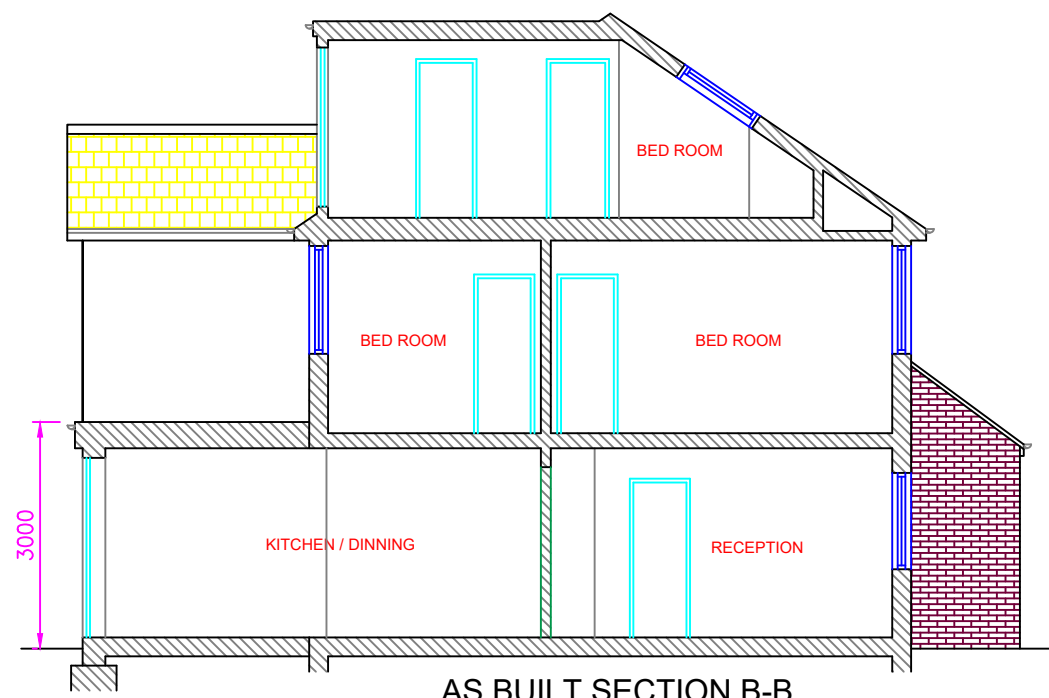

AS BUILT SECTION B-B

