


Proposed As Built Elevations & Floor Plans "Plot 1", Windmill House, Bucks Lane, The Street,
Ramsey, Essex. CO12 5HW
DWG REF - Revised House PlansV1






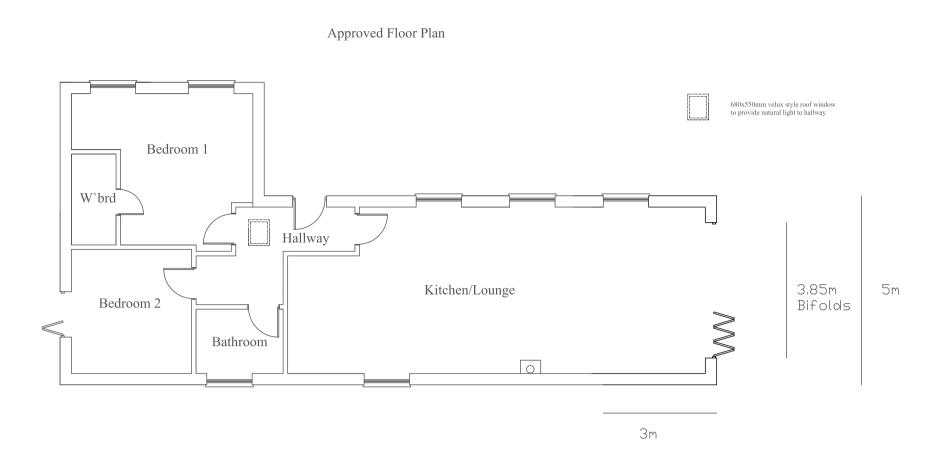

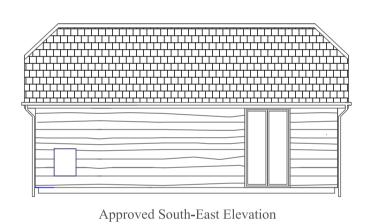


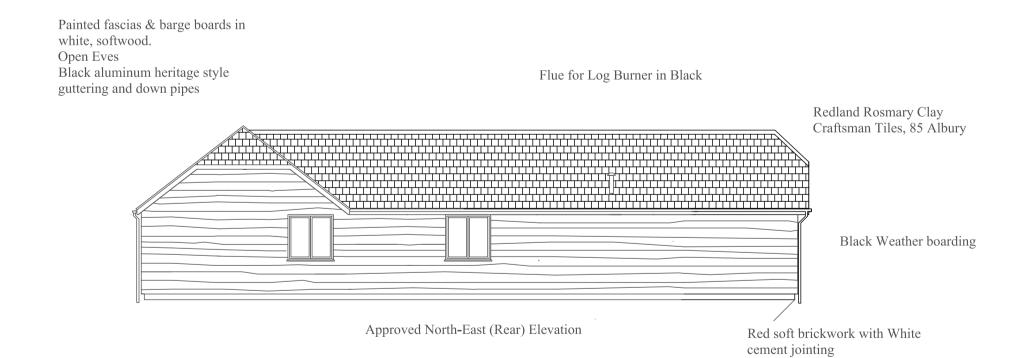


Oak framed glazed gable end.

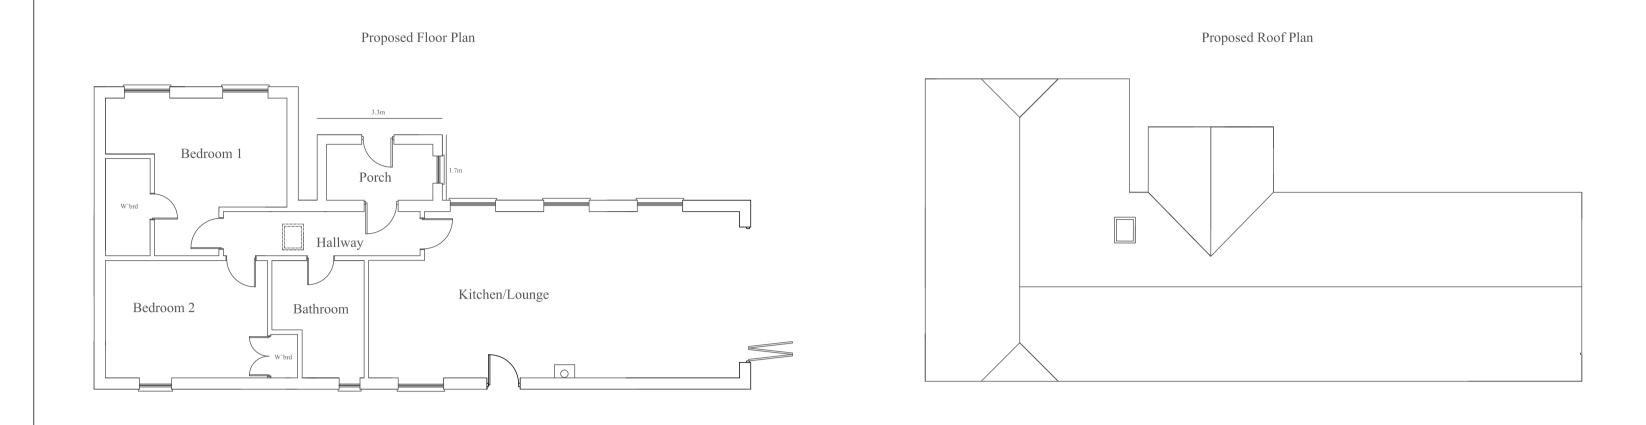




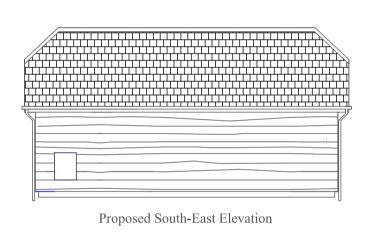

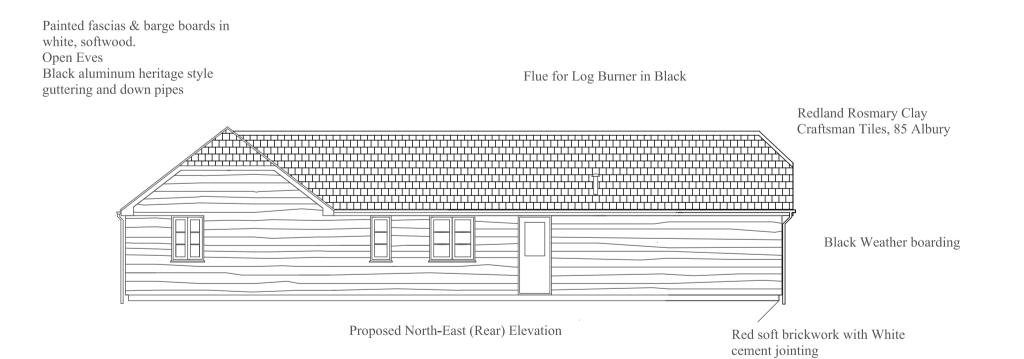



Oak framed glazed gable end.

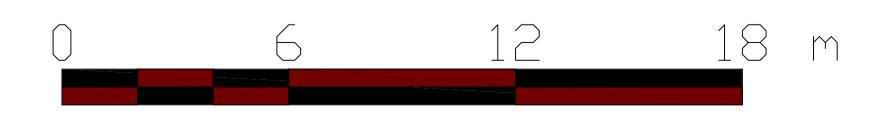

1:100 @ A1