



Amendments/Notes

Rev.	Description	Date	Issued by
P1	Issued for Planning	16/01/2023	MBT
P2	Wider context outlines added	21/03/2023	MBT
P3	Stone surrounds added to some windows on front elevation	08/11/2023	MBT

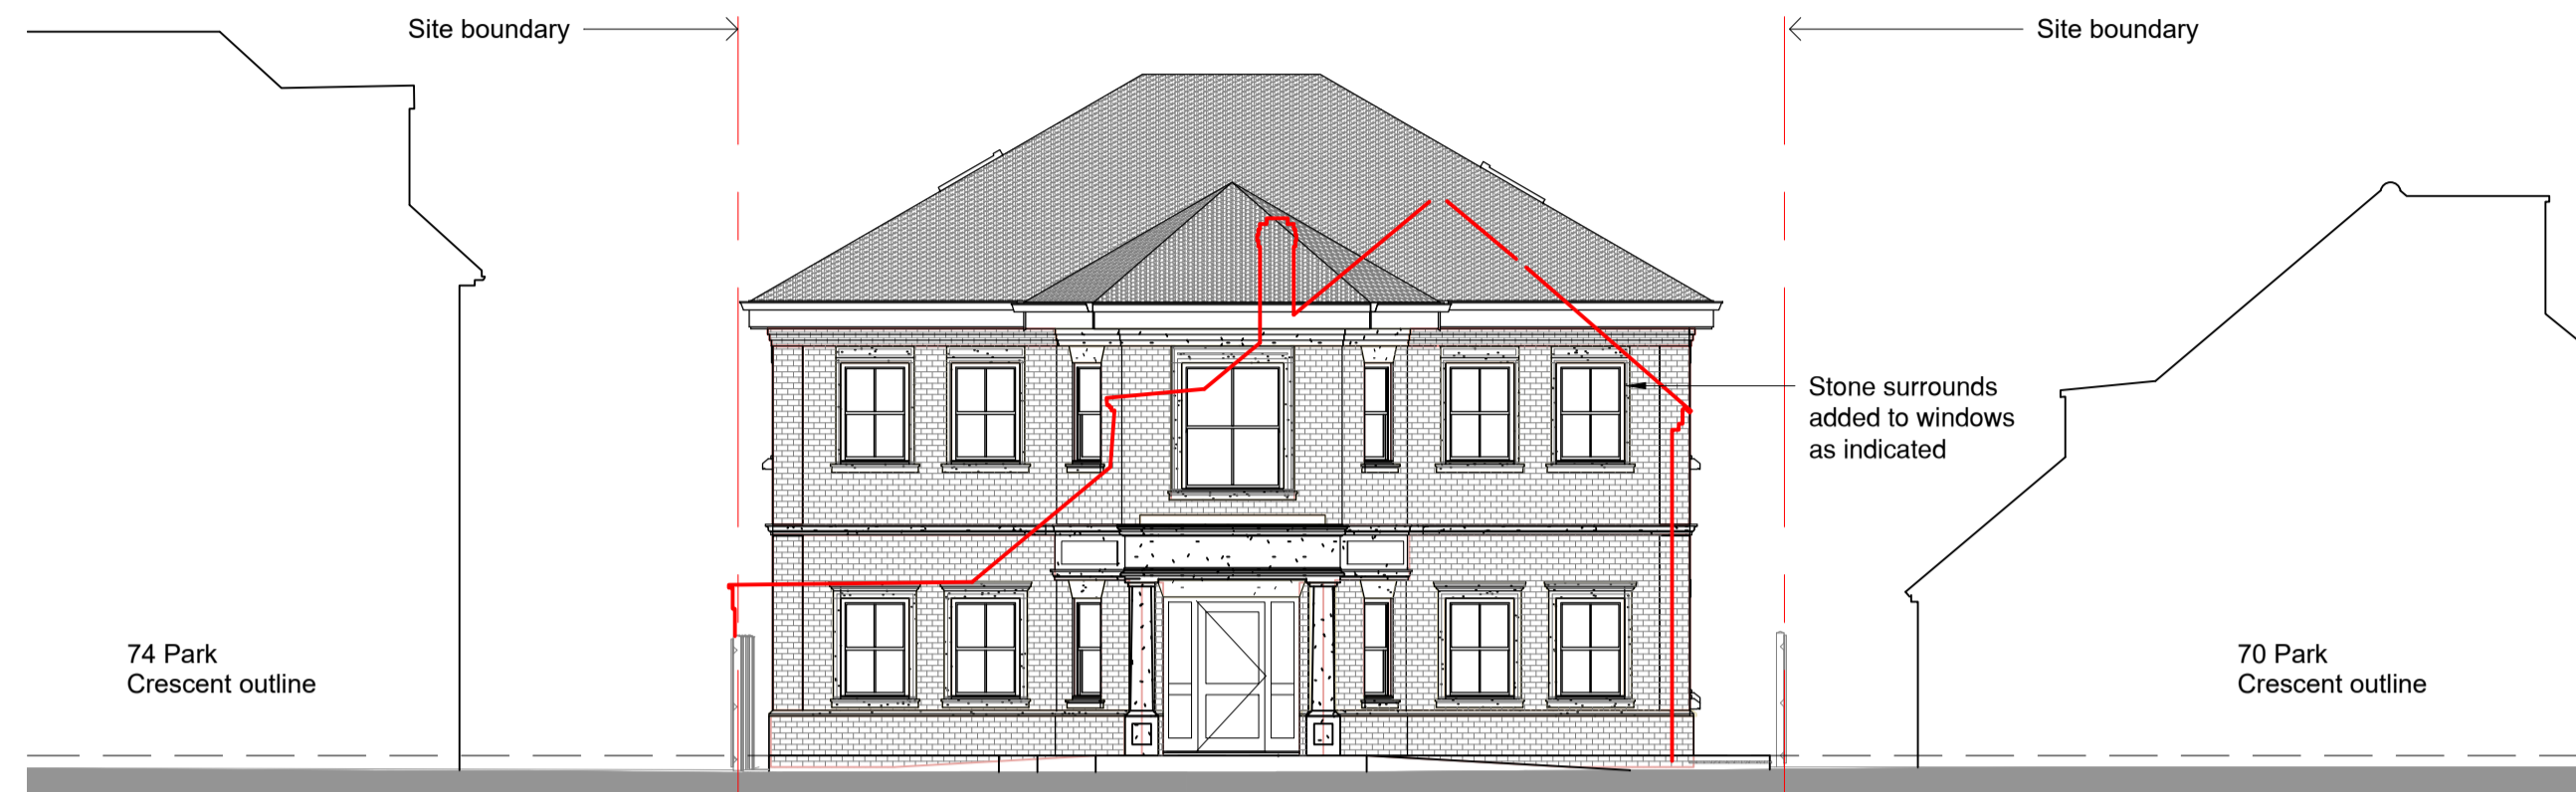


1 Proposed front elevation
1 : 100

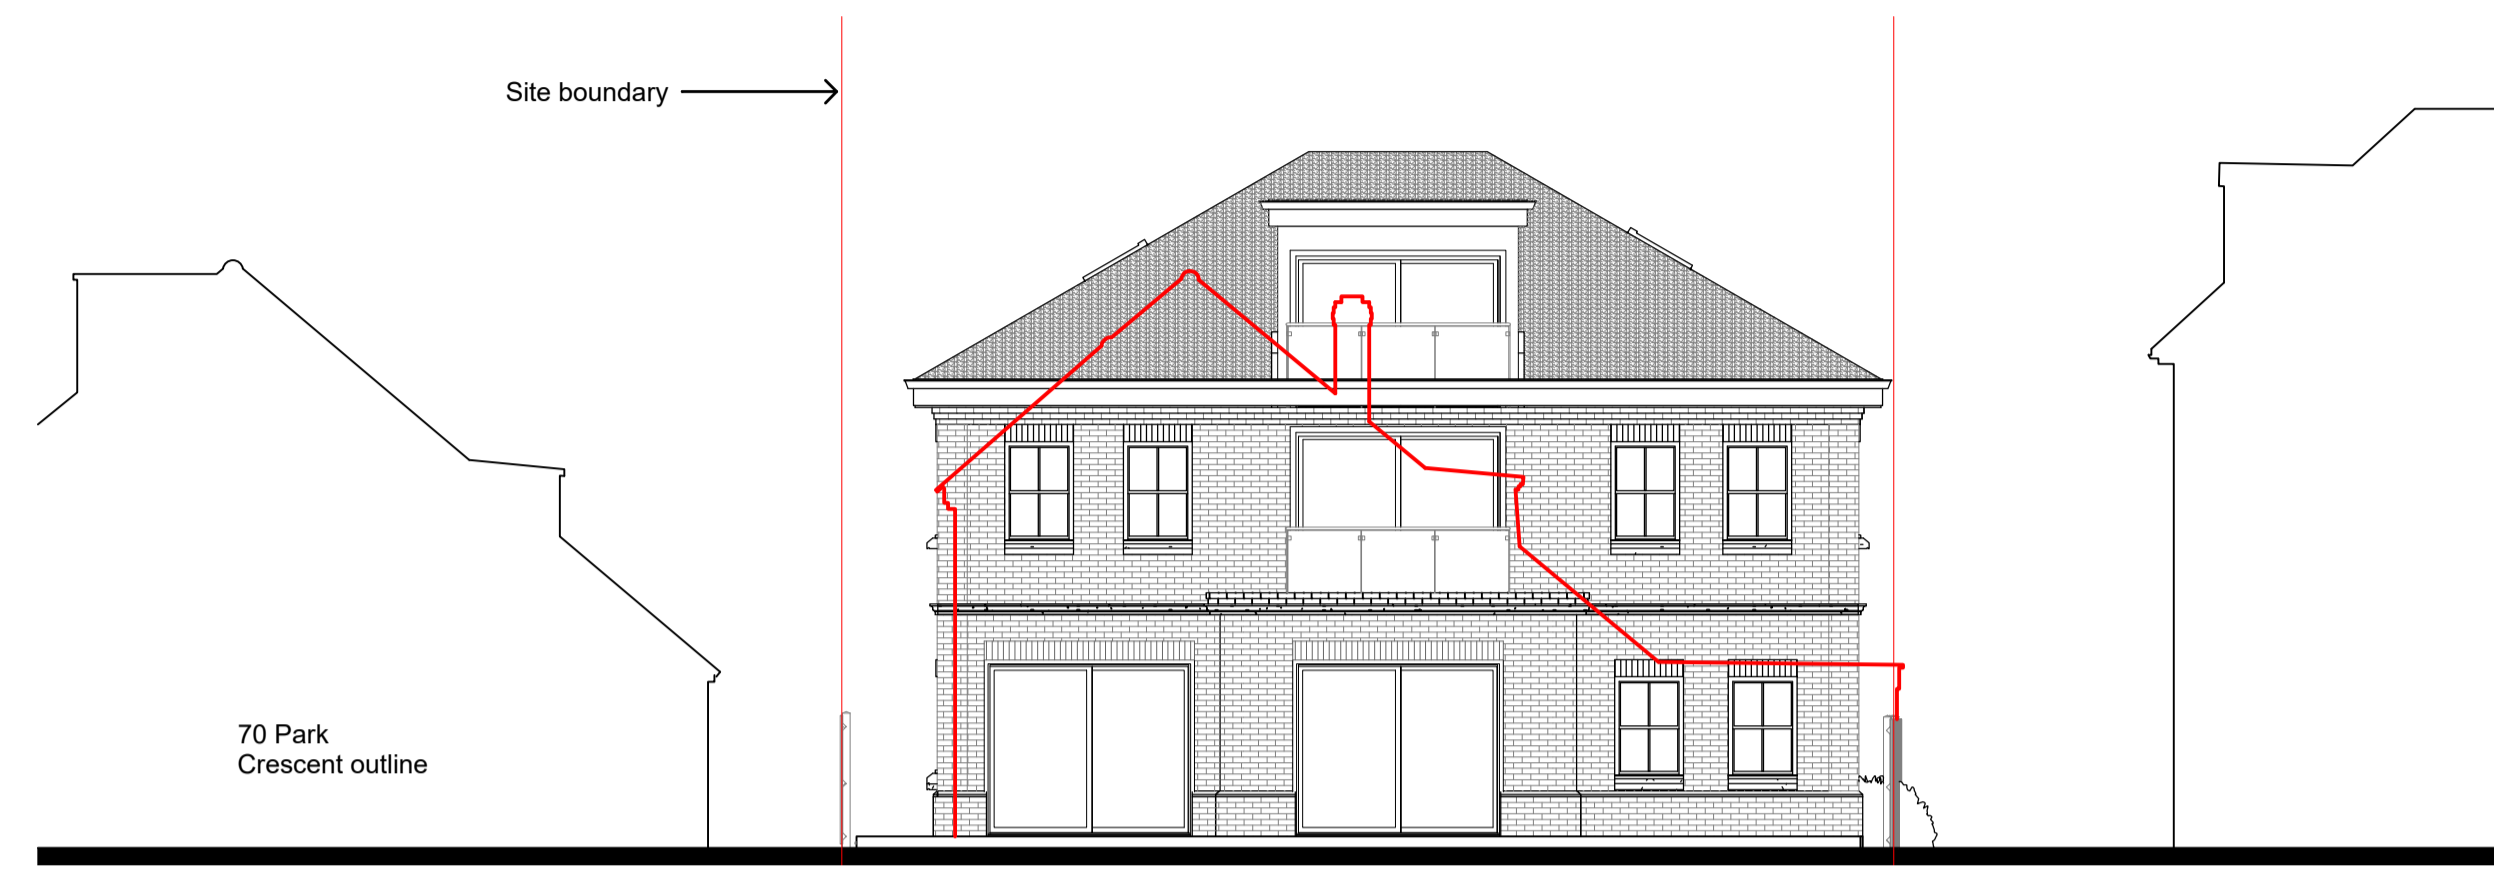

2 Proposed rear elevation
1 : 100



4 Proposed east side elevation
1 : 100

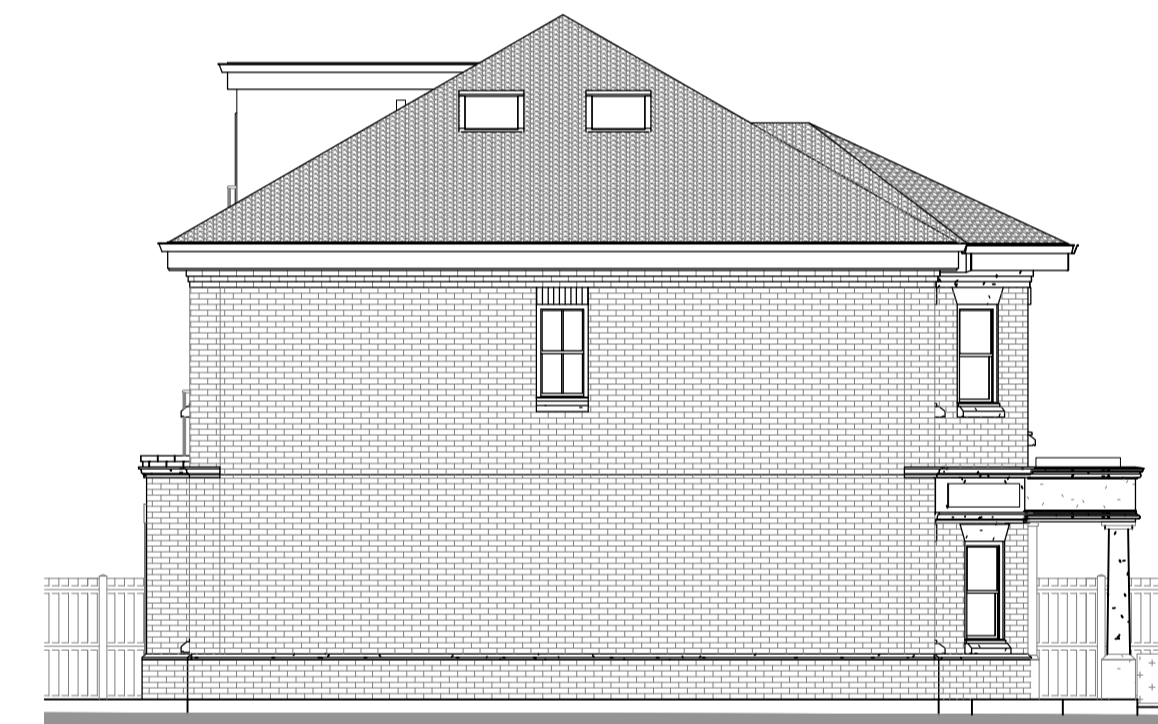

3 Proposed west side elevation
1 : 100



5 Proposed section AA
1 : 100

General Notes

All dimensions and levels to be checked on site by contractor prior to preparation of shop drawings and commencement of work on site.

Dimensions MUST NOT be scaled from this drawing for construction purposes.

This drawing and the copyrights and patents therein are the property of Micasa Architects and Micasa Interior Architecture and may not be used, reproduced or distributed without consent.

This drawing has been produced for the client for the project on the site shown. It was prepared for a purpose agreed with the client and will have a commensurate degree of accuracy. It is not a record "as built". This drawing is not intended for use by any other person or for any other purpose than that specified here. Micasa Architects and Micasa Interior Architecture accept no liability whatsoever if this drawing is used by any other person or for any other purpose.

This drawing is to be read in conjunction with all relevant consultants and / or specialist's drawings / documents and any discrepancies or variations are to be notified to Micasa Architects and Micasa Interior Architecture before the affected work commences.

All works on site are to be carried out fully in accordance with current CDM regulations and recommendations, current Building Regulations, British Standards and Codes of Practice as appropriate.

Notes specific to Interior Architecture (additional to the above)

All dimensions to be checked on site prior to installation / building / fitting and discrepancies reported to the project lead.

Interior Architecture design details shown on this drawing are for approval purposes.

This drawing must be signed, approved and accepted as correct by the client before the project progresses.

Status: **PLANNING**

Project: **Replacement dwelling
72 Park Crescent,
Elstree, WD6 3PU**

Client: Private Client

Drawing: **Proposed elevations**

MICASA

Chartered Architects
Interior Architecture



8-10 Rowland Place | Green Lane
Northwood | HA6 1AB
01923 827070 | studio@micasagroup.co.uk

Scale: 1:100 @ A1 1:200 @ A3 Date: 10/01/2023

Zone: X	Drawn By: MBT	Discipline: AR
	Checked By: MBT	
Drawing No: 2208-PL-013		Rev: P3

