

All dimensions to be checked on site.

Do not scale dimensions from this drawing, use figured dimensions.


Refer to Engineer's drawings and specification for all structural and services information.

Any discrepancies between the Architect's and Engineer's drawings to be reported to the Architect immediately.


The survey information shown on this drawing is based on a survey prepared by a third party and NCA Architects accept no responsibility for the accuracy or completeness of the survey

These drawings have been amended to attain Record drawing status based on information received from the Main Contractor.


Note: Detailed design information for Various components / constructions are indicated on separate specialist sub-contractor drawings, & may supersede the information shown on this drawing.

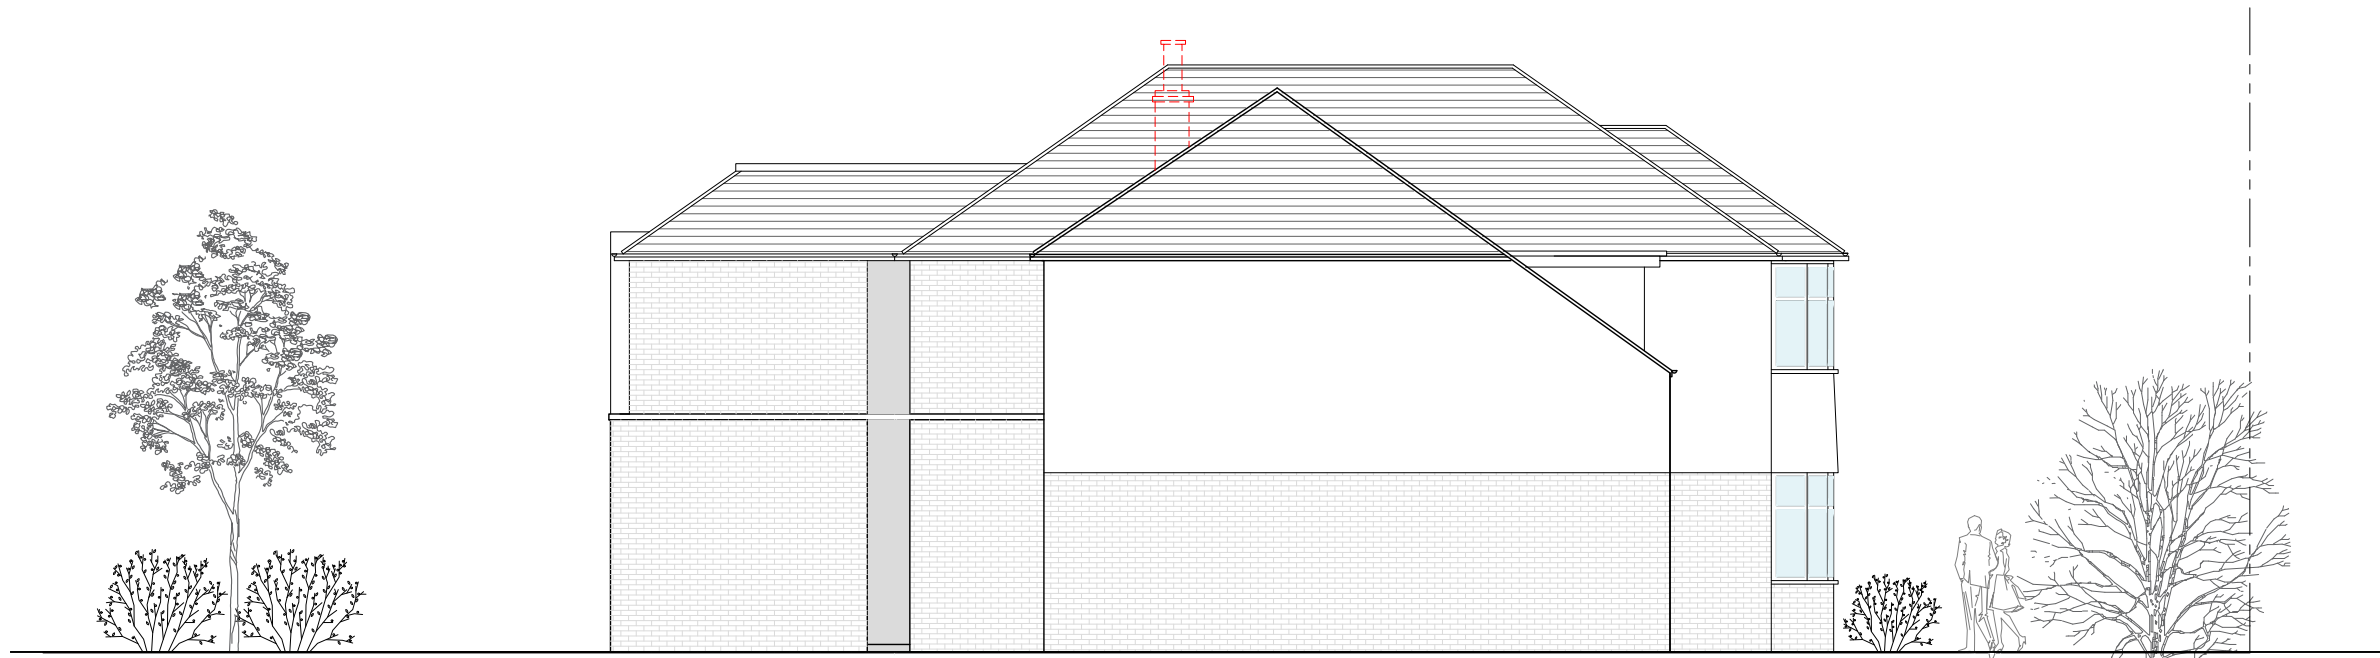


Elevation 01

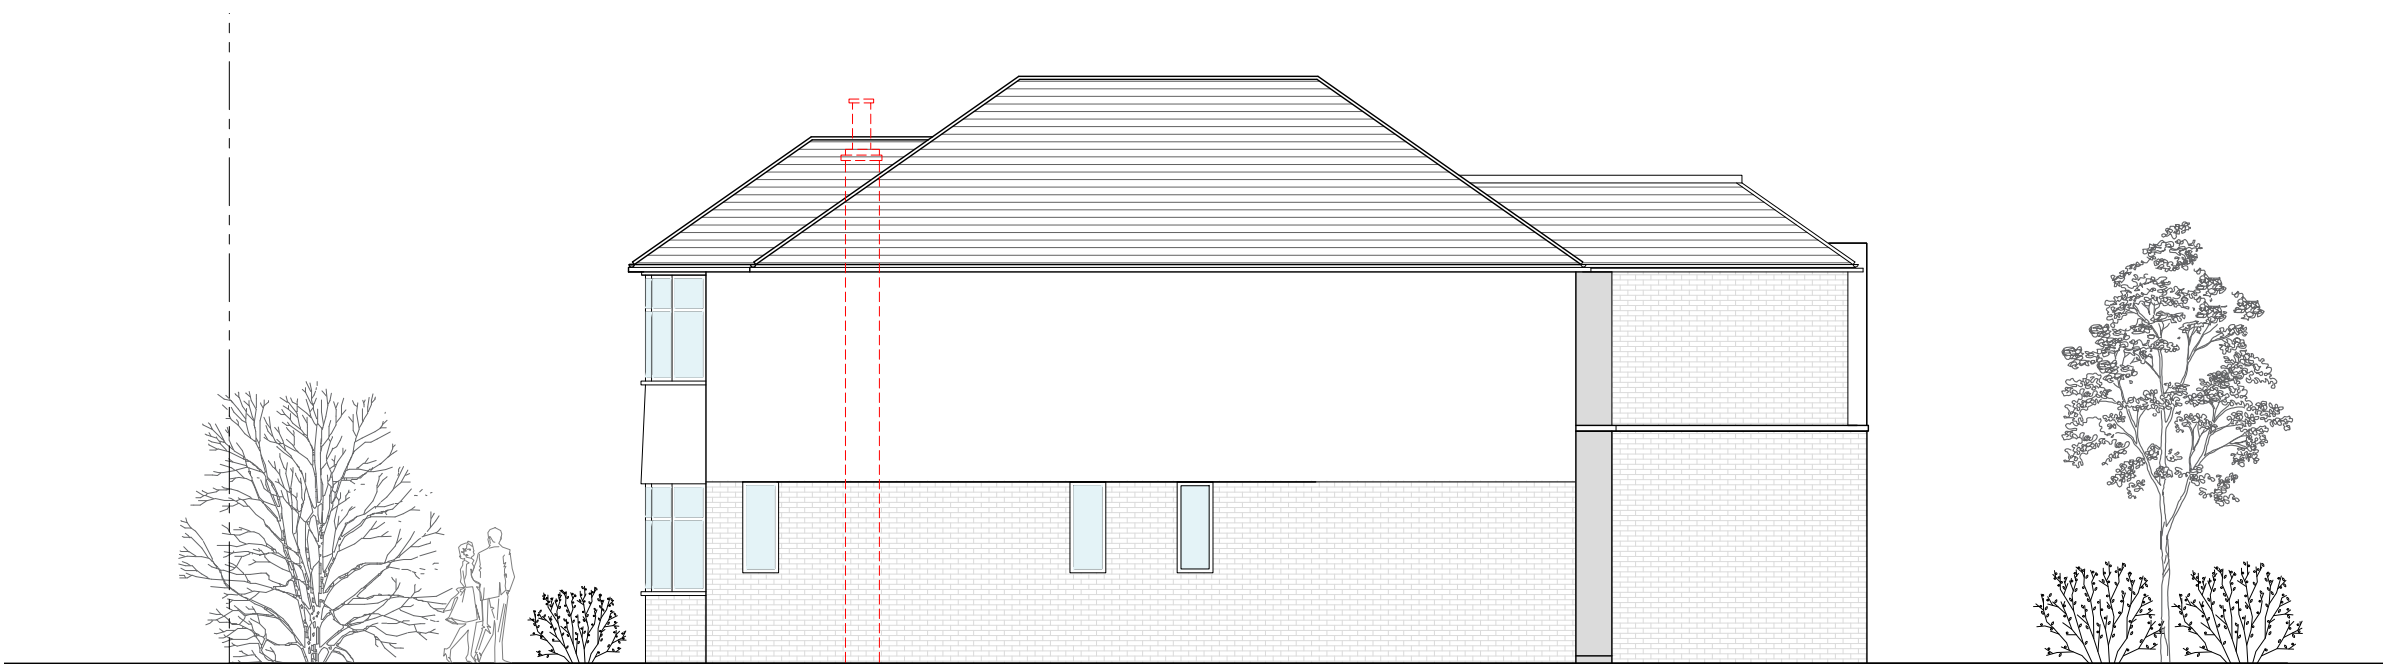


Elevation 02

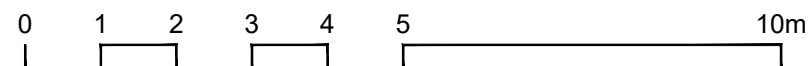


Demolished 

MATERIAL KEY:

Render: 

Composite wind. & doors: 

Brick: 

Roof tile to match existing: 

nca-architecture

tel: 01869 226610

email: enquiries@nca-architecture.co.uk
www.nca-architecture.co.uk

7 Court Farm Barns
Medcroft Road
Tackley, OXON
OX5 3AL

20 Kirk Close
Proposed Side Elevation
DRAFT

Date: **26.07.23**
Scale: **1:100@A3**
Status: **Preliminary**
Drawn: **DF**

230015 - A - Pr - 202

Revision: **/**