


PLAN

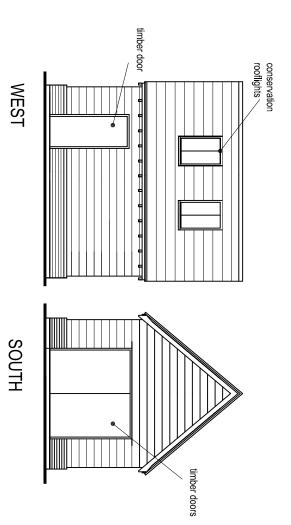

softwood timber boards stained

soft red bricks

EAST

NORTH

**BLOCK PLAN 1:500** 

Richard Beaty (Building Design) Limited
11A Thorncote Green,
Sandy,
Bedfordshire, SG19 1PU
Telephone and Fax 01767 627560

PROJECT:
4 Thatched Cottages, Norwich Road,
Dickleburgh Diss 1P21 4NR
Garage ( as built )

TITLE: Plans and Elevations	itions			
SCALES:	1:100	)		
DRAWN:		CHECKED:	DATE	DATE: Dec 21
DRAWING No:	21 21 11C	11C		

scale 1:100@A3