


DO NOT SCALE FROM THIS DRAWING

Rev.	Notes	Drawn	Date
0.2	CONSTRUCTION ISSUE	SJ	12/04/2016
0.3	Critical Dimensions added	SJ	15/04/2016
0.4	Stock room door kept as extg Frosted film to stock rm door Racking amended Extg door locked/screwed shut and decorated	SJ	25/04/2016
0.5	AS BUILT	SJ	31/05/2016

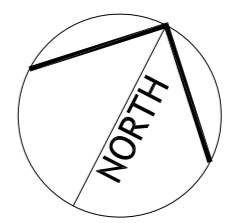

KEY

	FLOOR BOX FOR TILLS, CONTAINS DATA AND POWER
	TELEPHONE POINT
	DATA POINT
	CONDUIT IN EXTG PLY D TO CONTAIN CABLES
	60 MIN FIRE RESISTING WALL TO BACK OF HOUSE
	30 MIN FIRE RESISTING WALL TO ELECTRICAL CUPBOARD


NOTE: ALL WORKS SHOULD BE CARRIED OUT IN ACCORDANCE WITH BUILDING REGULATIONS 2010 AND APPROVED DOCUMENTS. ANY DEVIATION NOTED BETWEEN DRAWINGS AND REGULATIONS SHOULD BE BROUGHT TO THE ATTENTION OF THE ARCHITECT.

FOR ALL SERVICES INCLUDING MECHANICAL, ELECTRICAL, AND LIFE SAFETY SYSTEMS REFERENCE SHOULD BE MADE TO SPECIALIST SUB CONTRACTOR DRAWINGS.


Existing structure/walls
NOTE: NO DEMOLITION OF EXISTING WALLS OR STRUCTURE IS PROPOSED

Proposed new lightweight partition walls

Note: secured shared w.c. facilities are provided for staff in the LL demise to the rear of the unit on the ground floor

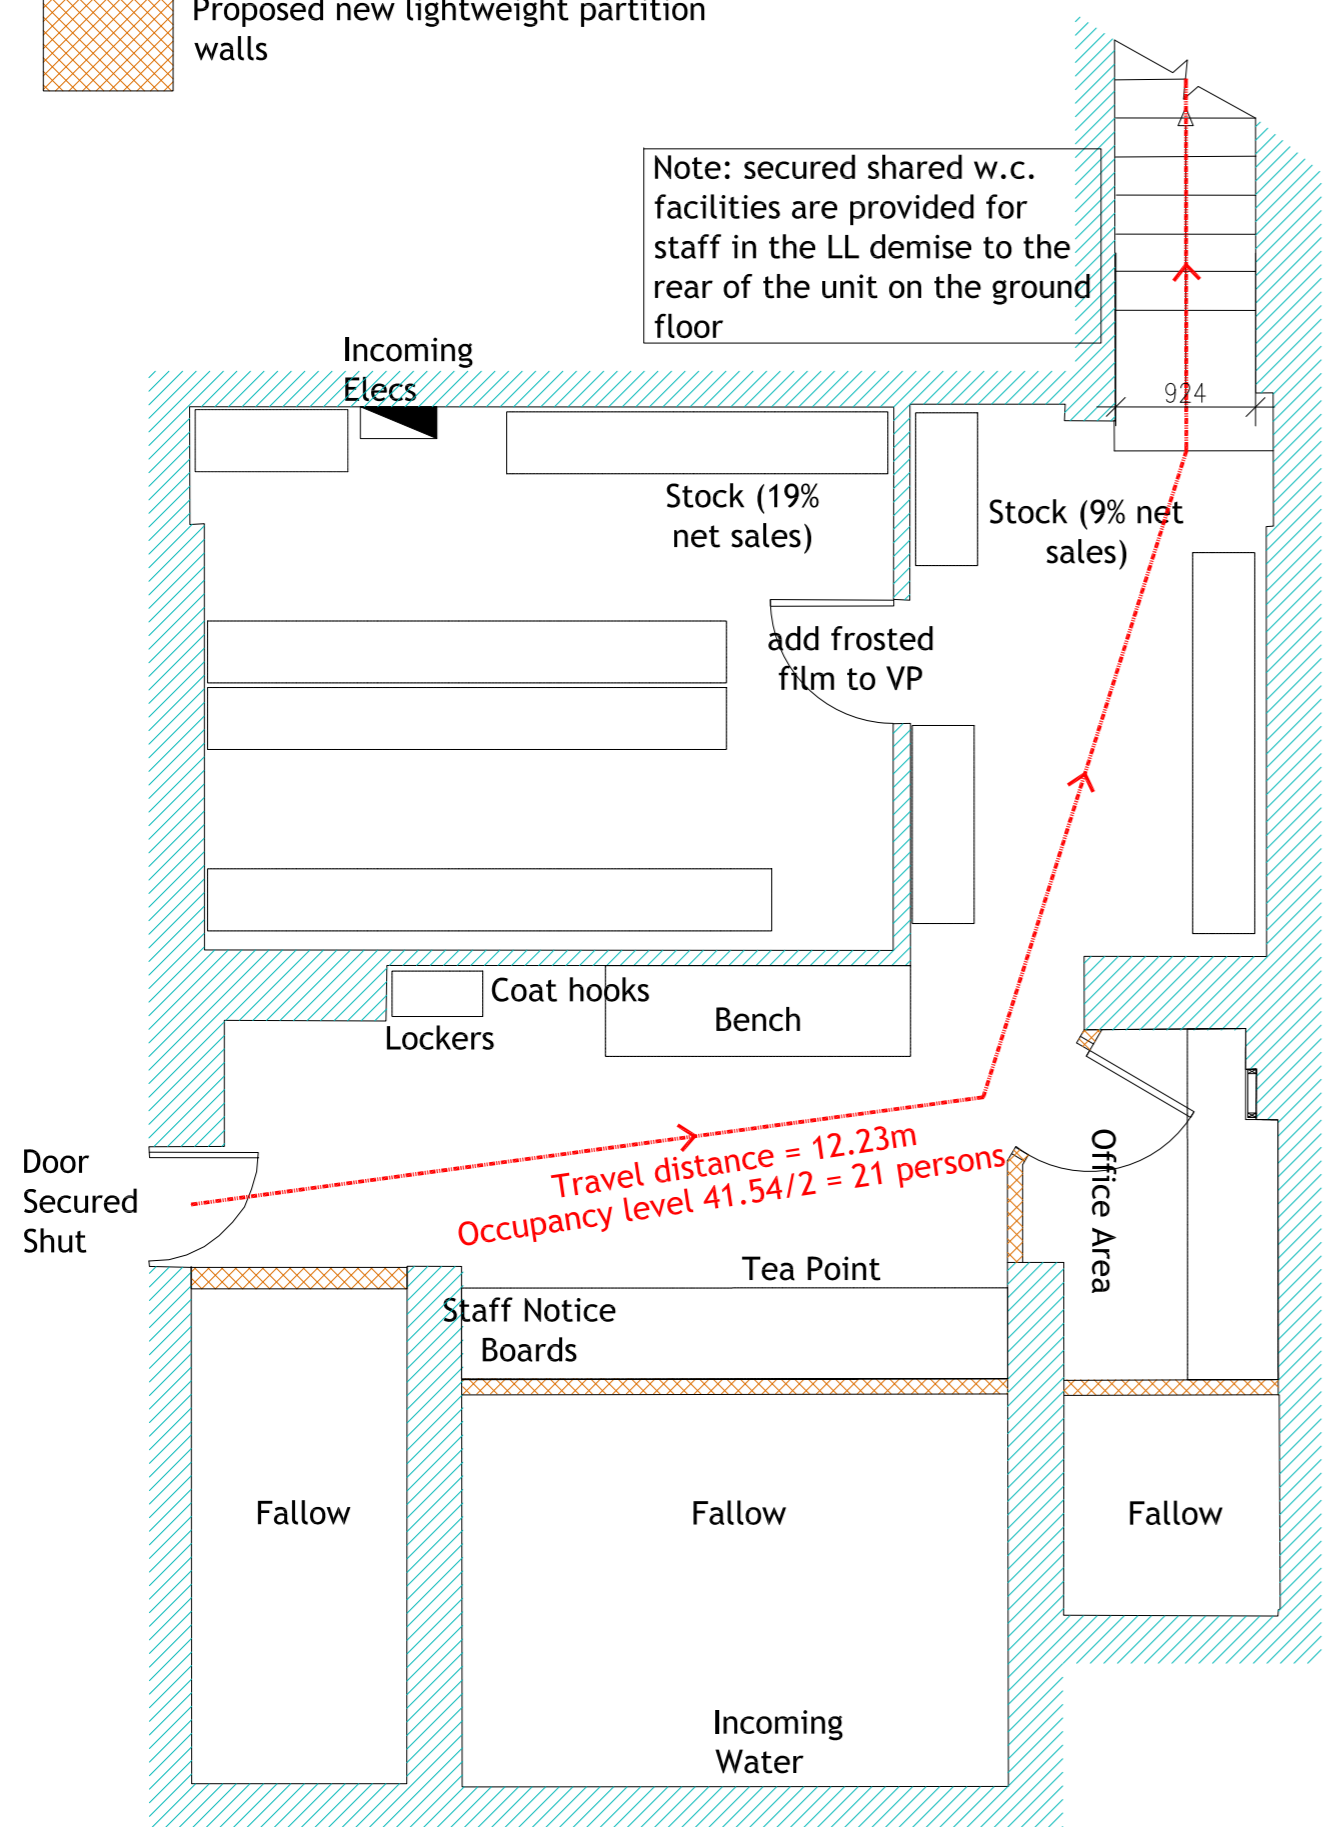

BASEMENT PLAN

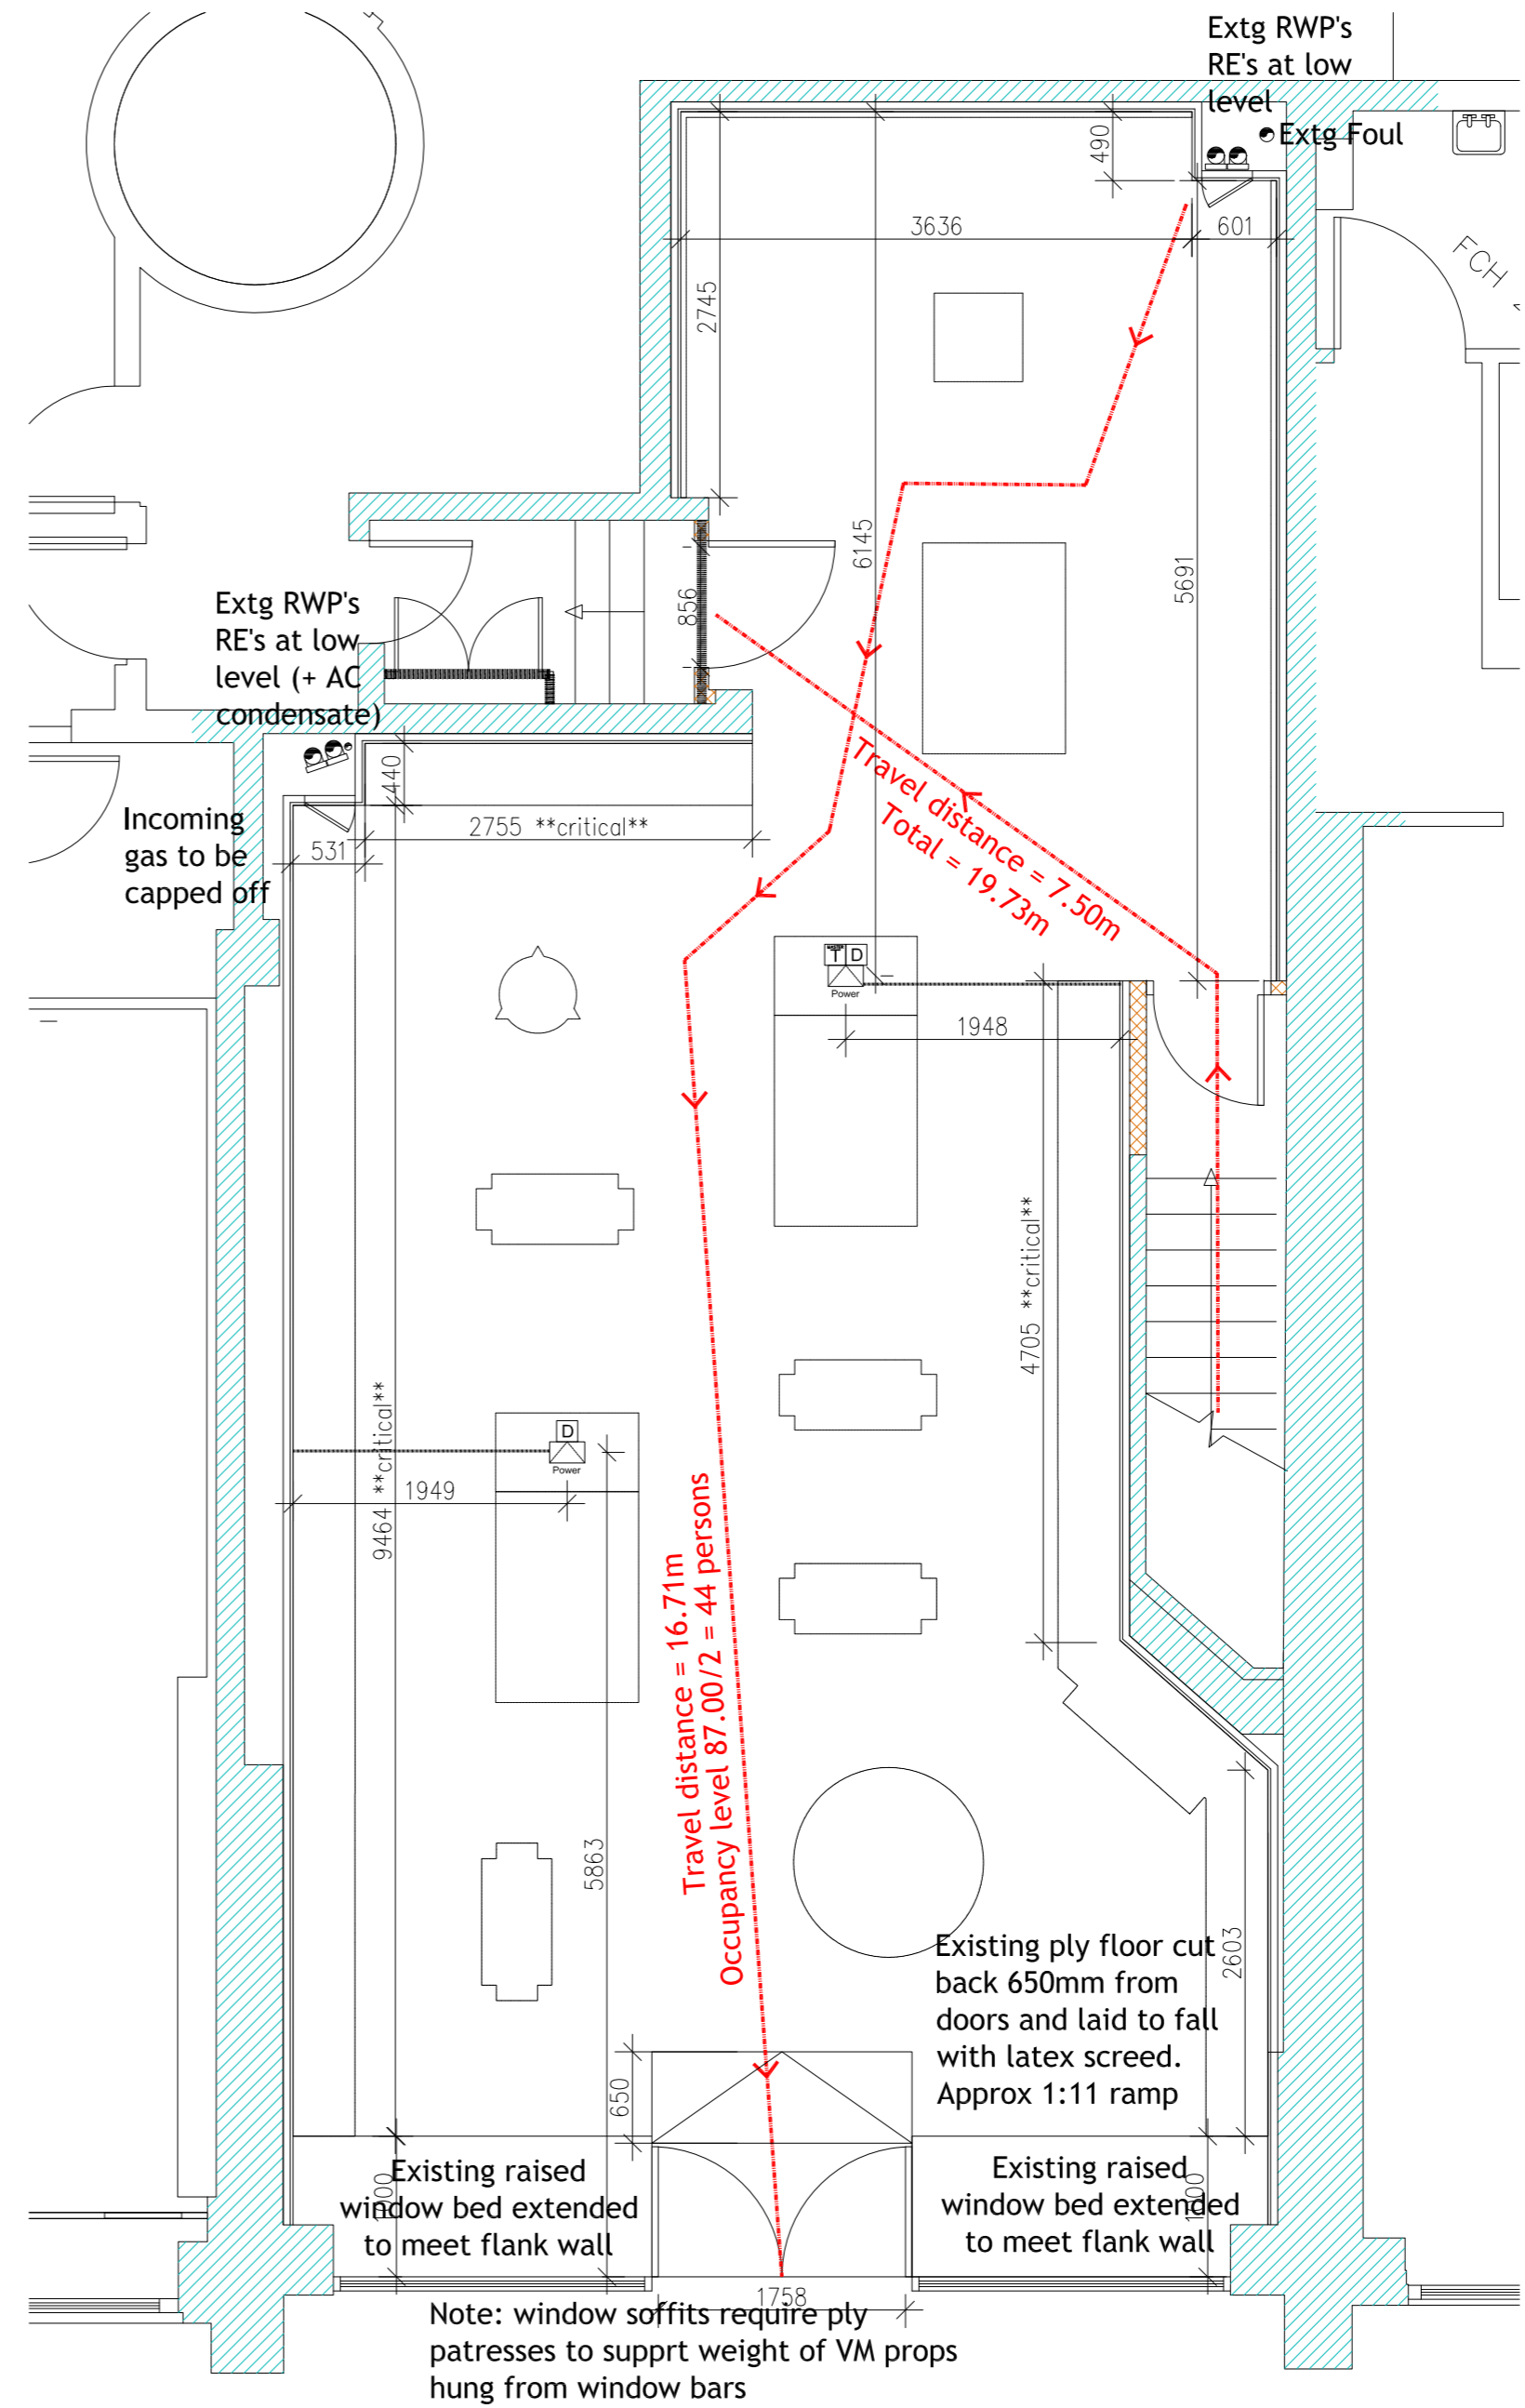

GROUND FLOOR PLAN

MONSOON
Accessorize

Notting Hill Village, 1 Nicholas Road,
London, W11 4AN
020 3372 3183 020 3372 3007
sjones@monsoon.co.uk

Henry Mein Partnership
Architects
12 Clarendon Street
Nottingham
NG1 5HQ
t: 0115 9476065
f: 0115 9240136

Site Address
4112
STRAND ACCESSORIZE
443 THE STRAND

Drawing Name
EXISTING
LAYOUT - GND & BMT
AS BUILT

Drawn Date 07/12/2015 Drawn By SUE JONES

Scale(s) 1:50 @ A2

Drawing Number HMP_STRAND(A)_GA_L001

© Copyright Monsoon Accessorize Ltd