


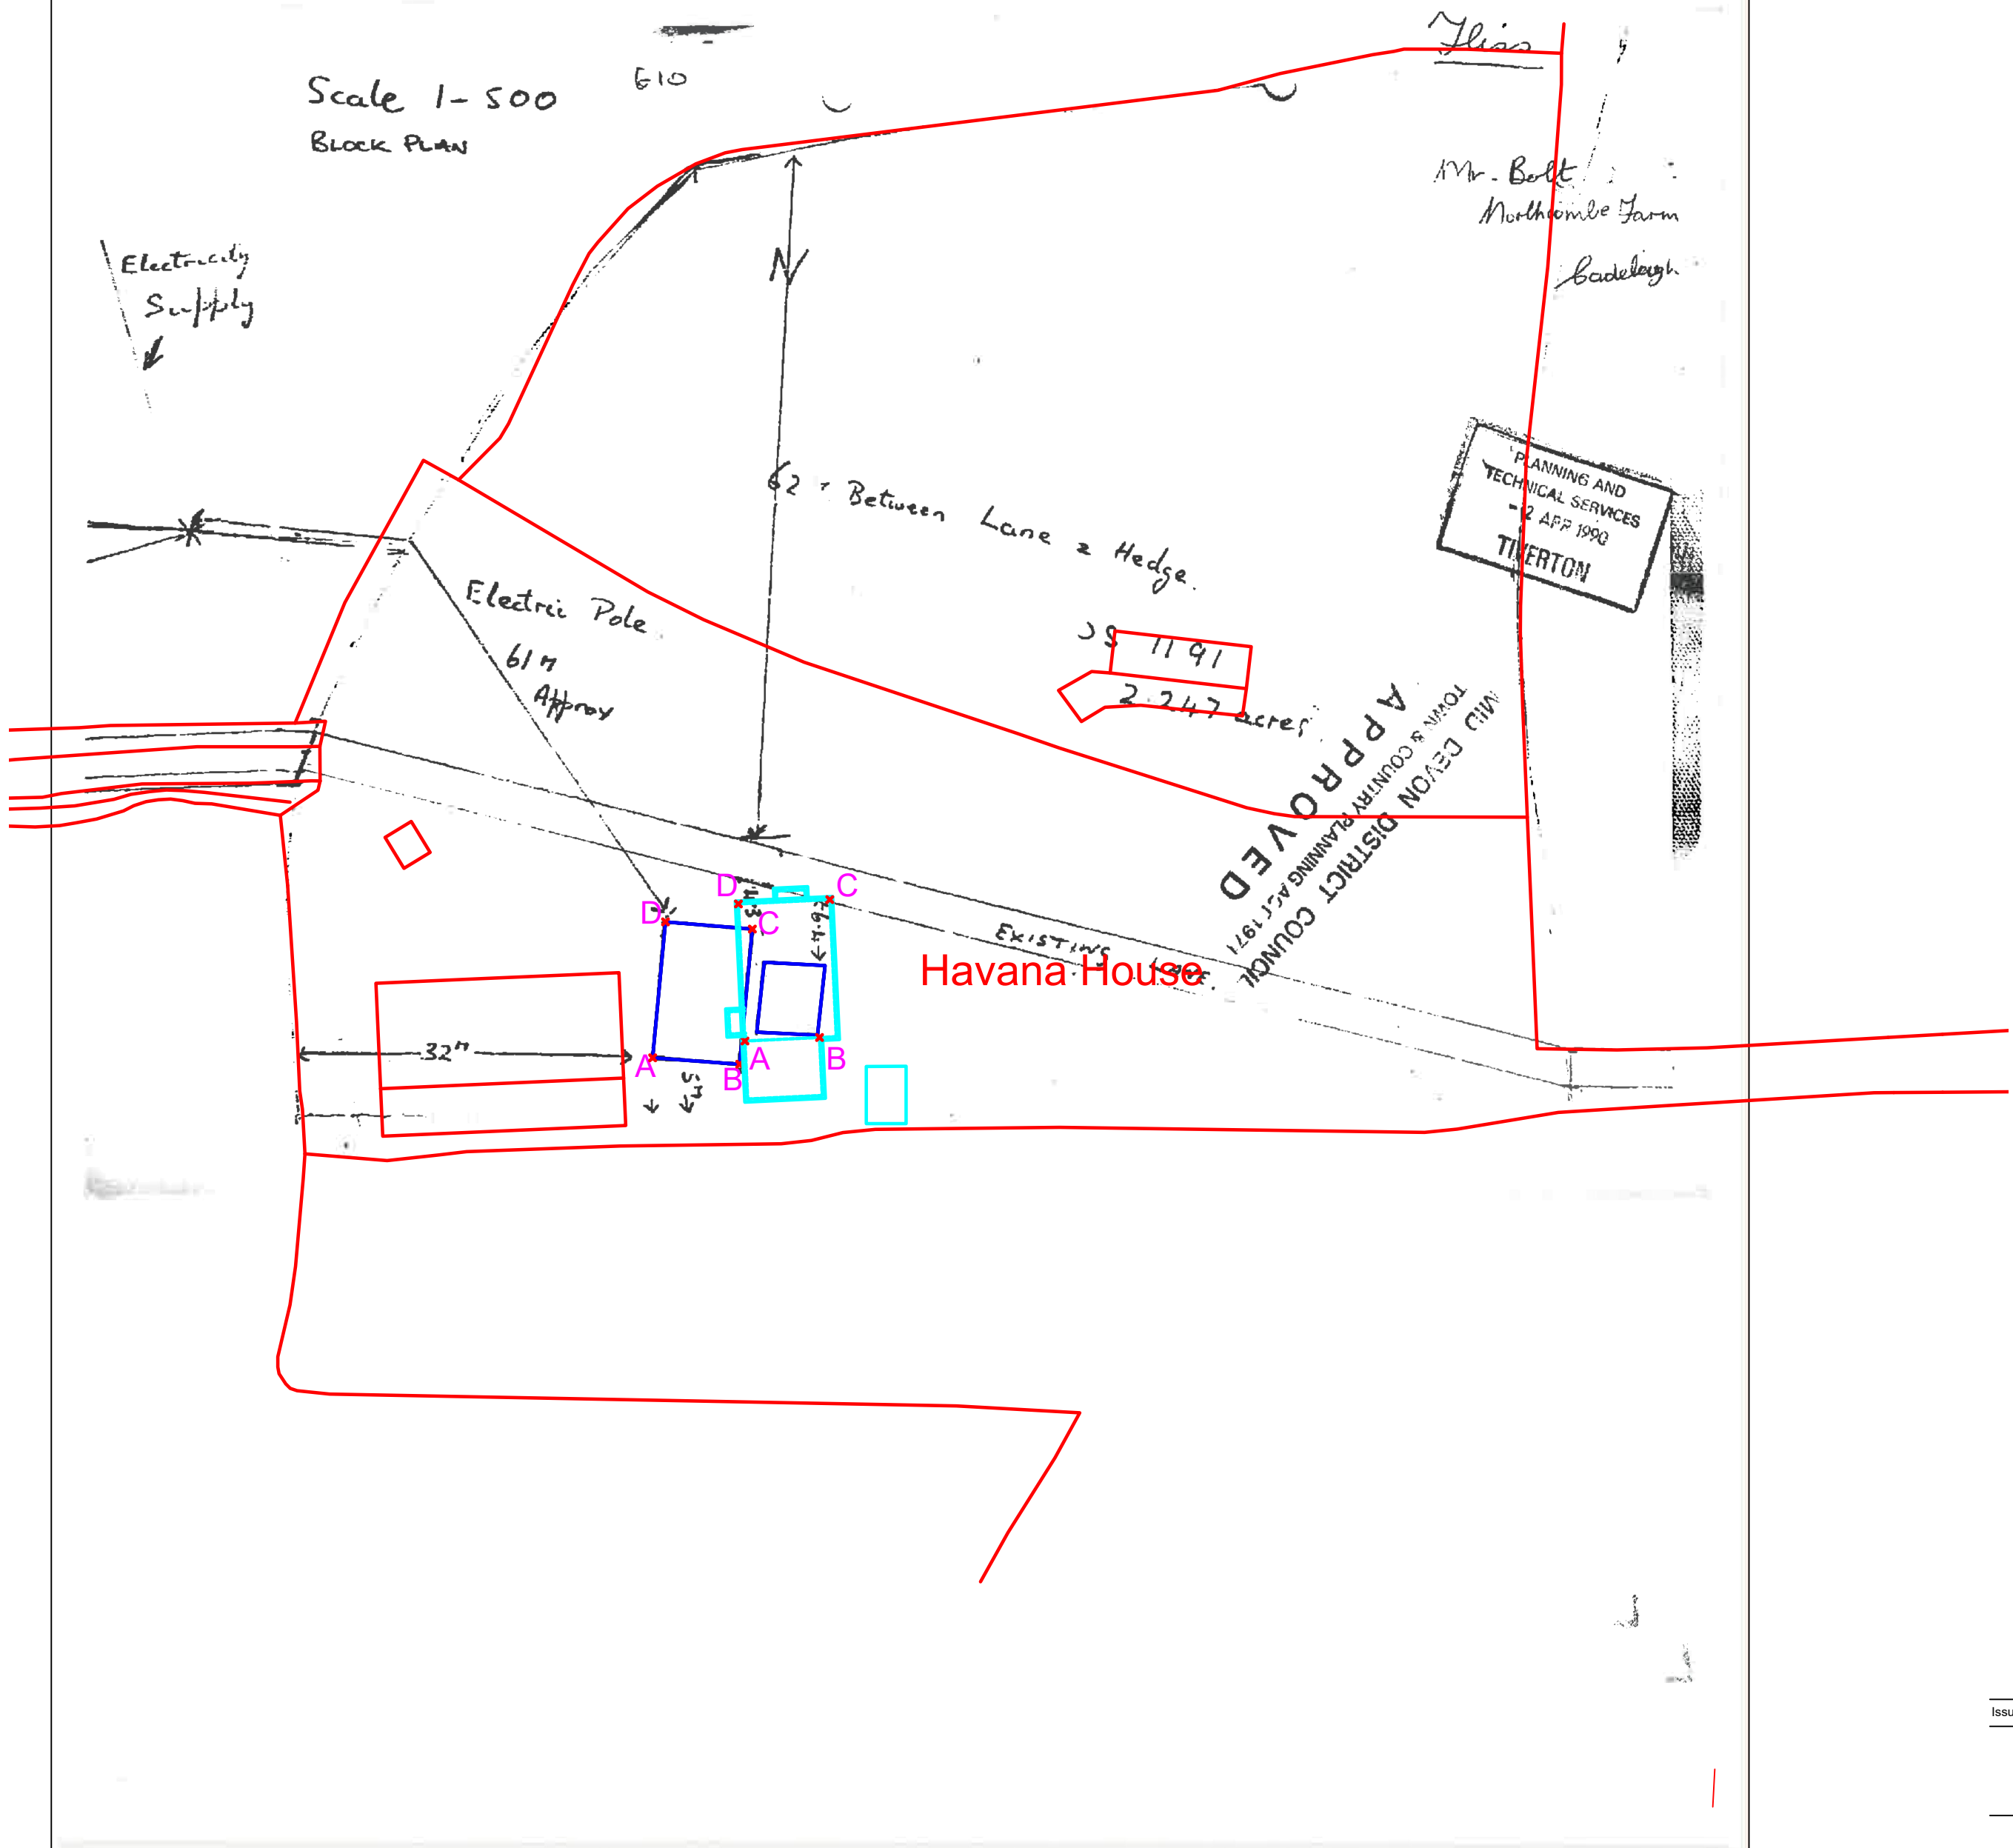

Scale 1-500
Block Plan



Issue	Date	Revision

Acorn
RURAL PROPERTY CONSULTANTS

1b Oaklands Court, Tiverton Business Park,
Tiverton, Devon, EX16 6TG
T: 01884 212380

Client
Mr & Mrs Bolt
Site
Havana House
Cadeleigh
Tiverton
EX16 8HT

Project
Certificate of lawfulness for dwelling (use class C3) with unrestricted occupancy - dwelling free from the encumbrance of the planning conditions attached to planning permission 4/12/90/610

Title
Mastermap OS data and position of built dwelling overlaid on extract from block plan stamped approved and dated 2 April 1990

Drawing No. ARPC3 Issue:
Scale 1:500 (A2)
07 August 2023

Copyright Acorn Rural Property Consultants 2023
Ordnance Survey Crown Copyright 2023. All rights reserved. Licence No. 100022432
E&O.E
For submission with planning application.

Key

- Mastermap Ordnance Survey data.
- As approved location of dwelling and garage from planning permission reference 90/000610/FULL.
- Dwelling as built drawn using geotagged aerial photography and survey measurements.

Measurements

- A - A = 8.4 metres
- B - B = 7.5 metres
- C - C = 7.4 metres
- D - D = 6.7 metres

