




**GROUND FLOOR PLAN
(AS BUILT)**

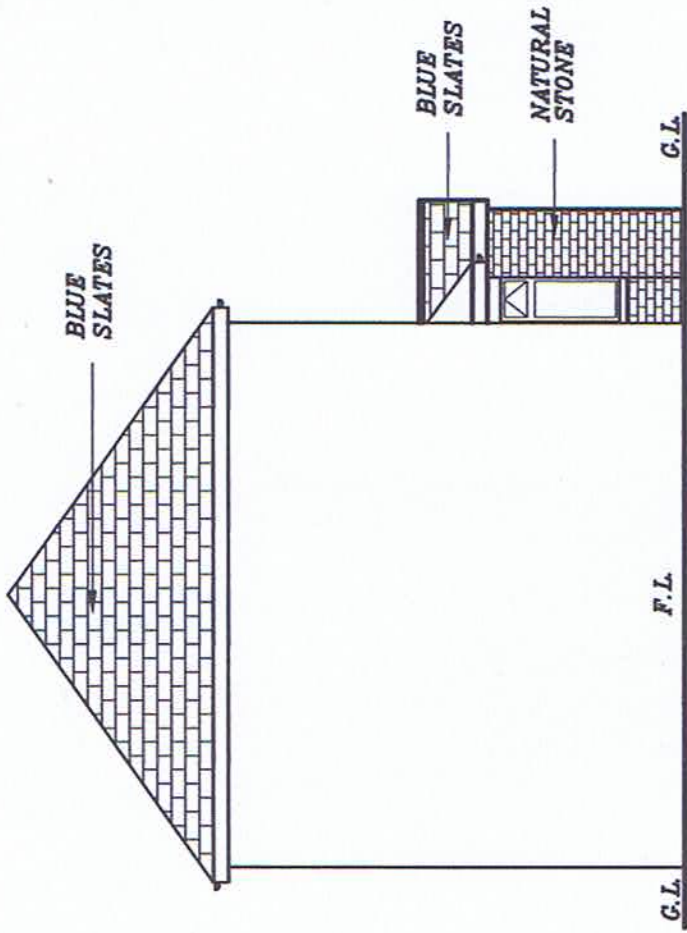

**SIDE ELEVATION
(AS BUILT)**

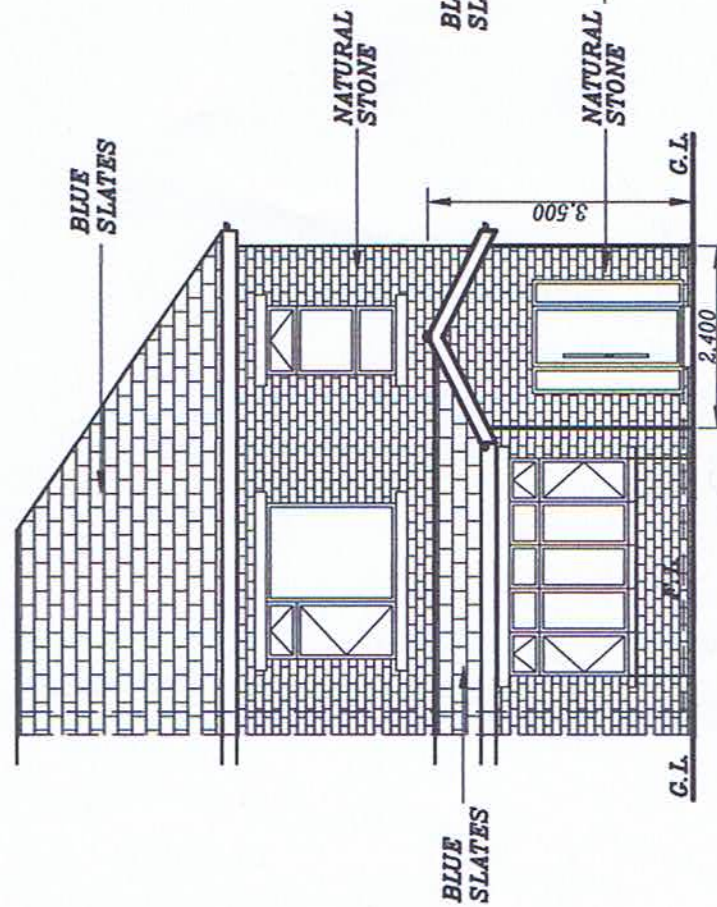


**FRONT ELEVATION
(AS BUILT)**

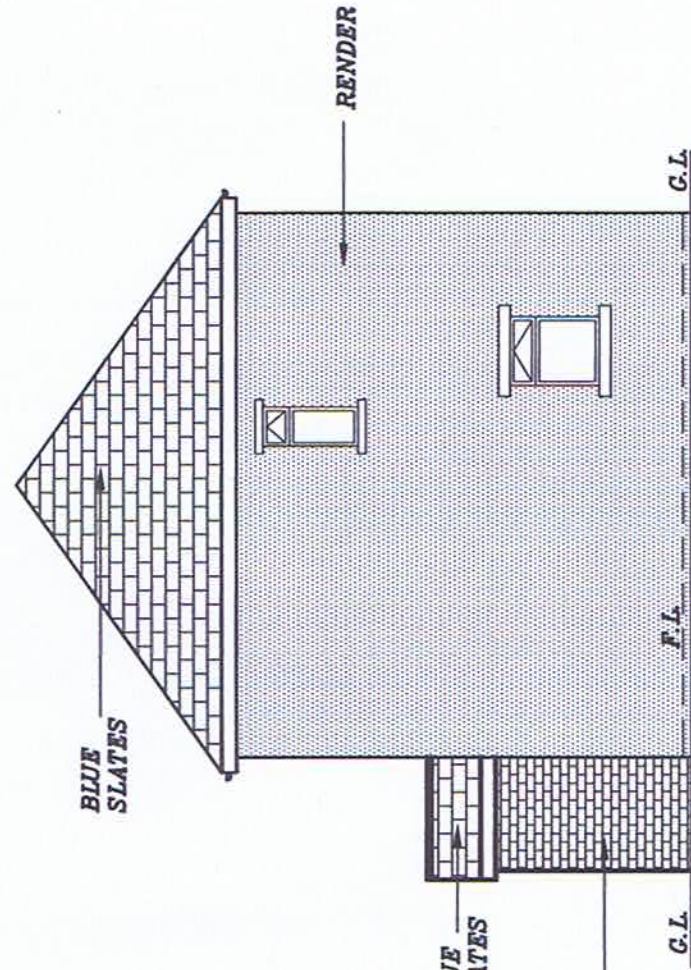


**SIDE ELEVATION
(AS BUILT)**

ALL WORK TO BE IN STRICT ACCORDANCE WITH THE
CURRENT BUILDING REGULATIONS & TO COMPLY WITH
ALL RELEVANT BRITISH STANDARDS & BUILDING CODES
OF PRACTICE.

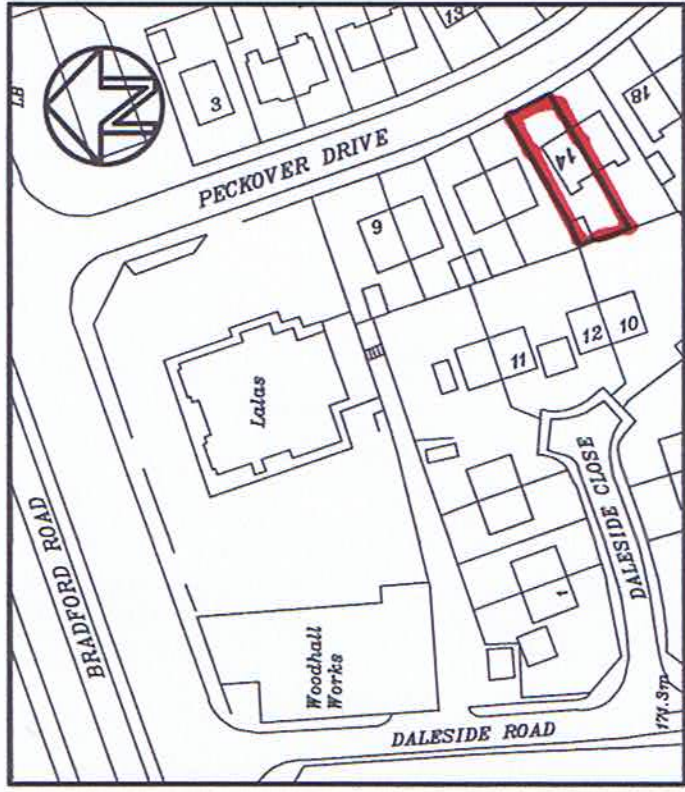

**LOCATION PLAN
SCALE: 1:1250**

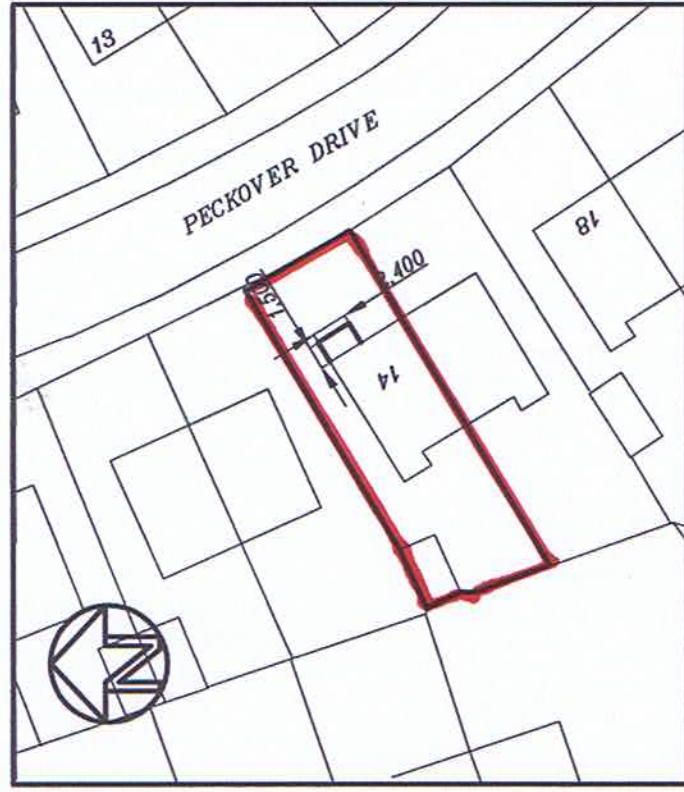

**SITE PLAN
SCALE: 1:500**

**RETROSPECTIVE FRONT PORCH AT HOUSE No.14 PECKOVER DRIVE, PUDSEY,
LS28 8EF FOR MRS ASMA KAUSAR**

Khawaja
ARCHITECTURAL SERVICES

SCALE: 1:100 DRAWN BY: ASIF KHAWAJA DATE: NOV.2023

TELEPHONE:
MOBILE 07960 683028

DRAWING NUMBER: 23/280/AK01