



KEY PLAN. 1:1000

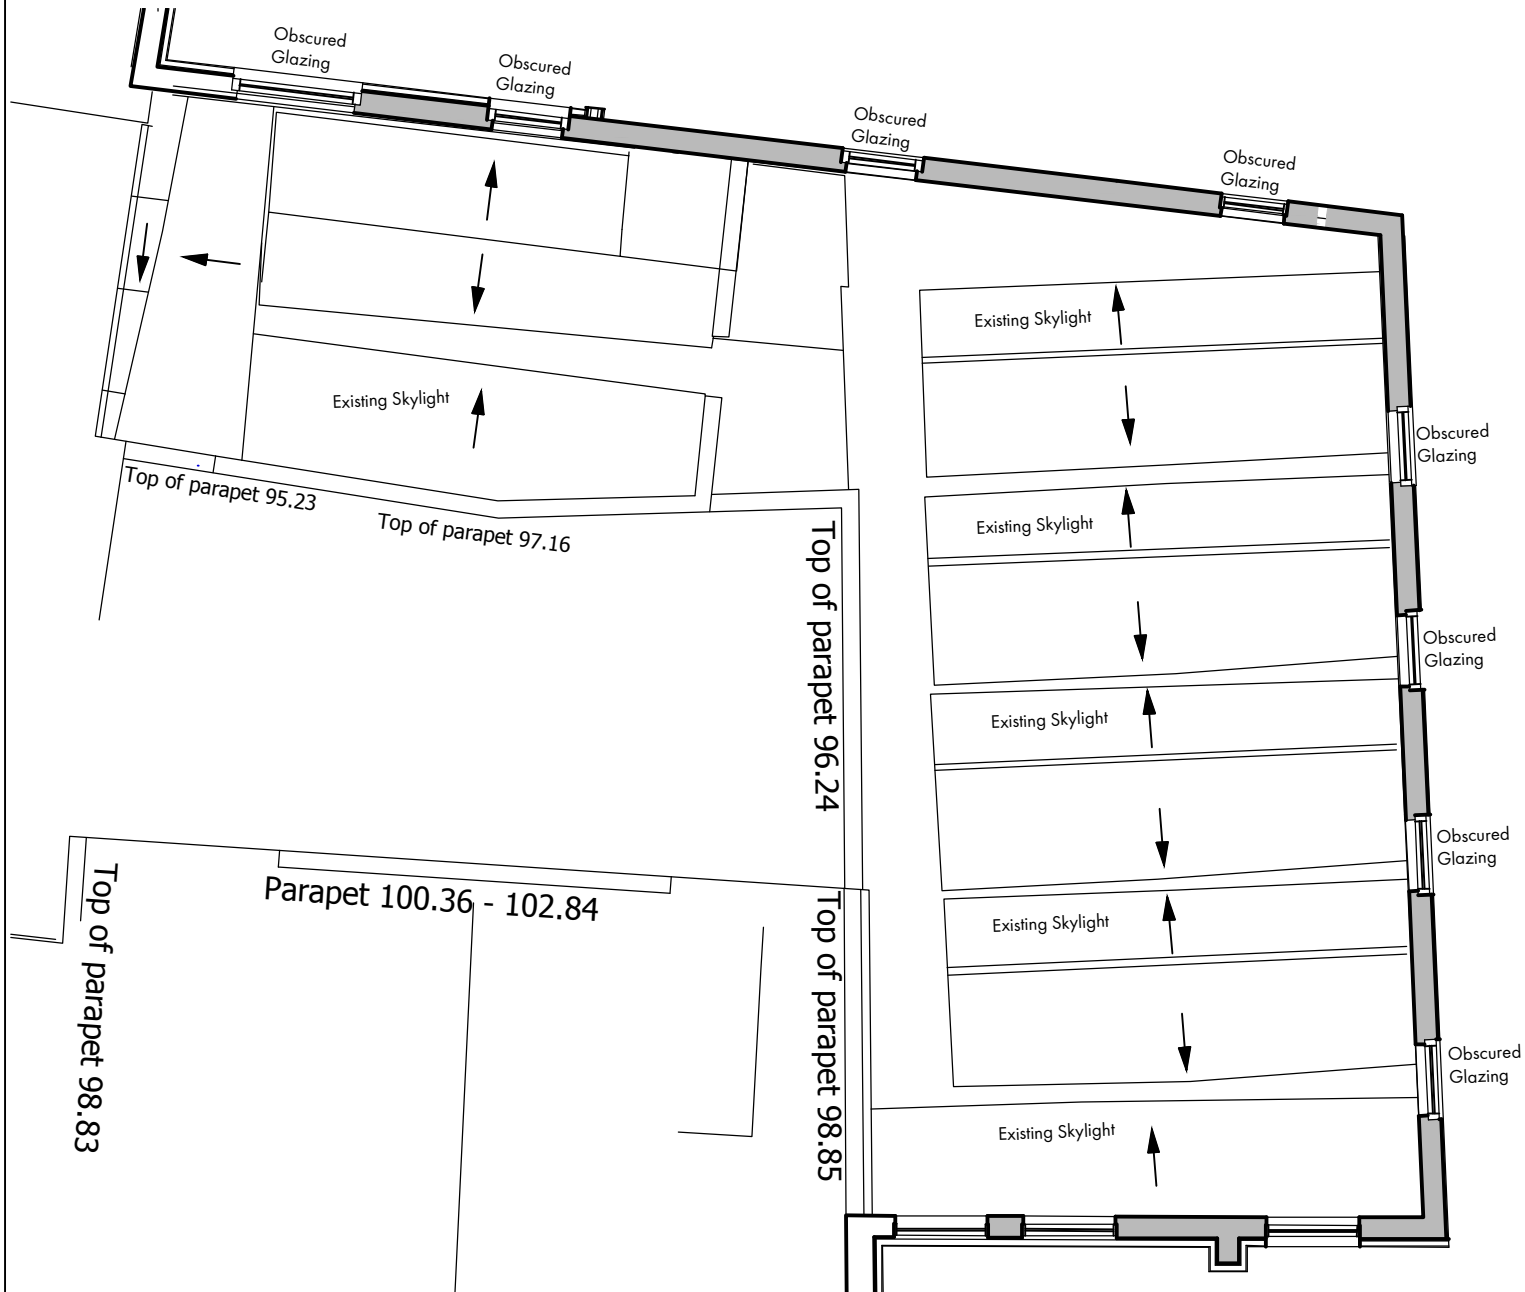

ROOF PLAN AS EXISTING 1:100
 Showing part of wall and Windows to floor above

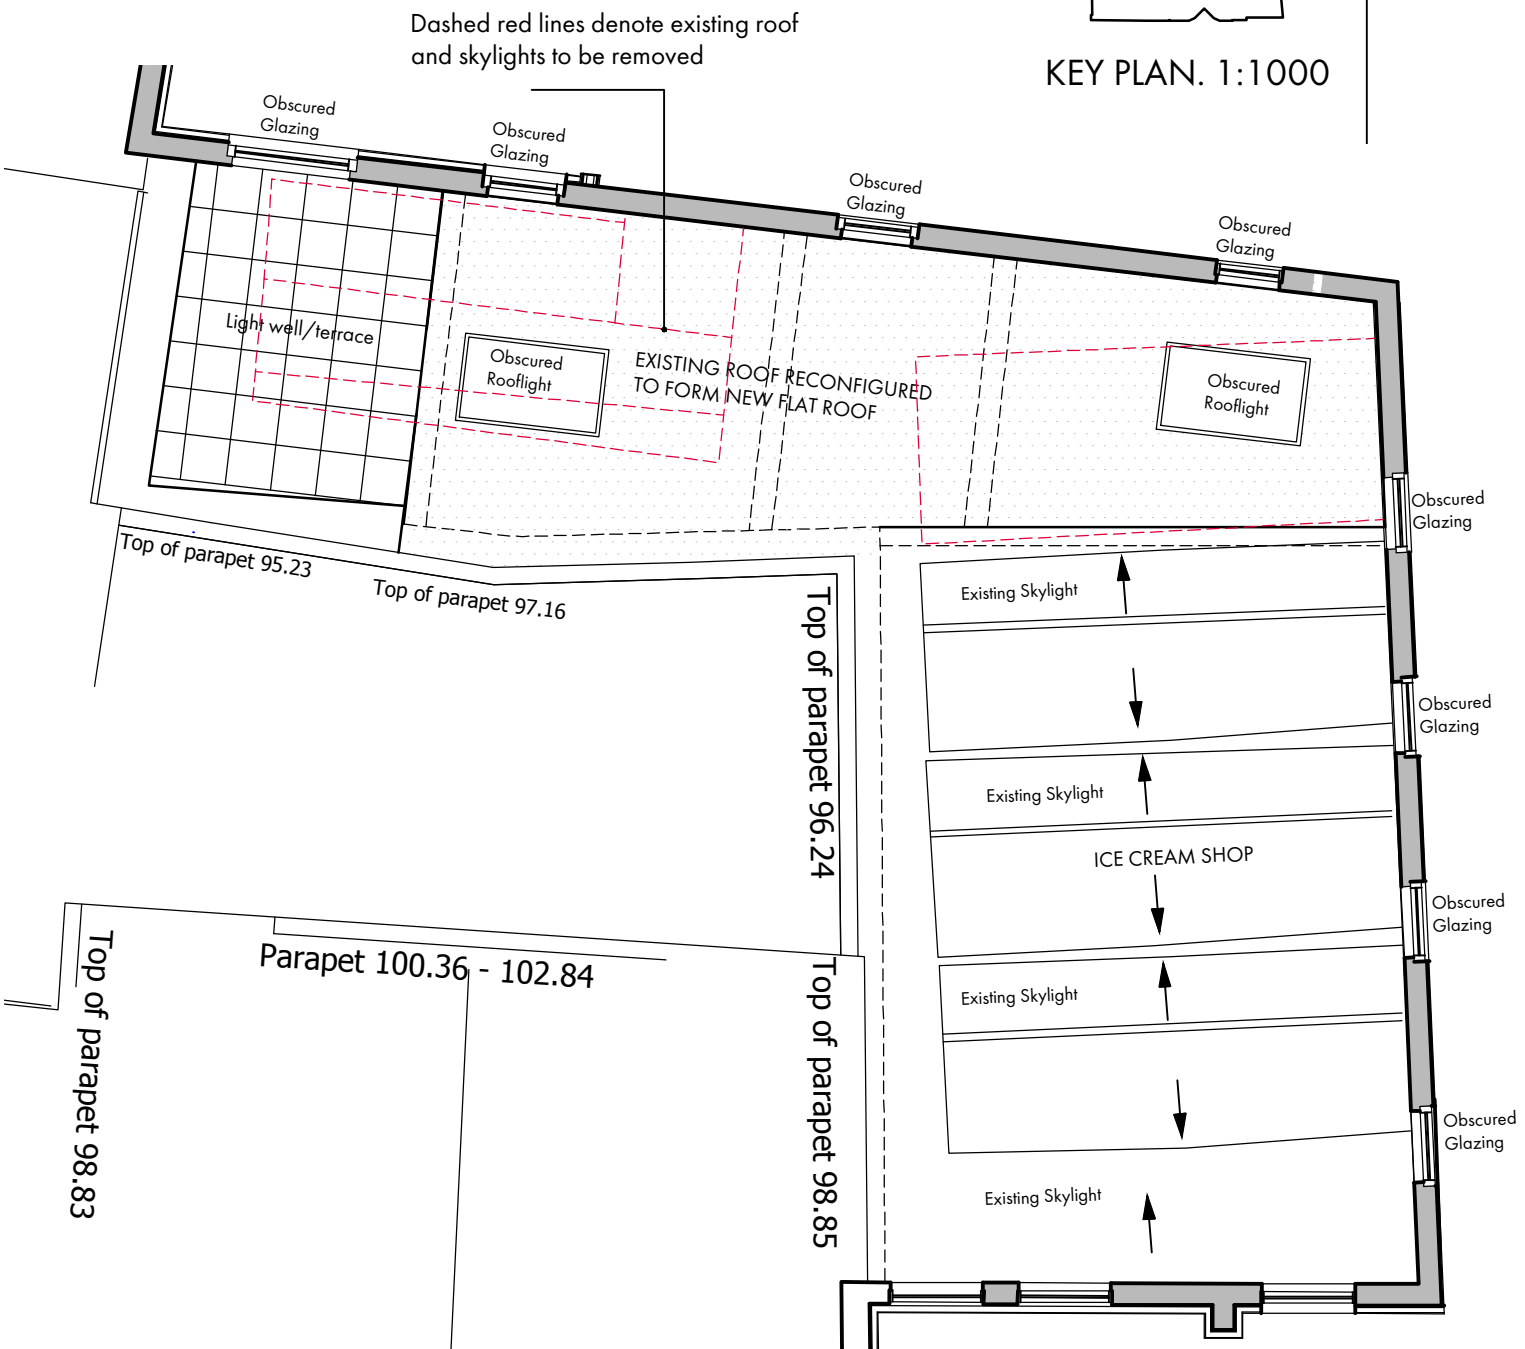

ROOF PLAN AS PROPOSED 1:100
 Showing part of wall and Windows to floor above

Dashed red lines denote existing roof and skylights to be removed

PLANNING DOCUMENT



RDJW Architects Limited
 · Quoin House · 9-11 East Park ·
 · Crawley · West Sussex · RH10 6AN ·
 Tel · +44 (0)1293 404 300
 Email · info@rdjw.co.uk Web · http://www.rdjw.co.uk

Project Title
 Change of Use of Basement
 20 Winchester Street
 Basingstoke RG21 7DZ

Drawing Title
 Roof Plan - Upper Ground Floor
 Apartments

Originator DW	Approved	Date 08.09.20	Scale As noted @ A3
Drawing No. 5580-013	Rev. -	Sheet No. 1/1	