

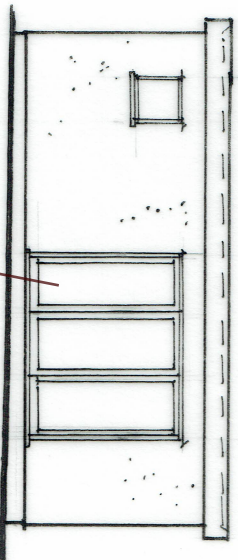


EPDM ROOF

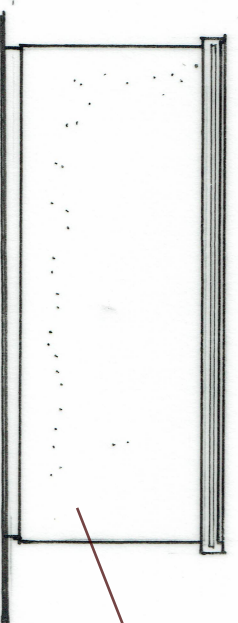

POWDER COATED DOOR SET

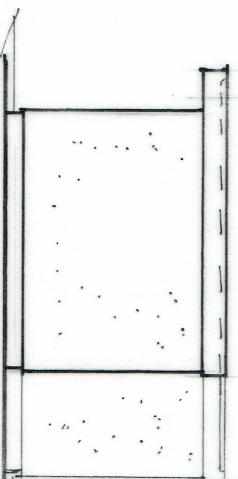

RENDER FINISH

FLANK ELEVATION

FRONT ELEVATION  
(GARDEN)


FLANK ELEVATION

REAR ELEVATION

17 POLEHANGER LANE  
HEMEL HEMPSTEAD  
HERTS  
HP1 3PT

GARDEN ROOM (GYM)

PLAN AND ELEVATIONS  
AS BUILT

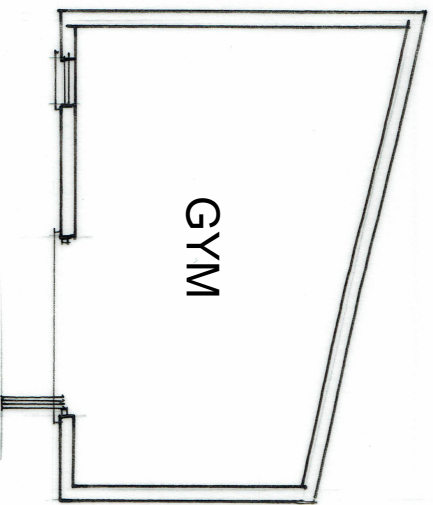

GYM

FLOOR PLAN



1-100 SCALE