


Λ

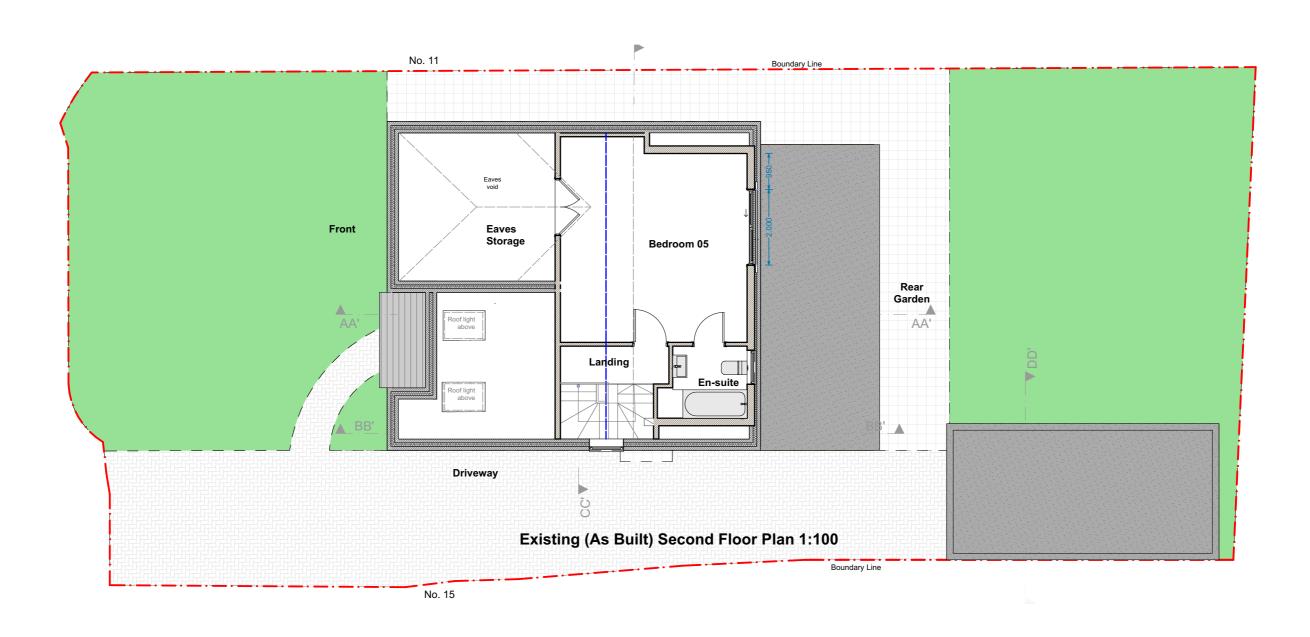

COPYRIGHT: The contents of this drawing may not be reproduced in whole or in part without express written consent of ARKSS Design Limited.

Drawings to be read in conjunction with relevant drawing and specs. Drawings can only be scaled for planning purposes. Drawings not to be scaled. figured dimensions only for construction and anyother purpose. Any discrepancies are to be pointed to the Agent/Engineer/Contractor. The agent is not liable for any faults not raised.Drawings not to be scaled for land transfer purposes.

PLANNING ISSUE

Scale: 1:100@A3 Date: SEP 2023

Project Title:
RETROSPECTIVE APPLICATION AT
13 HEATH ROAD, GRAYS,
RM16 4UT

EXISTING AS BUILT
PLAN

Project no: Drawing no 
2302010 PL07

wing no: Revision:

Revision

E.mail:

contact@arkssdesign.co.uk Tel: 0208 0905070

Detail

Mob: 078 2555 7465

Unit 13 First Floor, Clements Court, 13-14 Clements Lane, Ilford, Essex, IG1 2QY