



EXISTING FENCE (ORIGINAL)

AS BUILT

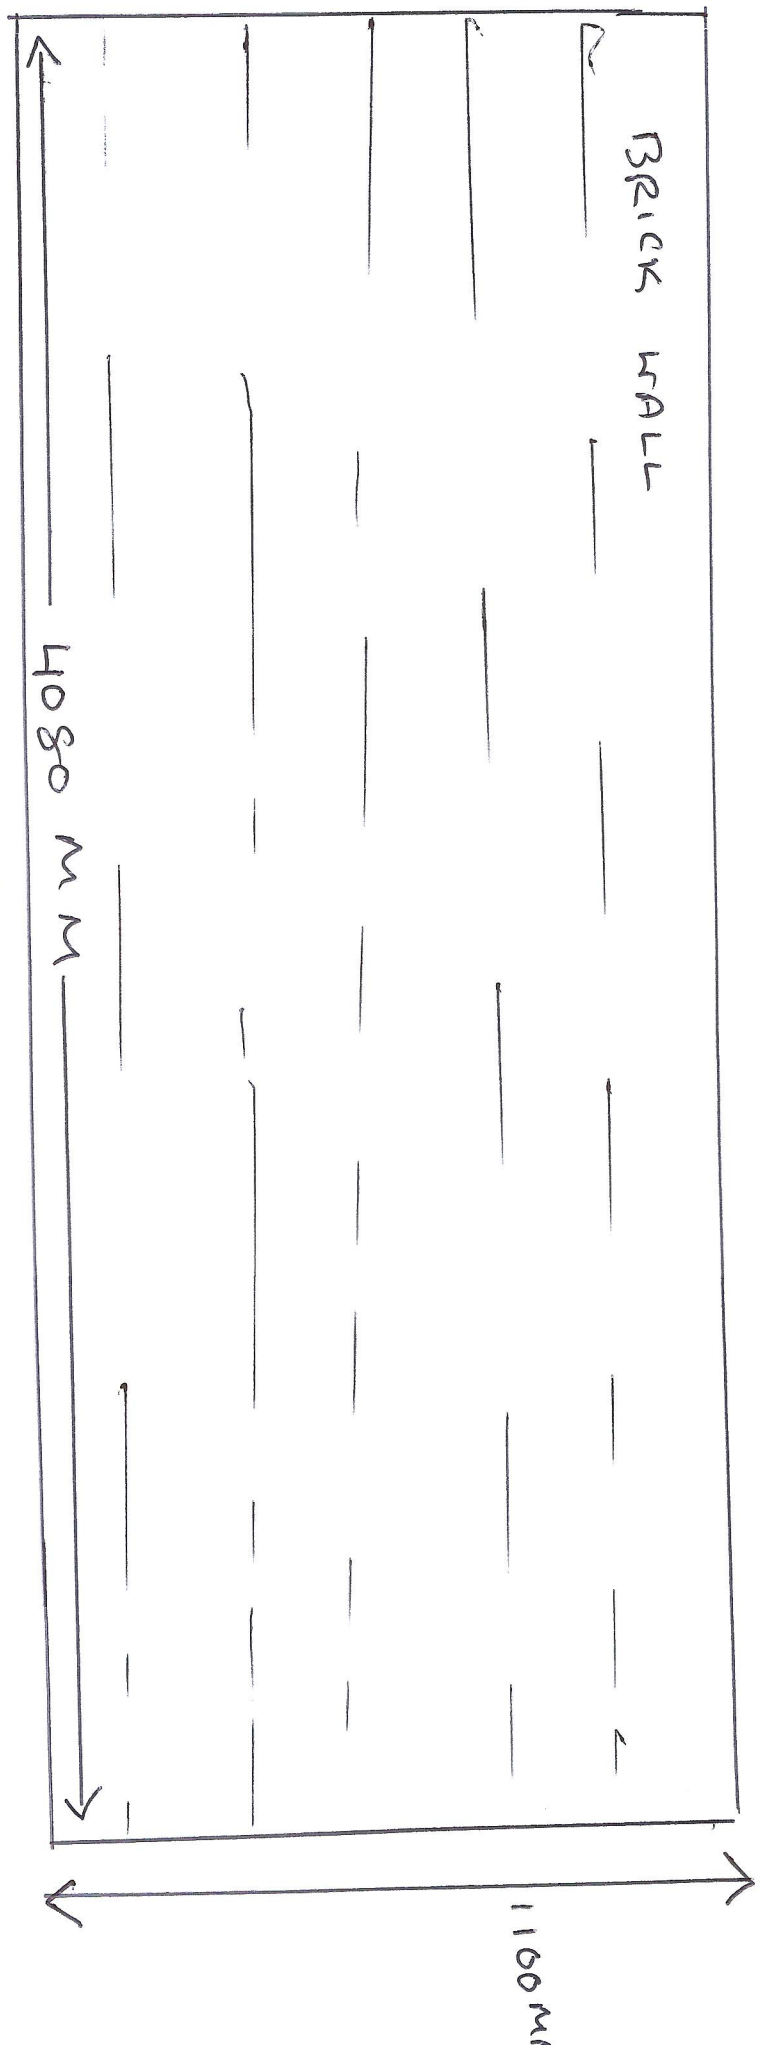

FRONT LEFT FENCE
52 COOKS MEAD, RUGBY MD23 HFE


SCALE 1:20

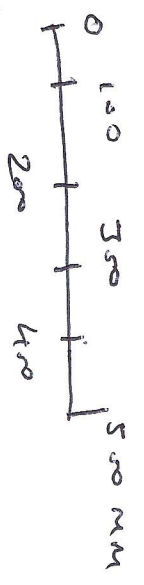

PROPOSED FENCE

S2 COOKS MEAD, RUSHLEY, WD23 4FE

21.11.2023

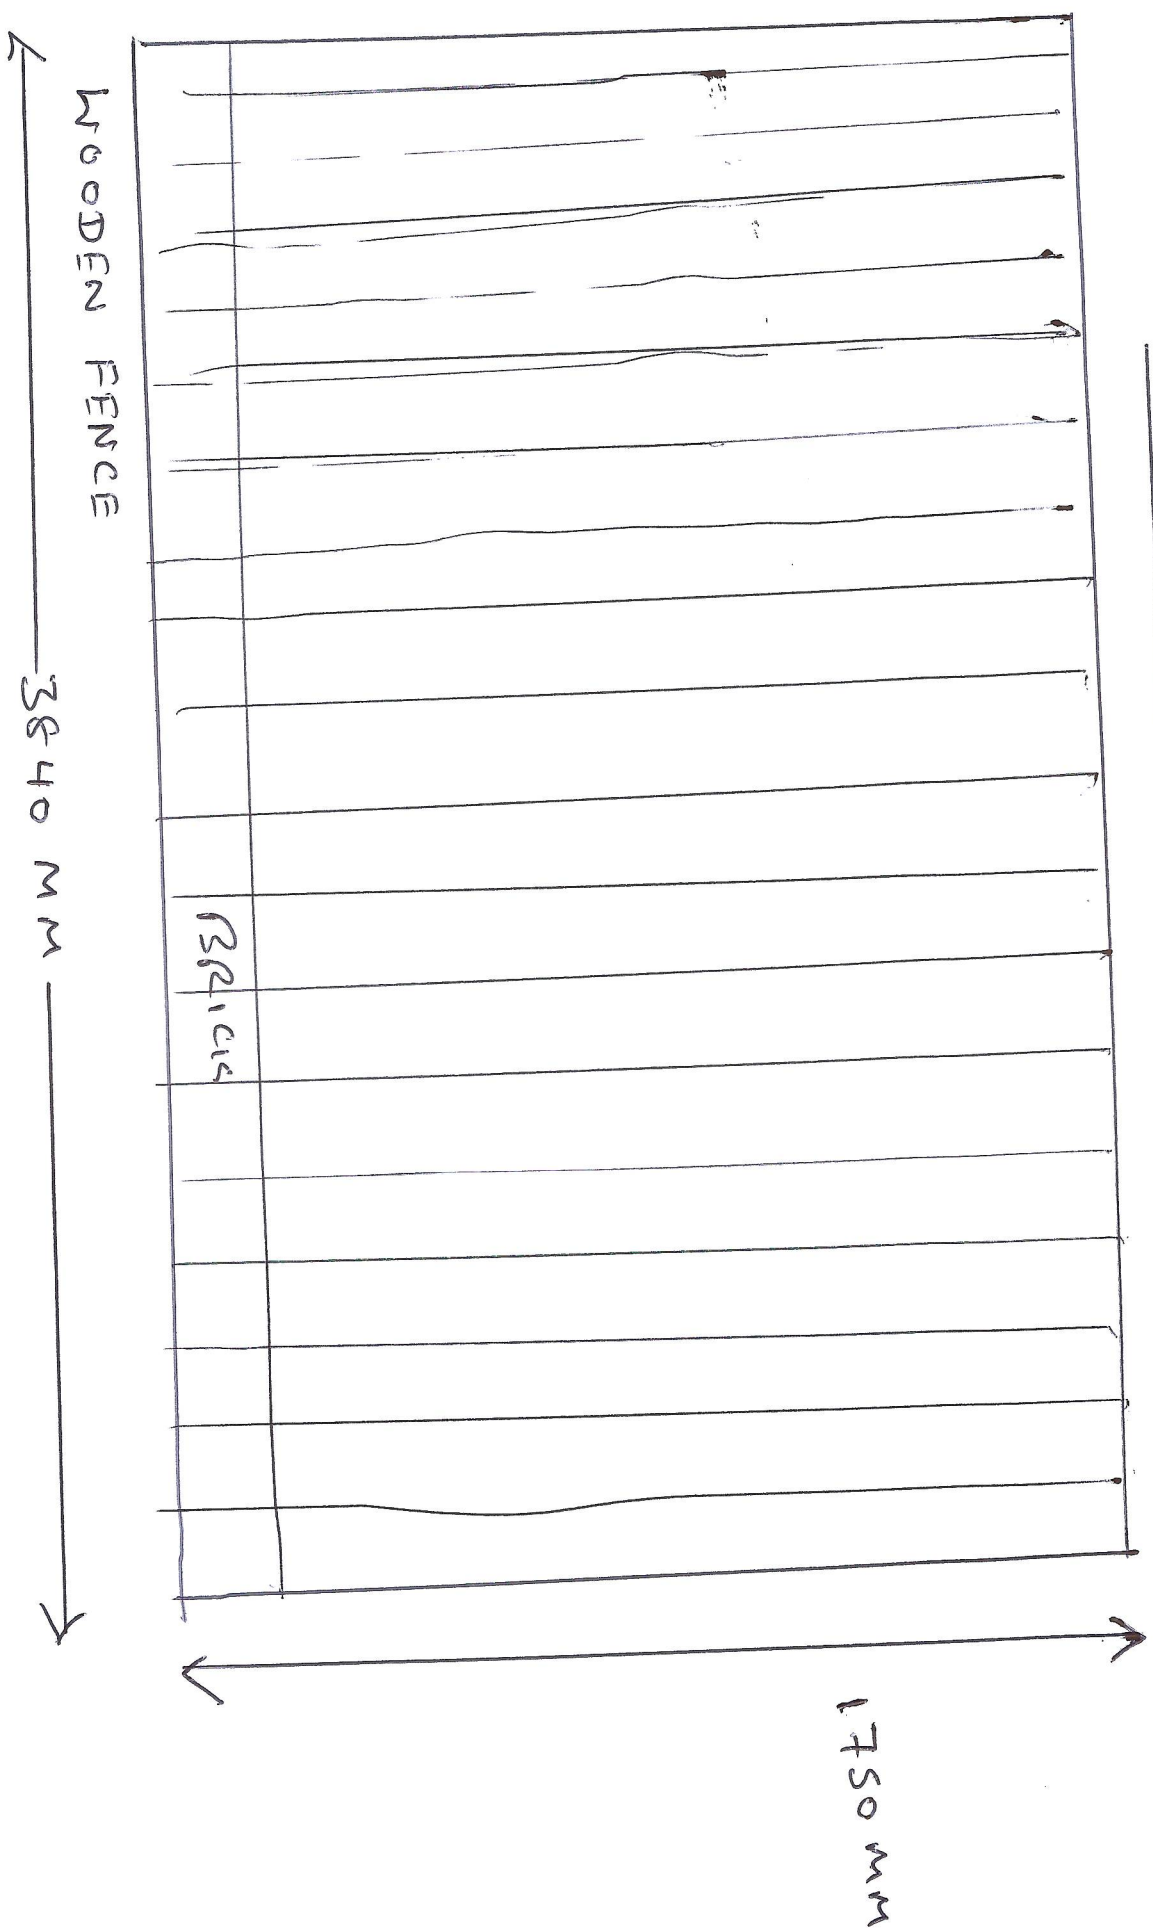

FRONT LEFT FENCE

