
PROPOSED GROUND FLOOR PLAN

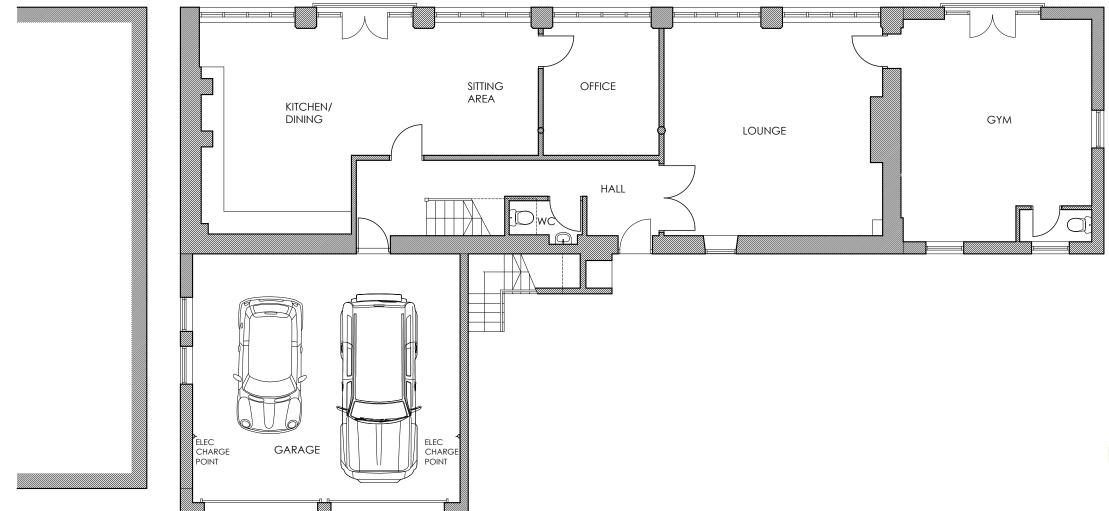

REV C - 31.10.23 Minor adjustments to layout, to reflect 'as built'. REV B - 22.12.21 Gym WC amended. REV A - 26.11.21 Garage doors amended.

MHAARCHITECTURE

Bethel Hall Morton Lane East Morton West Yorkshire BD20 5UE

T: East Morton Office: Leeds Office: 01274 512639 0113 2732706

Proposed Extension and Alterations Low Farm Barn, High Street Clifford for Mr P Gilman

Proposed Ground Floor Plan

Date:	Drawn By:	Checked By:	Scale: A3@
Nov' 21	TP		1:100
Project No:	Drawing I	No:	Revision:
4074	030		С