



BOUNDARY

BOUNDARY

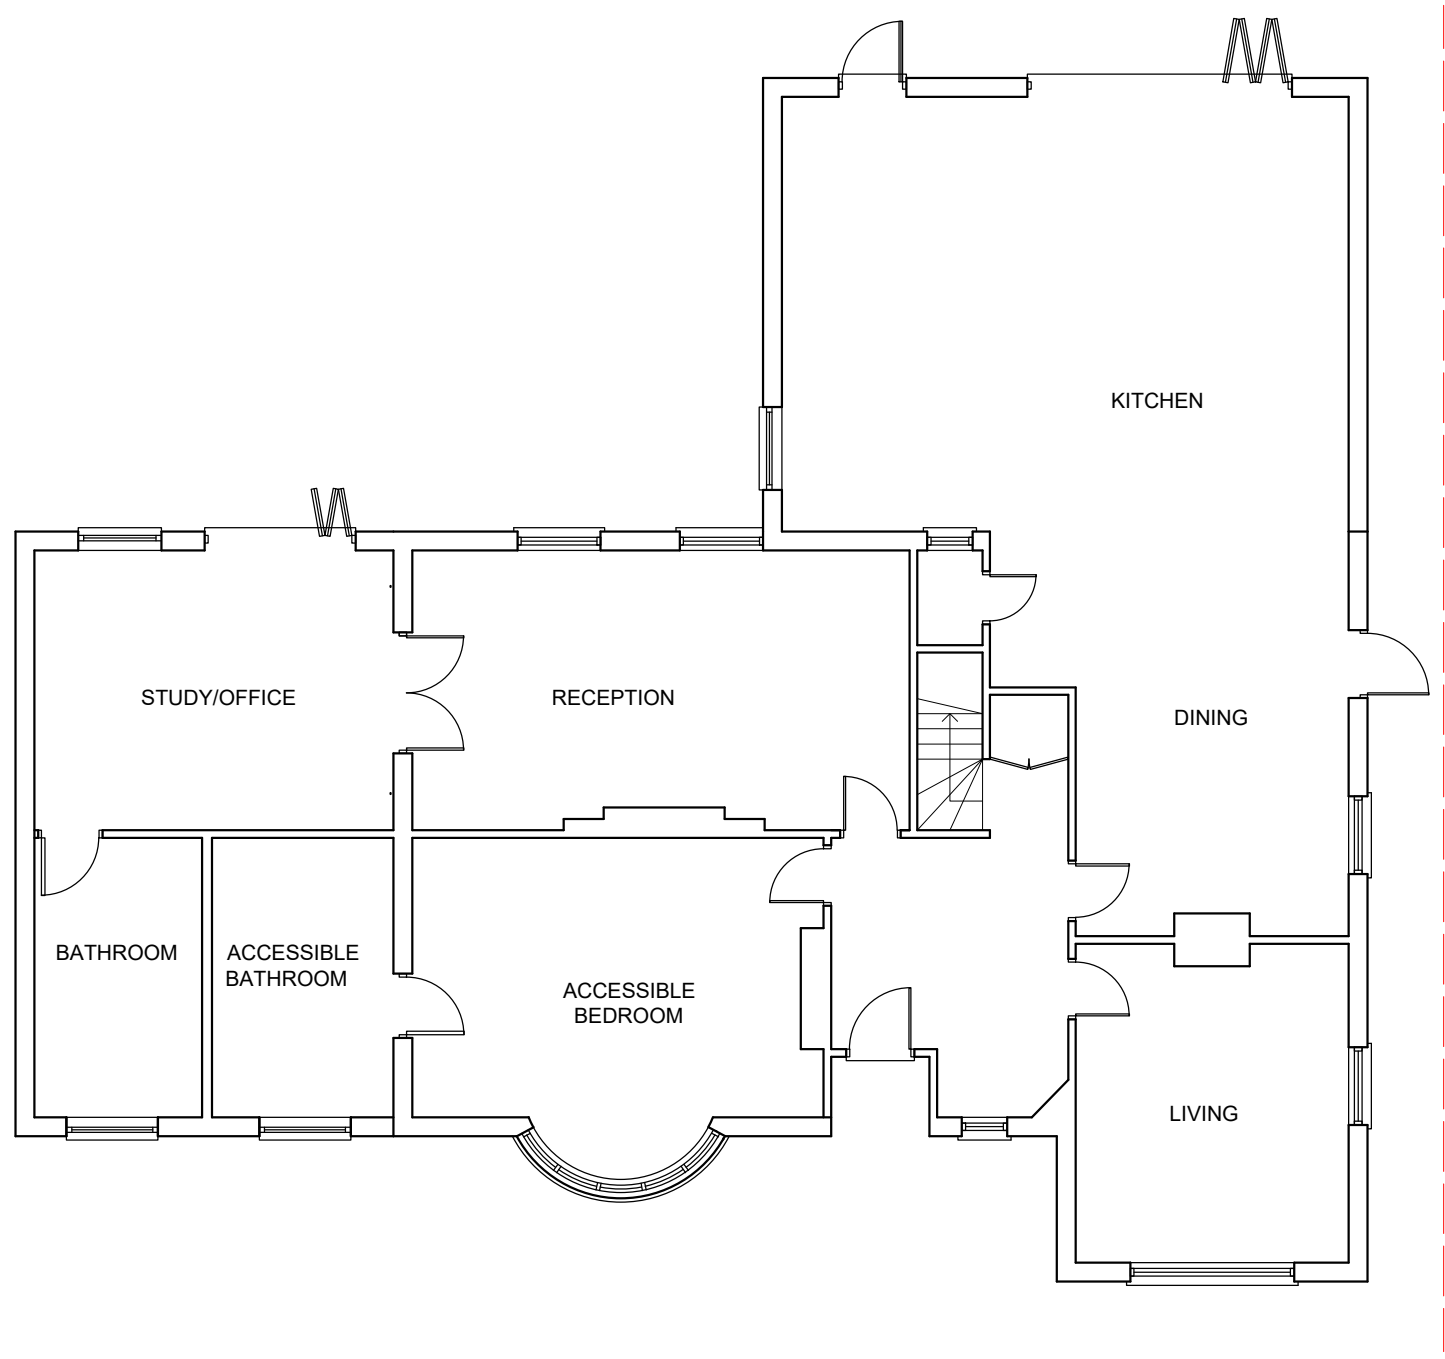


AS-BUILT /PROPOSED GROUND FLOOR PLAN

**Plans @ 1:100**

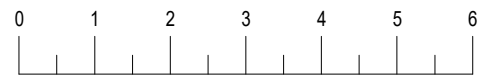

scale 1:100 (metres)

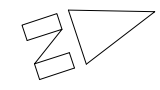

### Revisions

All dimensions and particulars are to be checked on site before work commences and any discrepancy to be reported to THE SURVEYOR.  
DO NOT SCALE off this drawing, use written dimensions only.

Project  
**WINDOW INSTALLATION  
 AT 282 LEIGHAM COURT  
 ROAD, LONDON,  
 SW16 2QR**

Drawing  
**GROUND FLOOR PLAN  
 AS-BUILT /PROPOSED**

Number	Revisions
2023/LRC/202	

Date  
**SEP 2023**

Scale  
**1:100@A3**

Client  
**MR SHERZAMAN KHAN**