



BOUNDARY

BOUNDARY

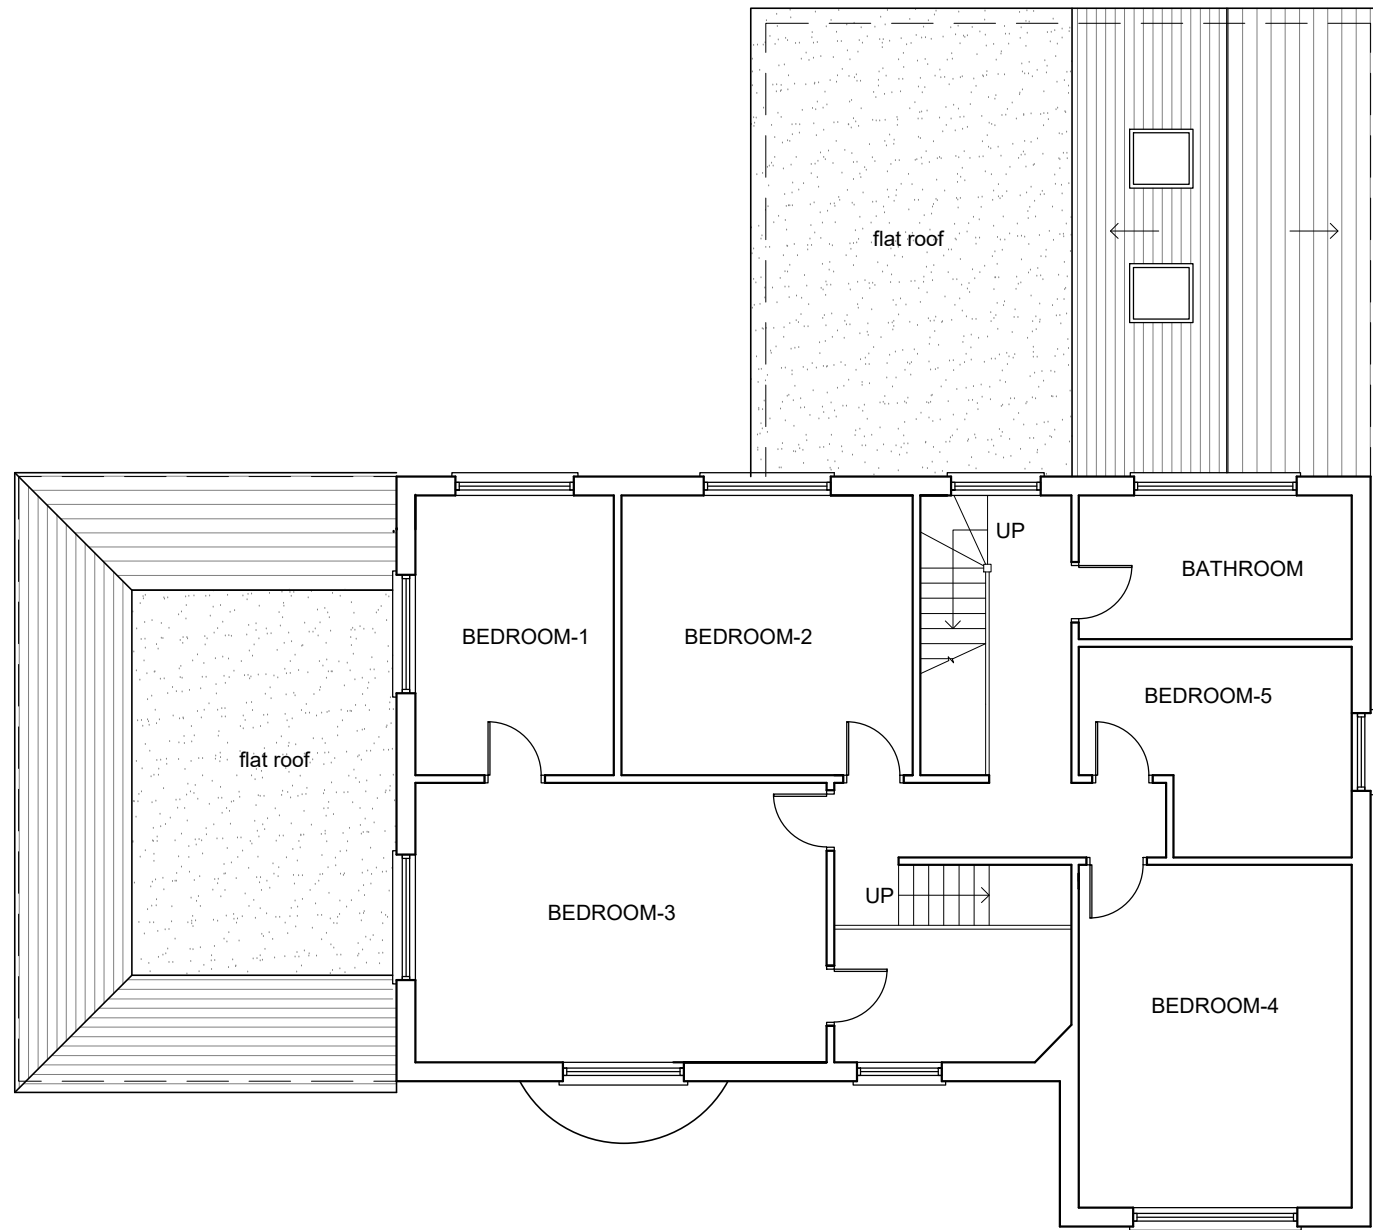

AS-BUILT /PROPOSED FIRST FLOOR PLAN

Plans @ 1:100

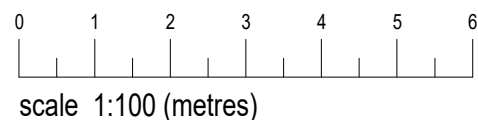

Revisions

All dimensions and particulars are to be checked on site before work commences and any discrepancy to be reported to THE SURVEYOR. DO NOT SCALE off this drawing, use written dimensions only.

Project
**WINDOW INSTALLATION
 AT 282 LEIGHAM COURT
 ROAD, LONDON,
 SW16 2QR**

Drawing
**FIRST FLOOR PLAN
 AS-BUILT /PROPOSED**

Number	Revisions
2023/LRC/203	

Date
SEP 2023

Scale
1:100@A3

Client
MR SHERZAMAN KHAN