



NOTES

ALL DIMENSIONS ARE TO BE CHECKED ON SITE. ANY DISCREPANCIES ARE TO BE RECORDED AND REPORTED TO THE ARCHITECT BEFORE PROCEEDING WITH THE WORKS.


WHERE ROOMS ARE COVERED BY DRAWINGS OF A DIFFERENT SCALE THE DIMENSIONS SCALE DRAWINGS ARE TO BE WORKED TO IN ALL CASES.

ALL DIMENSIONS INDICATED ARE STRUCTURAL UNLESS STATED OTHERWISE.


THIS DRAWING IS TO BE READ IN CONJUNCTION WITH ALL OTHER GENERAL ARRANGEMENT DRAWINGS, DETAILS AND SPECIFICATIONS. ALL WORKS TO COMPLY WITH THE REQUIREMENTS OF BUILDING REGULATIONS 1991 AND SUBSEQUENT AMENDMENTS.

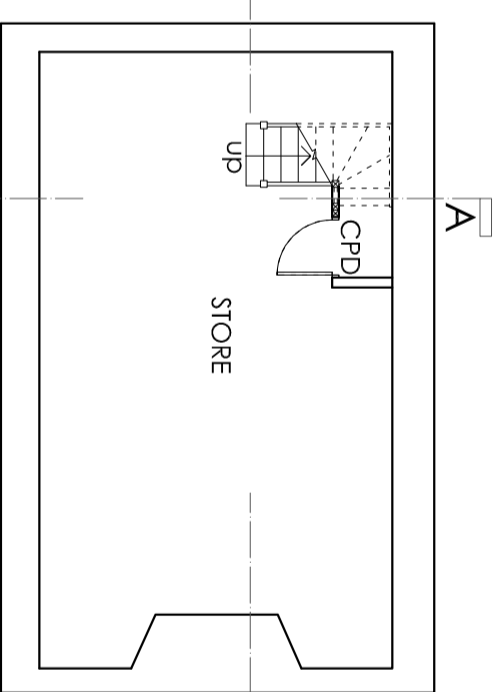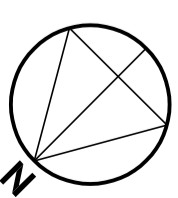


AL(0)21.01
BASEMENT PLAN
SCALE 1:100

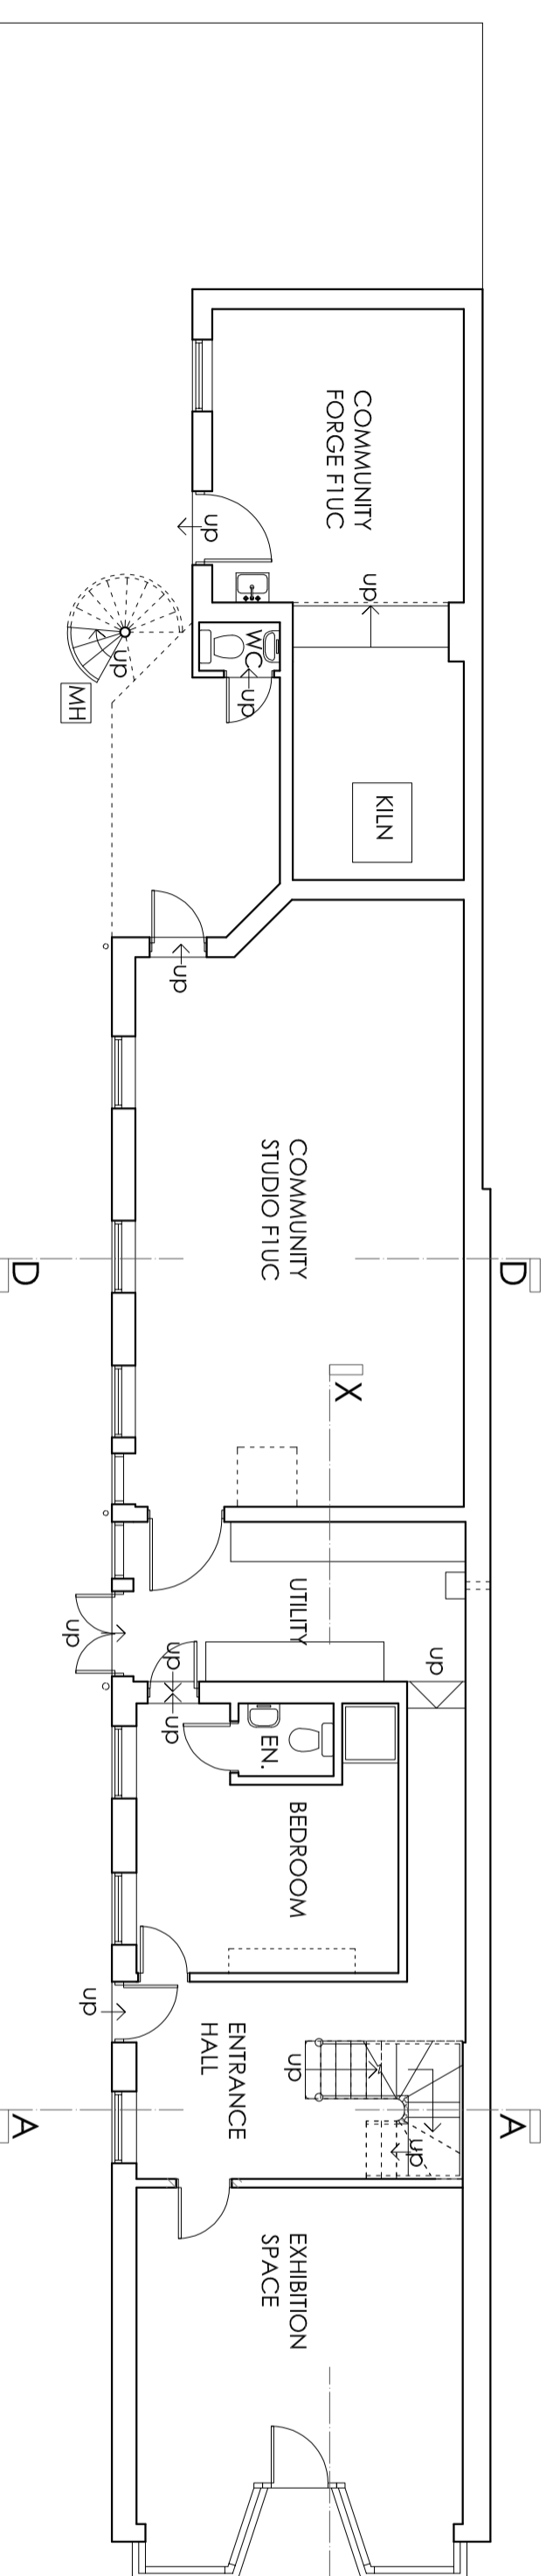


AL(0)21.02
GROUND FLOOR PLAN
SCALE 1:100

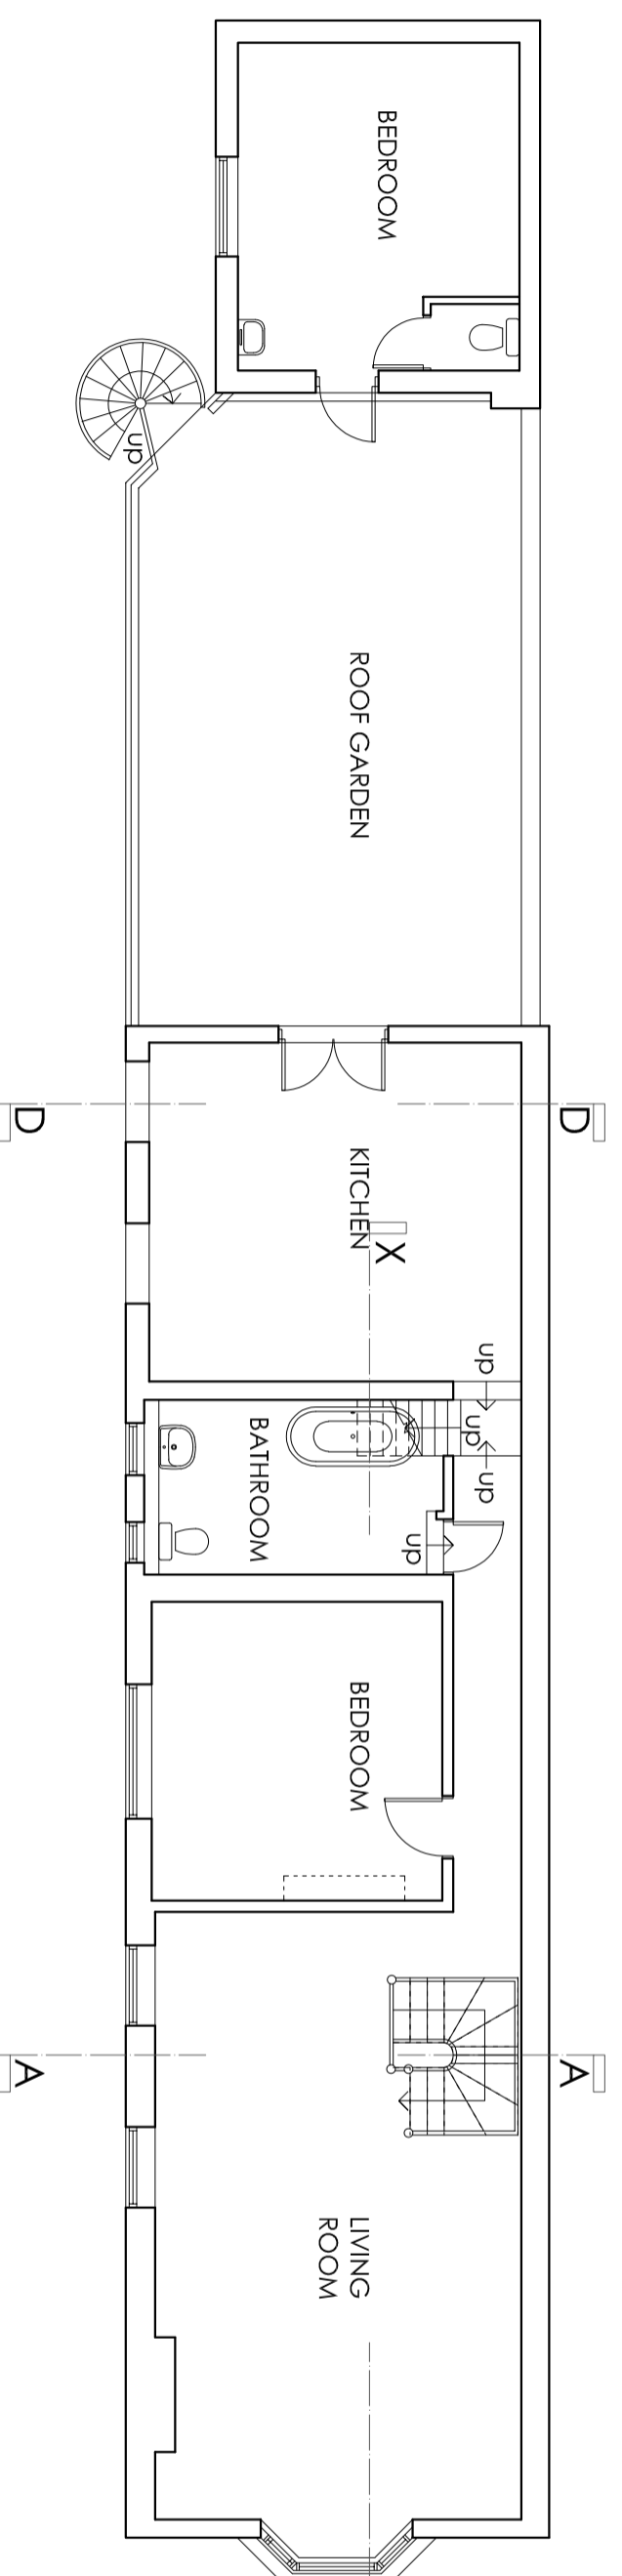

AL(0)21.03
FIRST FLOOR PLAN
SCALE 1:100

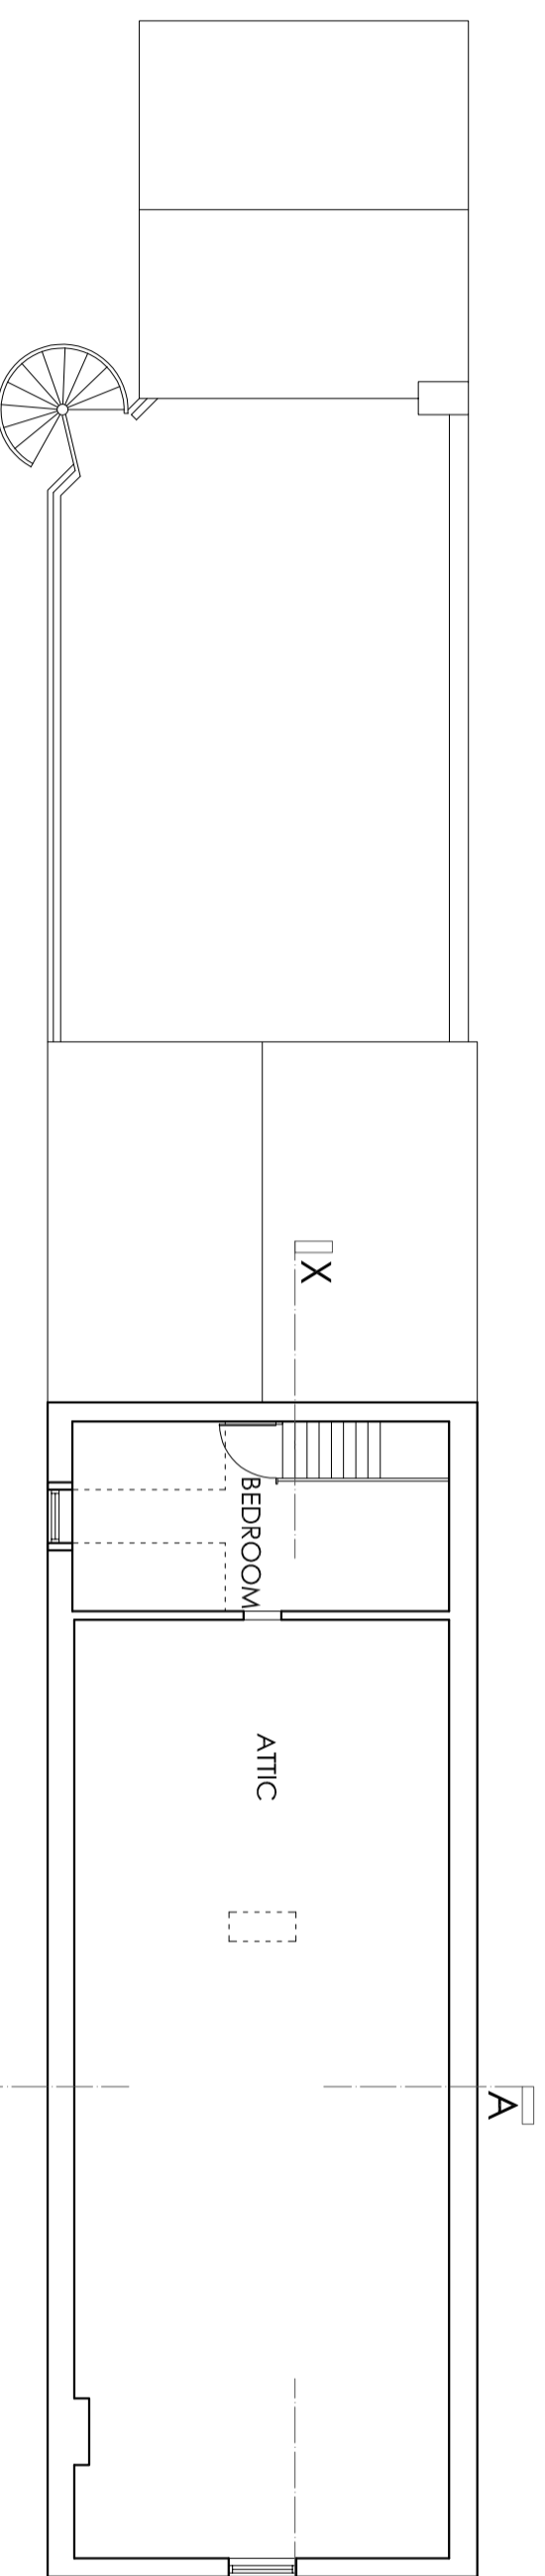

AL(0)21.04
SECOND FLOOR PLAN
SCALE 1:100

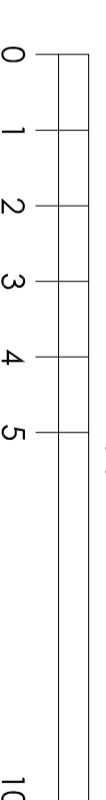

METRIC SCALE
1:100

C	AA	Alterations to reflect as built	QA
	2023/11/06	changes	
B	PM &	Smoke detectors added	QA
	2022/02/01		
A	KR &	Staircase amendment	QA
	2021/07/08		
ISSUE	initial &	modification	QA
	DATE		

DRAWING TYPE
PLANNING

PROJECT TITLE
301 London Road
Deal, Kent
CT14 9PP

CLIENT
Ms King


DRAWING TITLE
Floor Plans
as Proposed

date	scale	size	drawn by
Mar 2021	1:100	A3	KR
job no.	drawing no.	revision no.	
21/101/LON	AL(0)21	C	



Cyma Architects

55 The Old High Street,
Folkestone, Kent, CT20 1RN
Tel: 01233 666667
Fax: 01233 666663
Website: www.cymaarchitects.co.uk
Email: info@cymaarchitects.co.uk

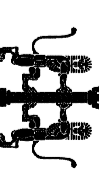

CHARTERED ARCHITECTS

@ 2015 Cyma Architects Ltd & Roger Joyce Associates.
All rights reserved. No part of this document may be reproduced, stored in a retrieval system, or transmitted in any form or by any means, electronic, mechanical, photocopying, recording, or by any information storage and retrieval system, without the prior written permission of Cyma Architects Ltd and Roger Joyce Associates.
THE COPYRIGHT OF THE FOLLOWING DESIGN DOCUMENTATION WITHIN THIS DOCUMENT ARE RESERVED BY Cyma Architects Ltd and Roger Joyce Associates.

COPYRIGHT ACKNOWLEDGEMENT

COPYRIGHT
COPYRIGHT

AL(0)21
FLOOR PLANS
AS PROPOSED
SCALE 1:100