



**NOTES**

ALL DIMENSIONS ARE TO BE CHECKED ON SITE. ANY DISCREPANCIES ARE TO BE RECORDED AND REPORTED TO THE ARCHITECT BEFORE PROCEEDING WITH THE WORKS.


WHERE ROOMS ARE COVERED BY DRAWINGS OF A DIFFERENT SCALE THE DIMENSION SCALE DRAWINGS ARE TO BE WORKED TO IN ALL CASES.

ALL DIMENSIONS INDICATED ARE STRUCTURAL UNLESS STATED OTHERWISE.


THIS DRAWING IS TO BE READ IN CONJUNCTION WITH ALL OTHER GENERAL ARRANGEMENT DRAWINGS, DETAILS AND SPECIFICATIONS. ALL WORKS TO COMPLY WITH THE REQUIREMENTS OF BUILDING REGULATIONS 1991 AND SUBSEQUENT AMENDMENTS.

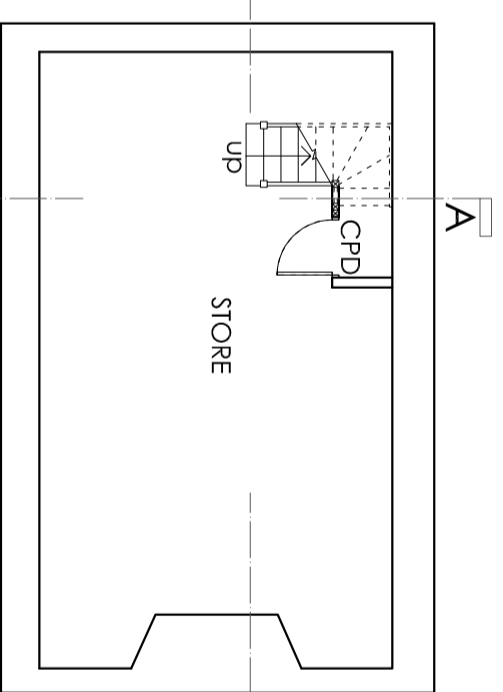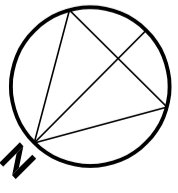


AL(0)20.01  
BASEMENT PLAN  
SCALE 1:100

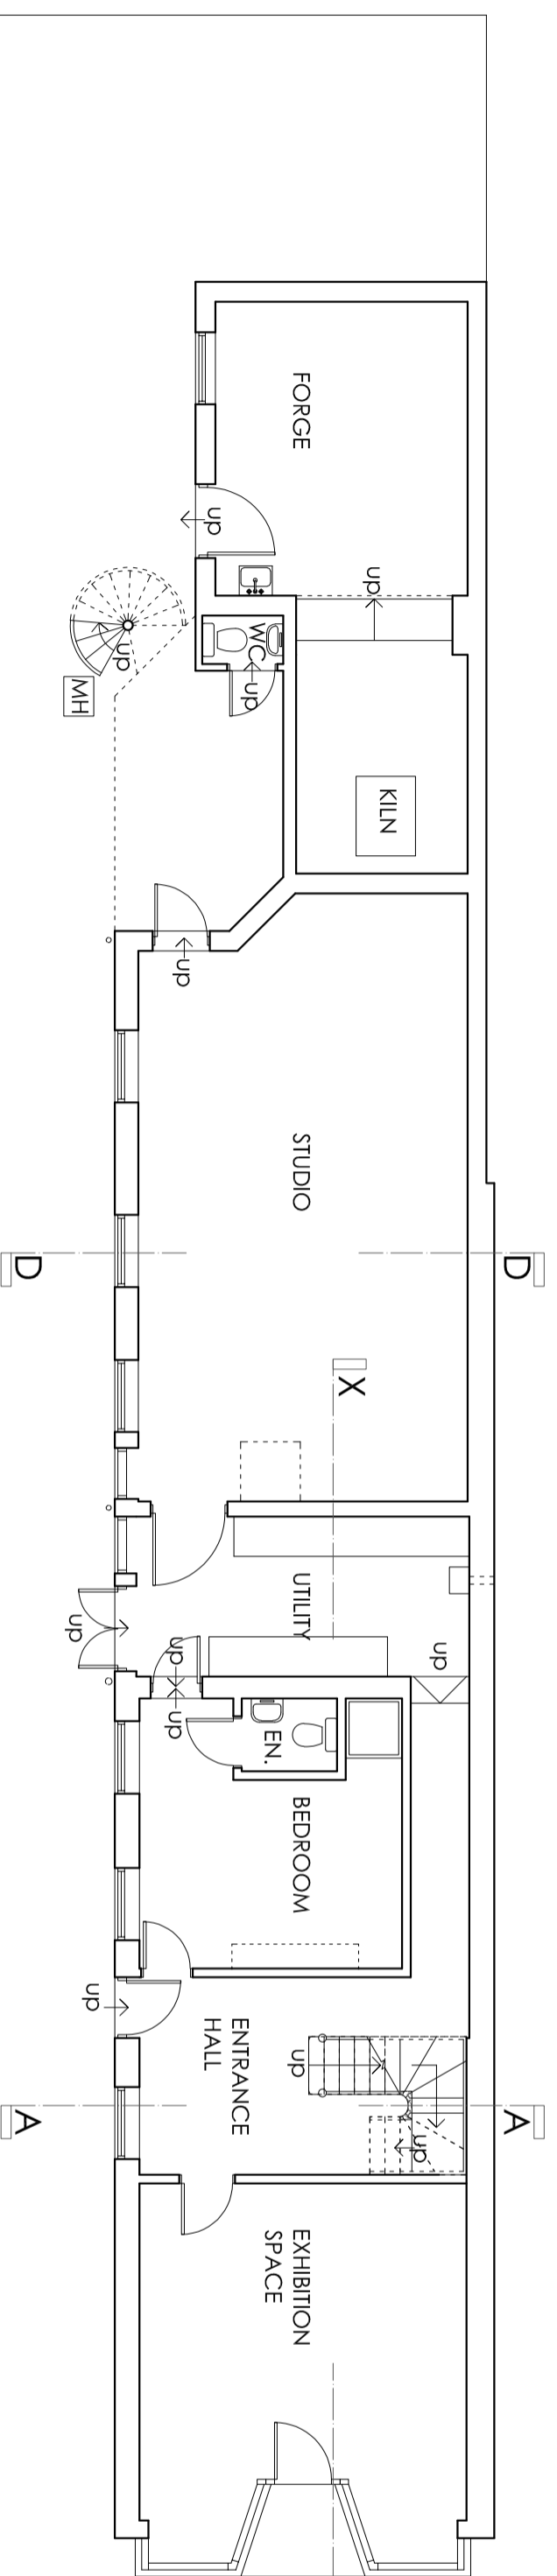


AL(0)20.02  
GROUND FLOOR PLAN  
SCALE 1:100

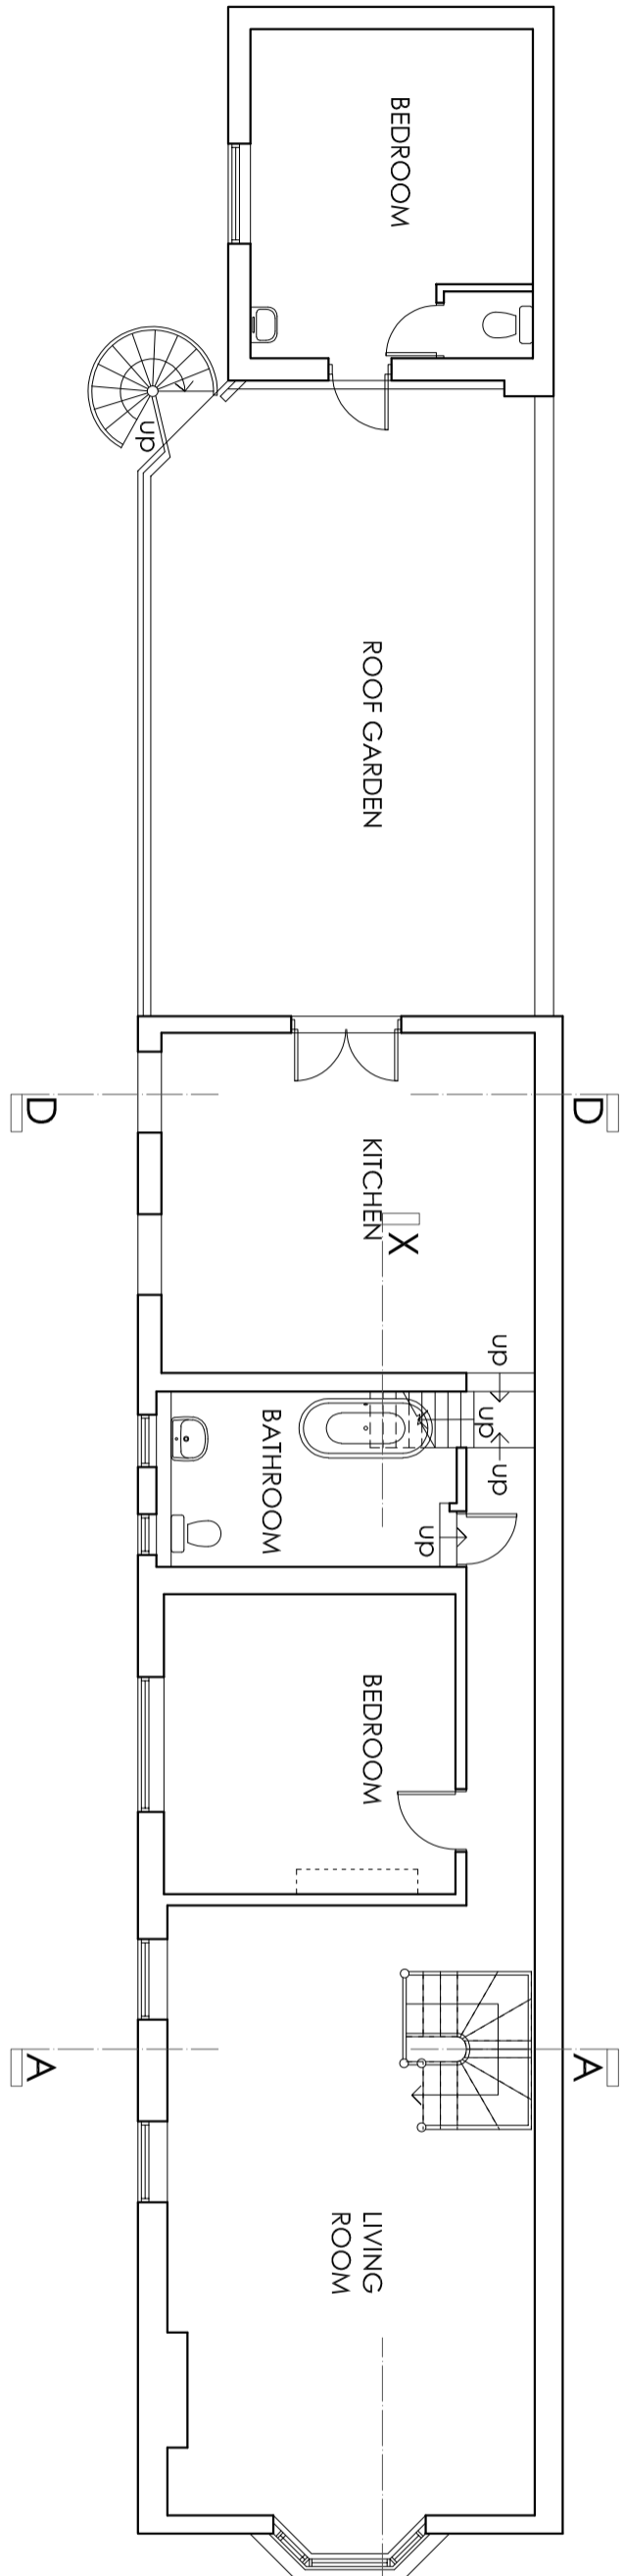

AL(0)20.03  
FIRST FLOOR PLAN  
SCALE 1:100

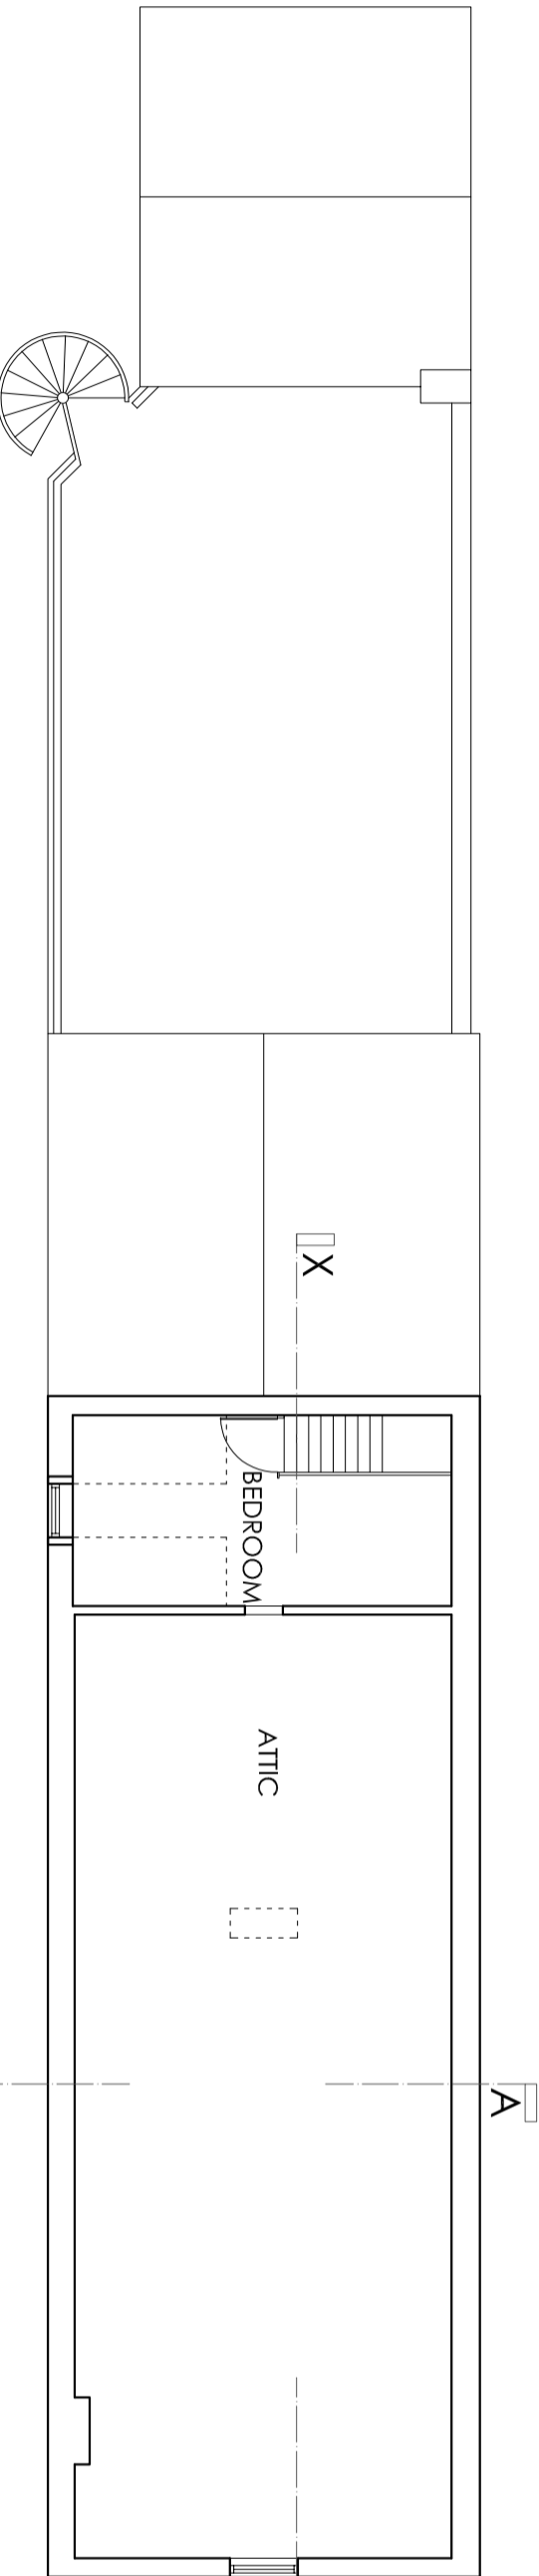

AL(0)20.04  
SECOND FLOOR PLAN  
SCALE 1:100

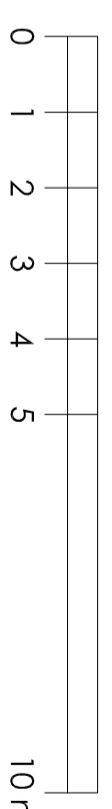

METRIC SCALE  
1:100

C	AA	Alterations to reflect as built	QA
B	2023/11/06	changes	QA
B	PM &	Smoke detectors added	QA
A	2022/02/01		
A	KR &	Staircase amendment	QA
A	2021/07/08		
Issue	Initial &	modification	QA
date			

**DRAWING TYPE**  
**PLANNING**

**PROJECT TITLE**  
301 London Road  
Deal, Kent  
CT14 9PP


**CLIENT**  
Ms King

**DRAWING TITLE**  
Floor Plans  
as Existing

date	scale	size	drawn by
Mar 2021	1:100	A3	KR
job no.	drawing no.	revision no.	
21/101/LON	AL(0)20	C	



**Cyma Architects**  
55 The Old High Street,  
Folkestone, Kent, CT20 1RN  
Tel: 01233 666667  
Fax: 01233 666663  
Website: www.cymaarchitects.co.uk  
E-mail: info@cymaarchitects.co.uk

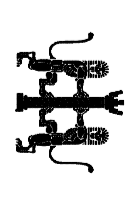

**CHARTERED ARCHITECTS**

@ 2015 Cyma Architects Ltd & Roger Joyce Associates.  
All rights reserved. No part of this publication may be reproduced, stored in a retrieval system, or transmitted, in any form or by any means, electronic, mechanical, photocopying, recording, or by any information storage and retrieval system, without the prior written permission of Cyma Architects Ltd and Roger Joyce Associates.  
THE COPYRIGHT OF THE FOLLOWING IS RESERVED TO THE ARCHITECTS:  
DRAWINGS, SPECIFICATIONS, AND ALL INFORMATION THEREIN MAY NOT BE REPRODUCED OR TRANSMITTED IN ANY FORM OR BY ANY MEANS, ELECTRONIC OR MECHANICAL, INCLUDING PHOTOCOPYING, RECORDING, OR BY ANY INFORMATION STORAGE AND RETRIEVAL SYSTEM, WITHOUT THE PRIOR WRITTEN PERMISSION OF CYMA ARCHITECTS LTD AND ROGER JOYCE ASSOCIATES.

AL(0)20  
FLOOR PLANS  
AS EXISTING  
SCALE 1:100