

Client
Mr T Doka

Project
**109 Dean Street
Rodbourne
Swindon
SN1 5EP**

Drawing Title
Proposed/ as built

Drawing No.
22/1838/02

Date
October 2022


Scale
1:100 @ A2

Drawn by
MM


Checked by
RGN

27b High Street
Highworth
Swindon
SN6 7AG


01793 762368
07798 864291

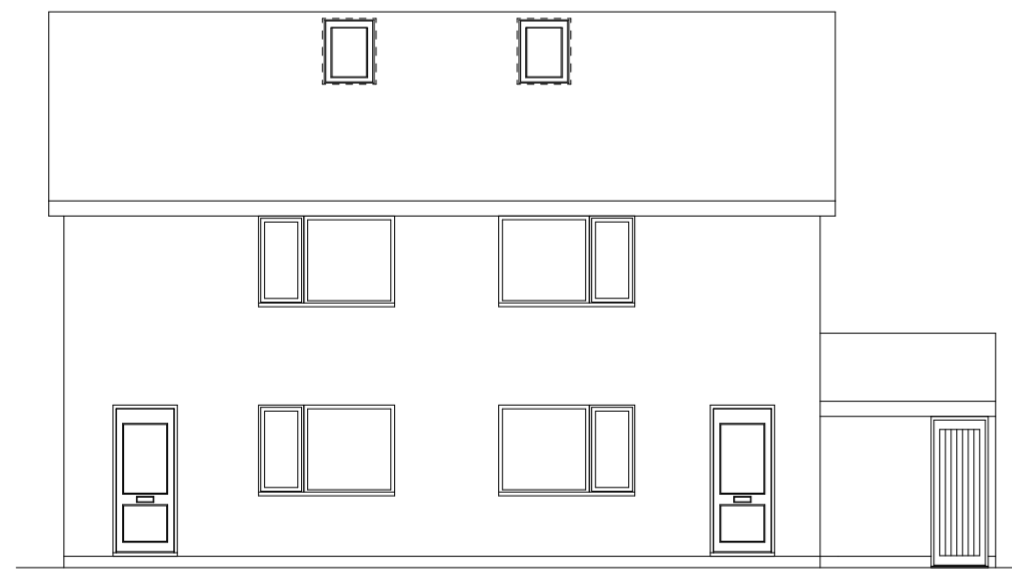


Proposed Front

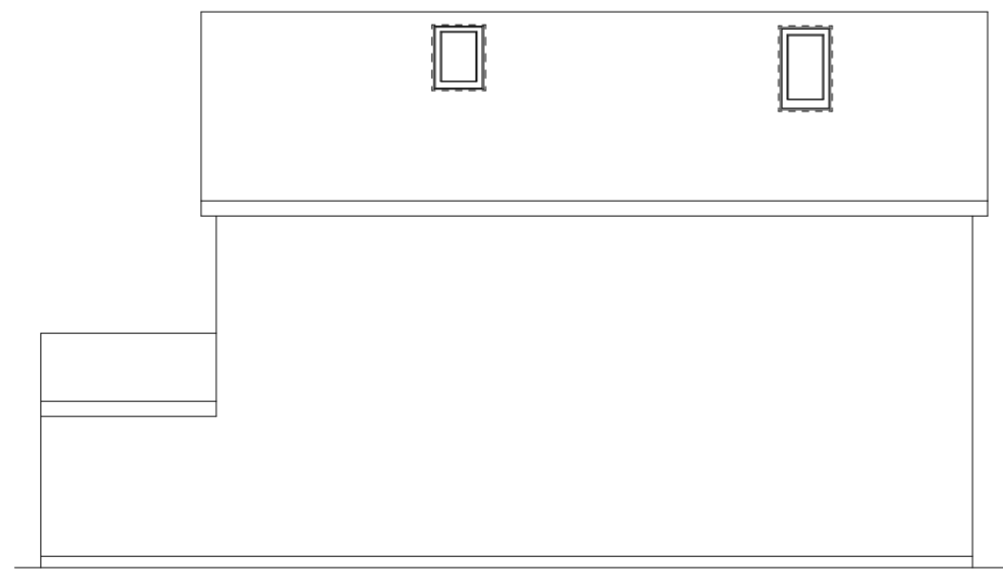

Proposed Rear (as existing)

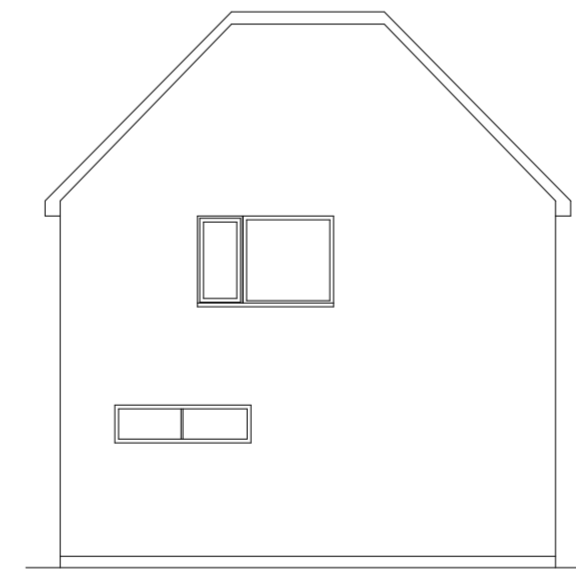

Proposed Side

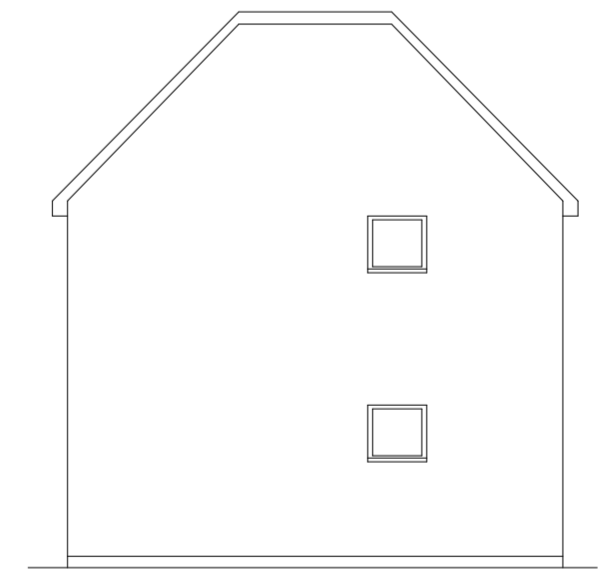

Proposed Side