





ELEVATION 01



ELEVATION 03

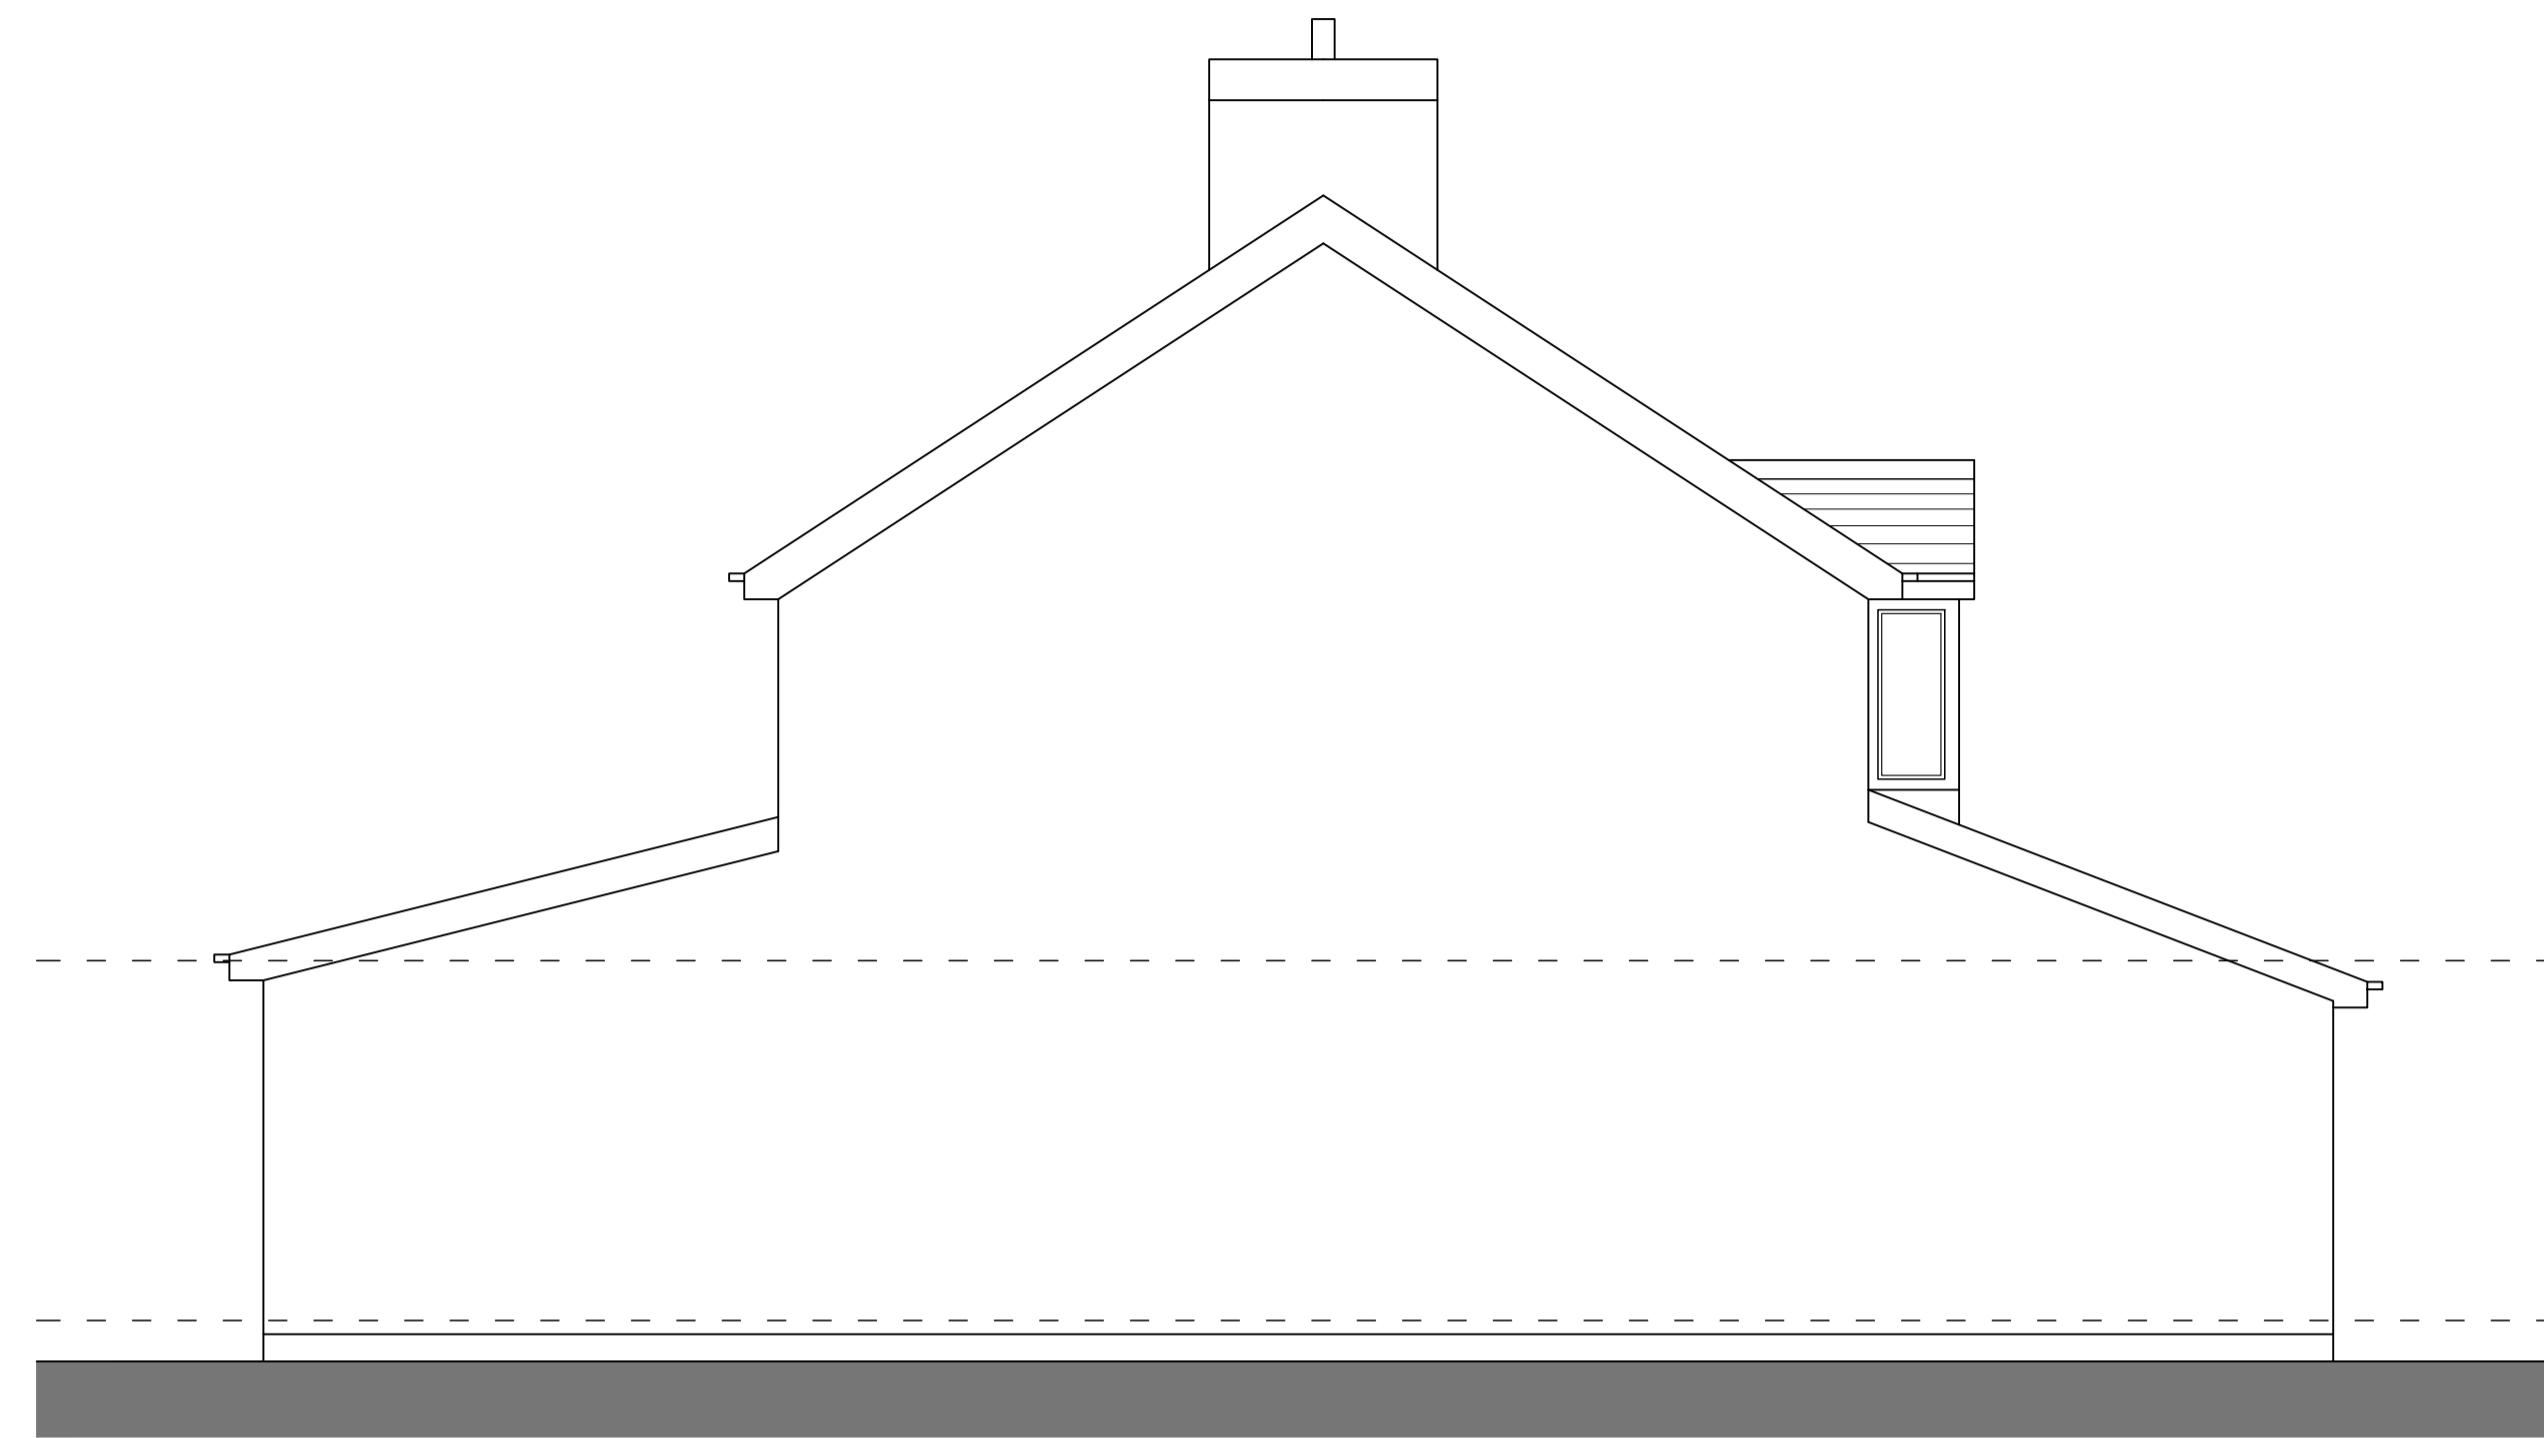

ELEVATION 02

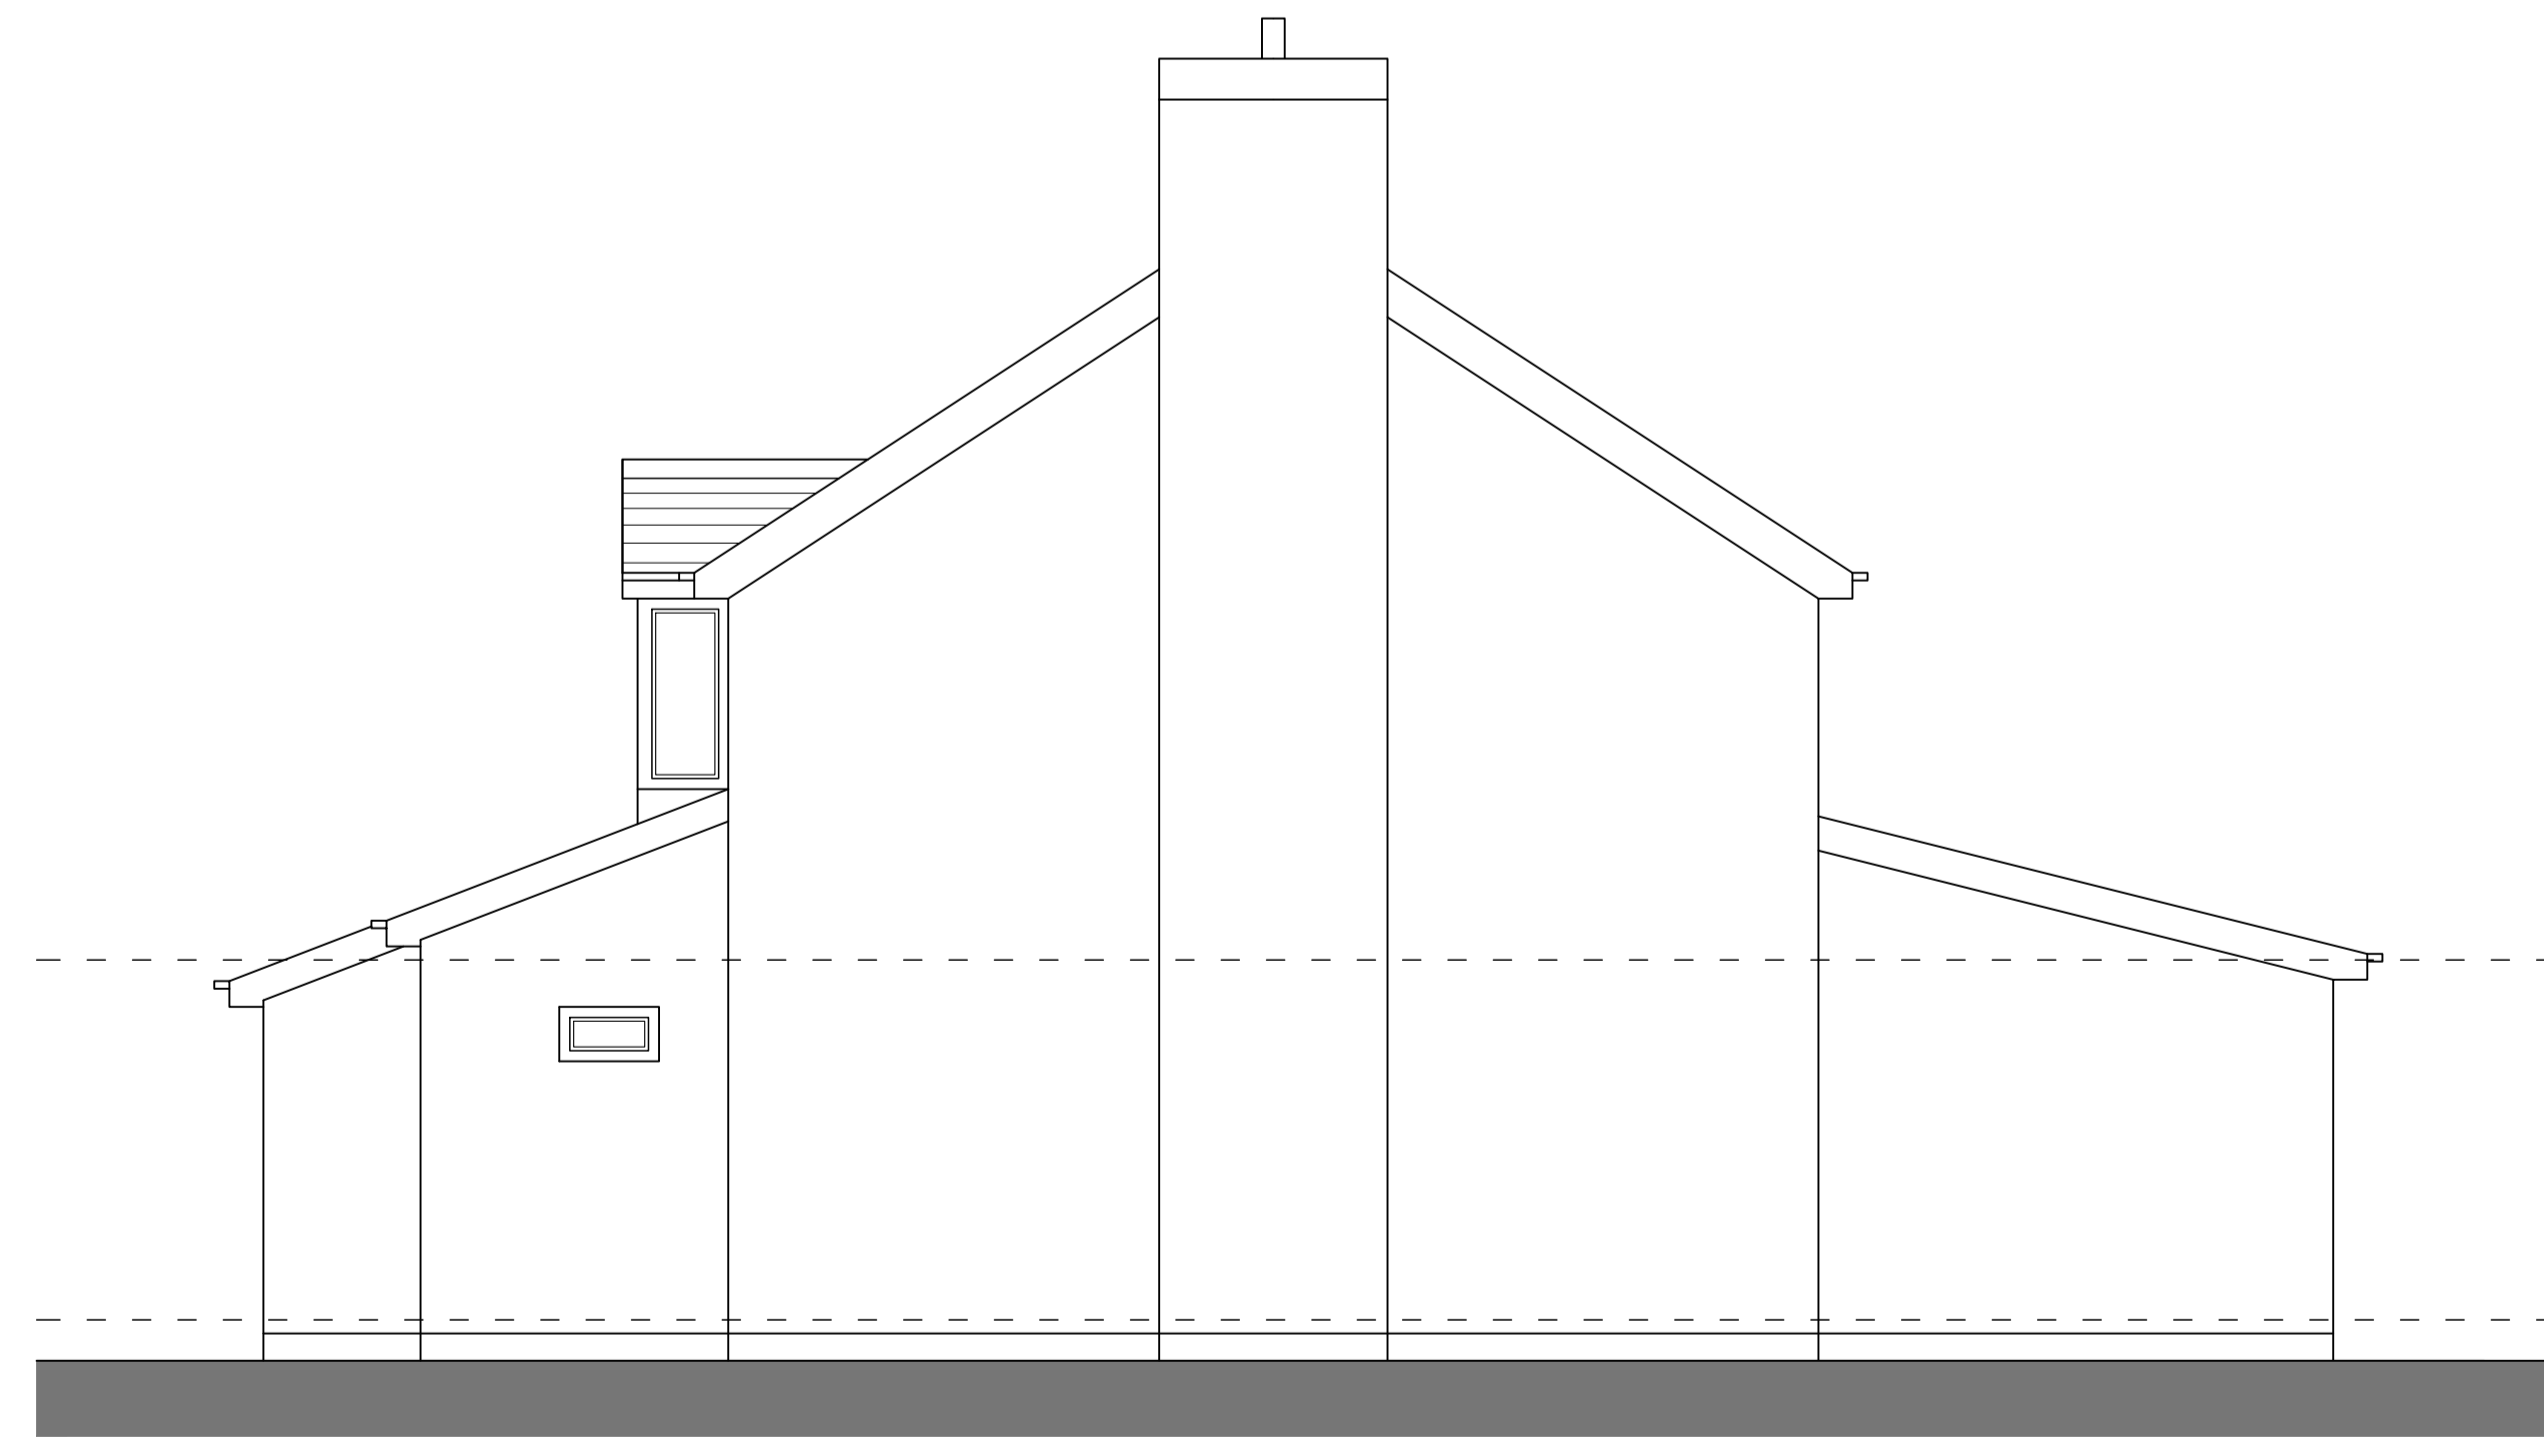


ELEVATION 04

Rev	Date	In1	Description



Vision Architecture & Design Ltd  
 T: 0161 456 3389  
 M: 0782 555 6071  
 E: dean@vision-architecture.co.uk  
 W: www.vision-architecture.co.uk

PROJECT			
No12 MARCHBANK DRIVE, CHEADLE, SK8 1QY			
TITLE			
EXISTING ELEVATIONS			
DRAWING STATUS			
<input type="checkbox"/> FEASIBILITY	<input type="checkbox"/> PLANNING	<input type="checkbox"/> CONTRACT	
<input type="checkbox"/> TENDER	<input type="checkbox"/> BUILDING CONTROL	<input checked="" type="checkbox"/> AS BUILT	
SCALE	CONTRACT	DRWG No.	REV
1:50 @ A1 1:100 @ A3	VA2323	(00).002	A

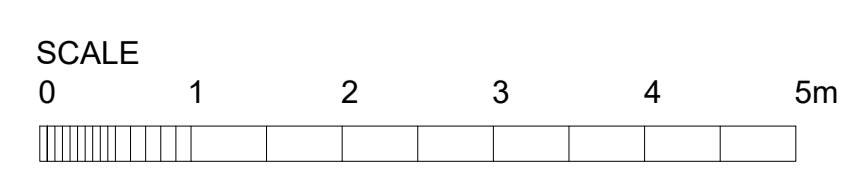

EXISTING ELEVATIONS