


It is the Contractor's responsibility to report any inconsistencies on this drawing, or between drawings, to the Design consultant and to request clarification and instruction before proceeding. This drawing and design is the copyright of VISION and may not be reproduced in any form whatsoever without prior express or written consent.

- EXISTING
- DEMOLITION
- PROPOSED

- ELEVATIONAL REFERENCE
- SECTIONAL REFERENCE

- S&VP / SS SOIL & VENT PIPE / STUB STACK
- RWP RAIN WATER PIPE
- MH MAN HOLE
- IC INSPECTION CHAMBER
- RE RODDING EYE
- G BACK INLET GULLEY
- AAV AIR ADMITTANCE VALVE
- WM WASHING MACHINE
- DW DISH WASHER
- TD TUMBLE DRYER
- FF FRIDGE / FREEZER
- O OVEN
- H HOB
- S/D SINK / DRAINER
- BLR BOILER
- GM GAS METER
- EM ELEC METER
- CU ELEG CONSUMER UNIT
- WHB WASH HAND BASIN
- WC WATER CLOSET
- BTH/SWR BATH / SHOWER
- R RADIATOR

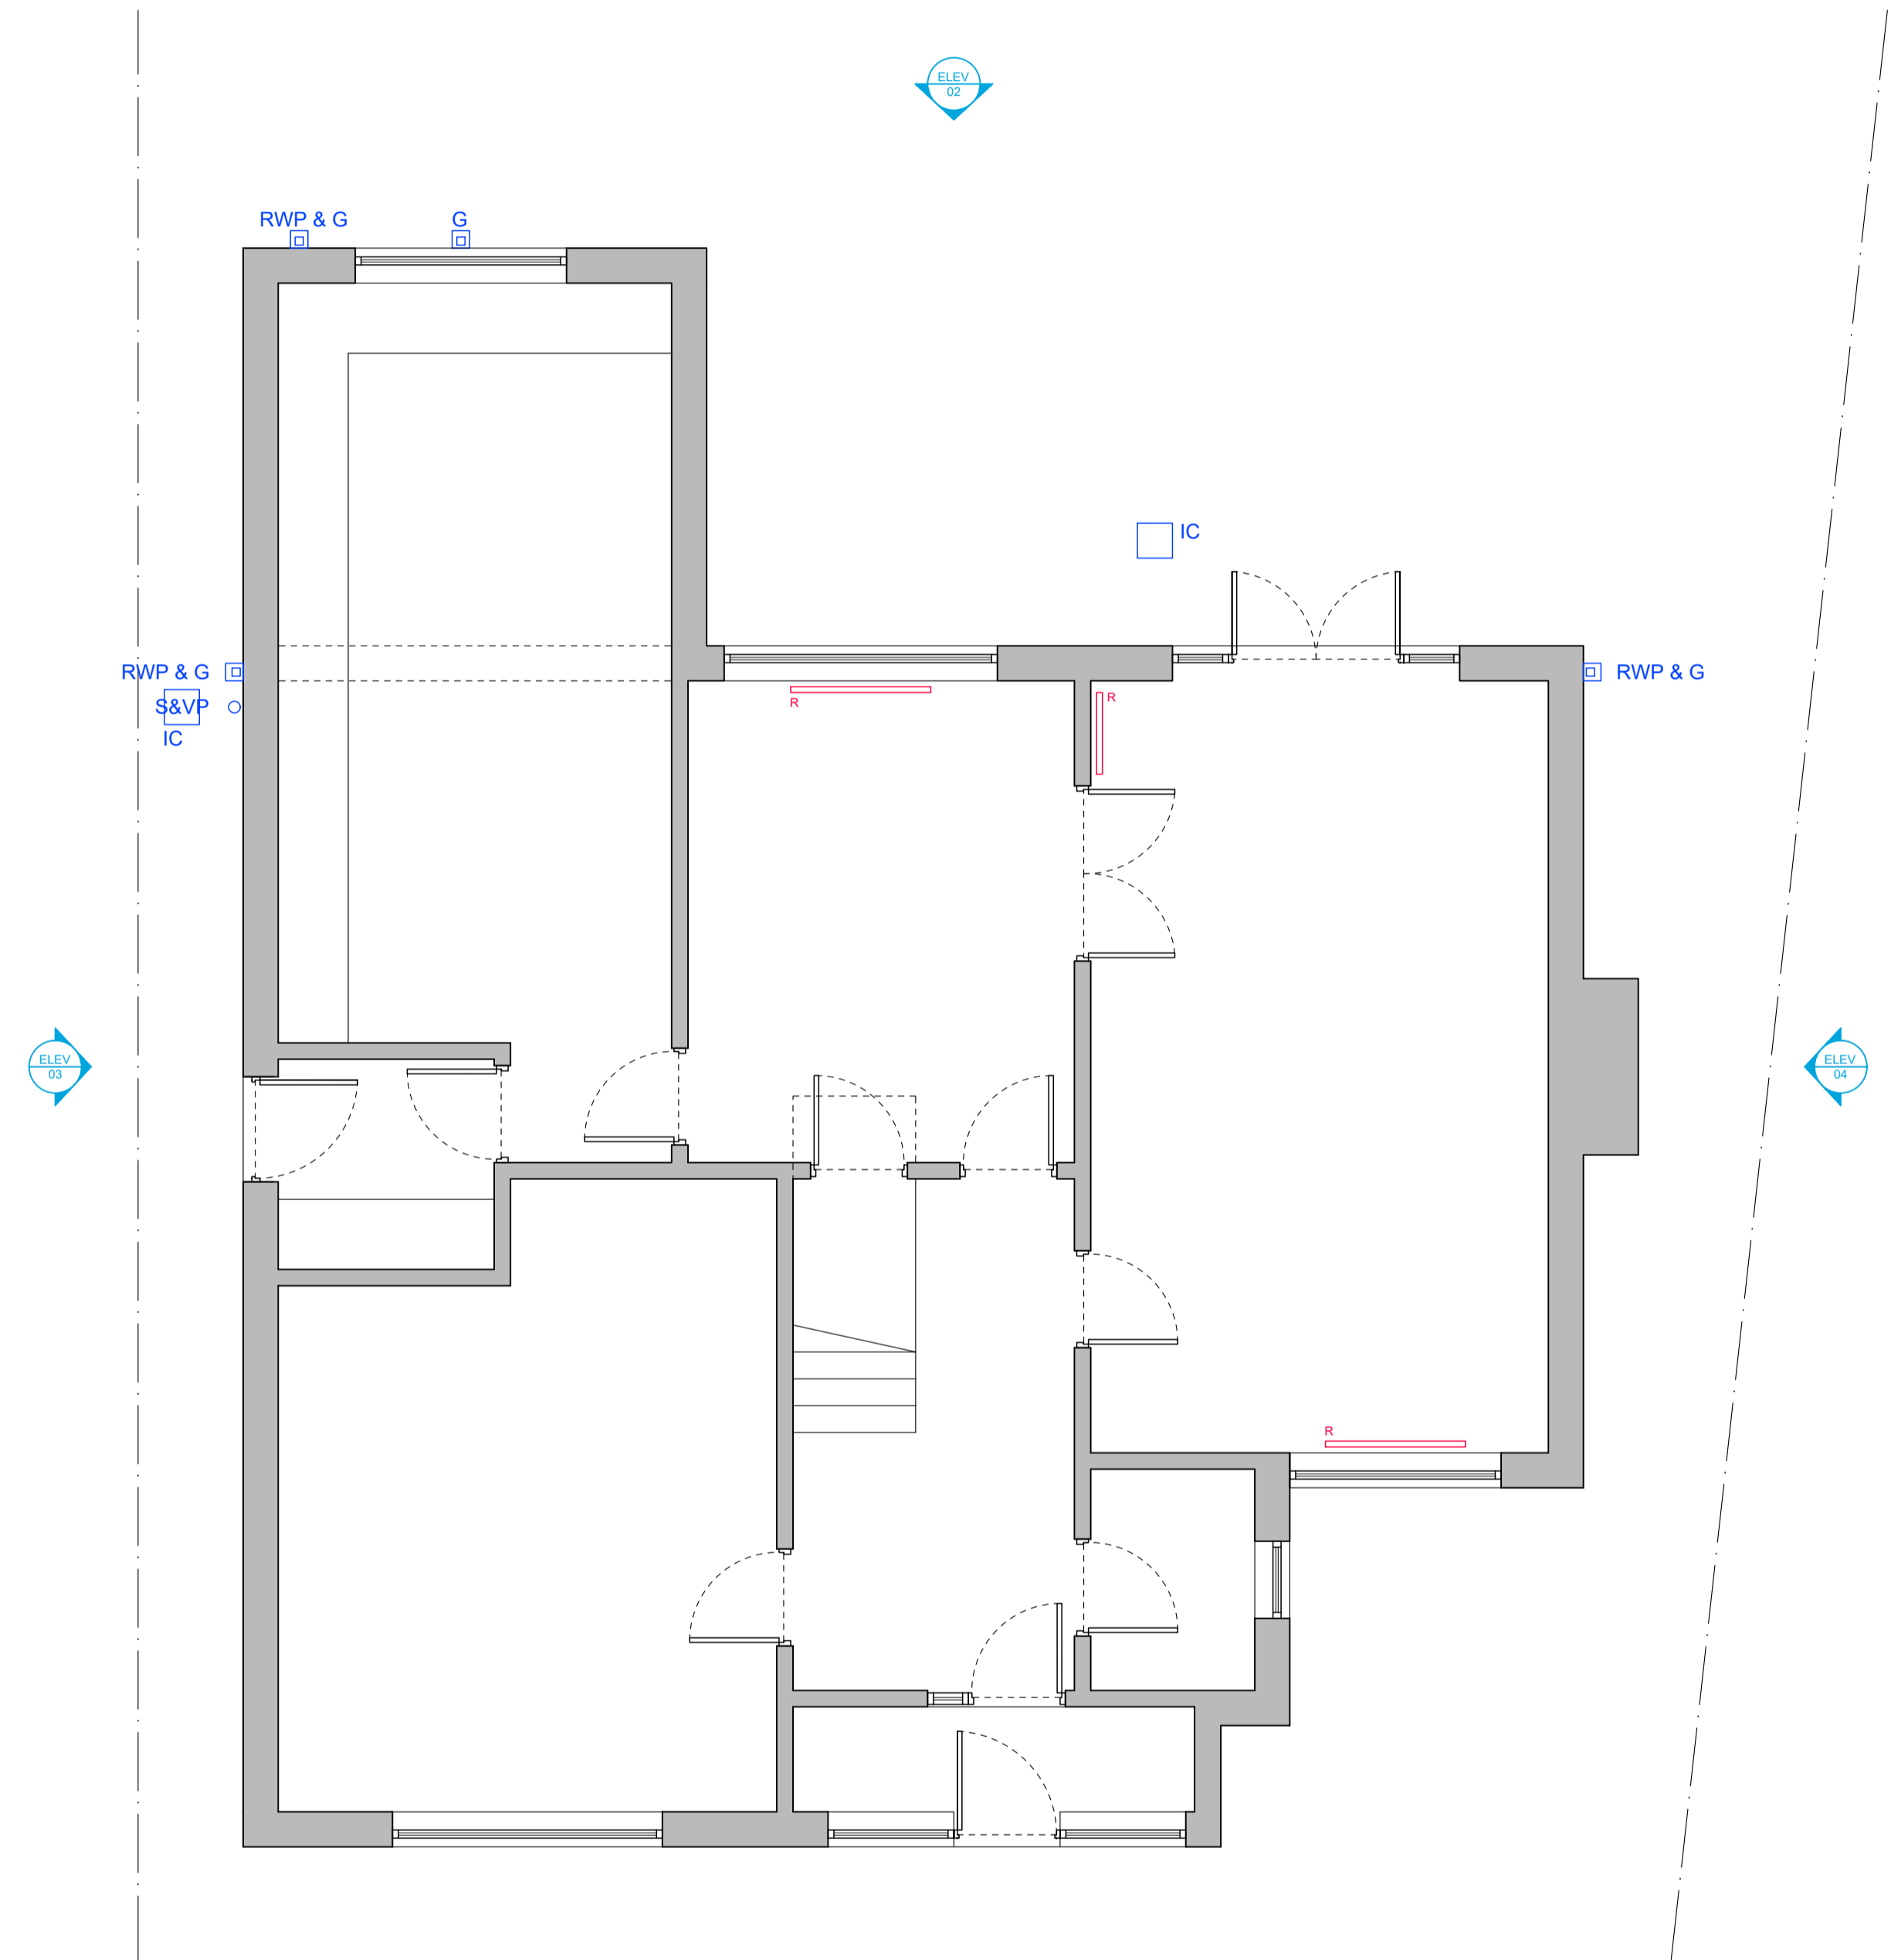


GROUND FLOOR PLAN

Rev	Date	In1	Description



Vision Architecture & Design Ltd
 T: 0161 456 3389
 M: 0782 555 6071
 E: dean@vision-architecture.co.uk
 W: www.vision-architecture.co.uk

PROJECT			
No12 MARCHBANK DRIVE, CHEADLE, SK8 1QY			
TITLE			
EXISTING PLAN			
DRAWING STATUS			
<input type="checkbox"/> FEASIBILITY	<input type="checkbox"/> PLANNING	<input type="checkbox"/> CONTRACT	
<input type="checkbox"/> TENDER	<input type="checkbox"/> BUILDING CONTROL	<input checked="" type="checkbox"/> AS BUILT	
SCALE	CONTRACT	DRWG No.	REV
1:50 @ A1 1:100 @ A3	VA2323	(00).001	A

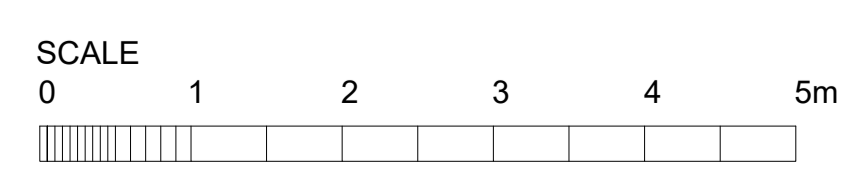

EXISTING PLAN