



CLIENT		MR MACFADYEN	
PROJECT		OUTBUILDING + HOLIDAY CABINS : LOG HOUSE : LENRAN : IV3 8RN	
DRAWING TITLE		EXISTING SITE SURVEY PLAN	
DRAWN BY	DATE	SCALE	PROJECT NO.
aT	October 2023	As Stated at A3	657
DO NOT SCALE FROM THIS DRAWING CONTRACTOR MUST CHECK ALL DIMENSIONS BEFORE COMMENCING WORK. REPORT ANY DISCREPANCIES TO THE ARCHITECTS IMMEDIATELY. COPYRIGHT + REPRODUCTION RESERVED BY Kerr AT architects.			DWG. NO.
			O2A

Revision A : 071123
 Red Line Amendments for Planning Area Calculations

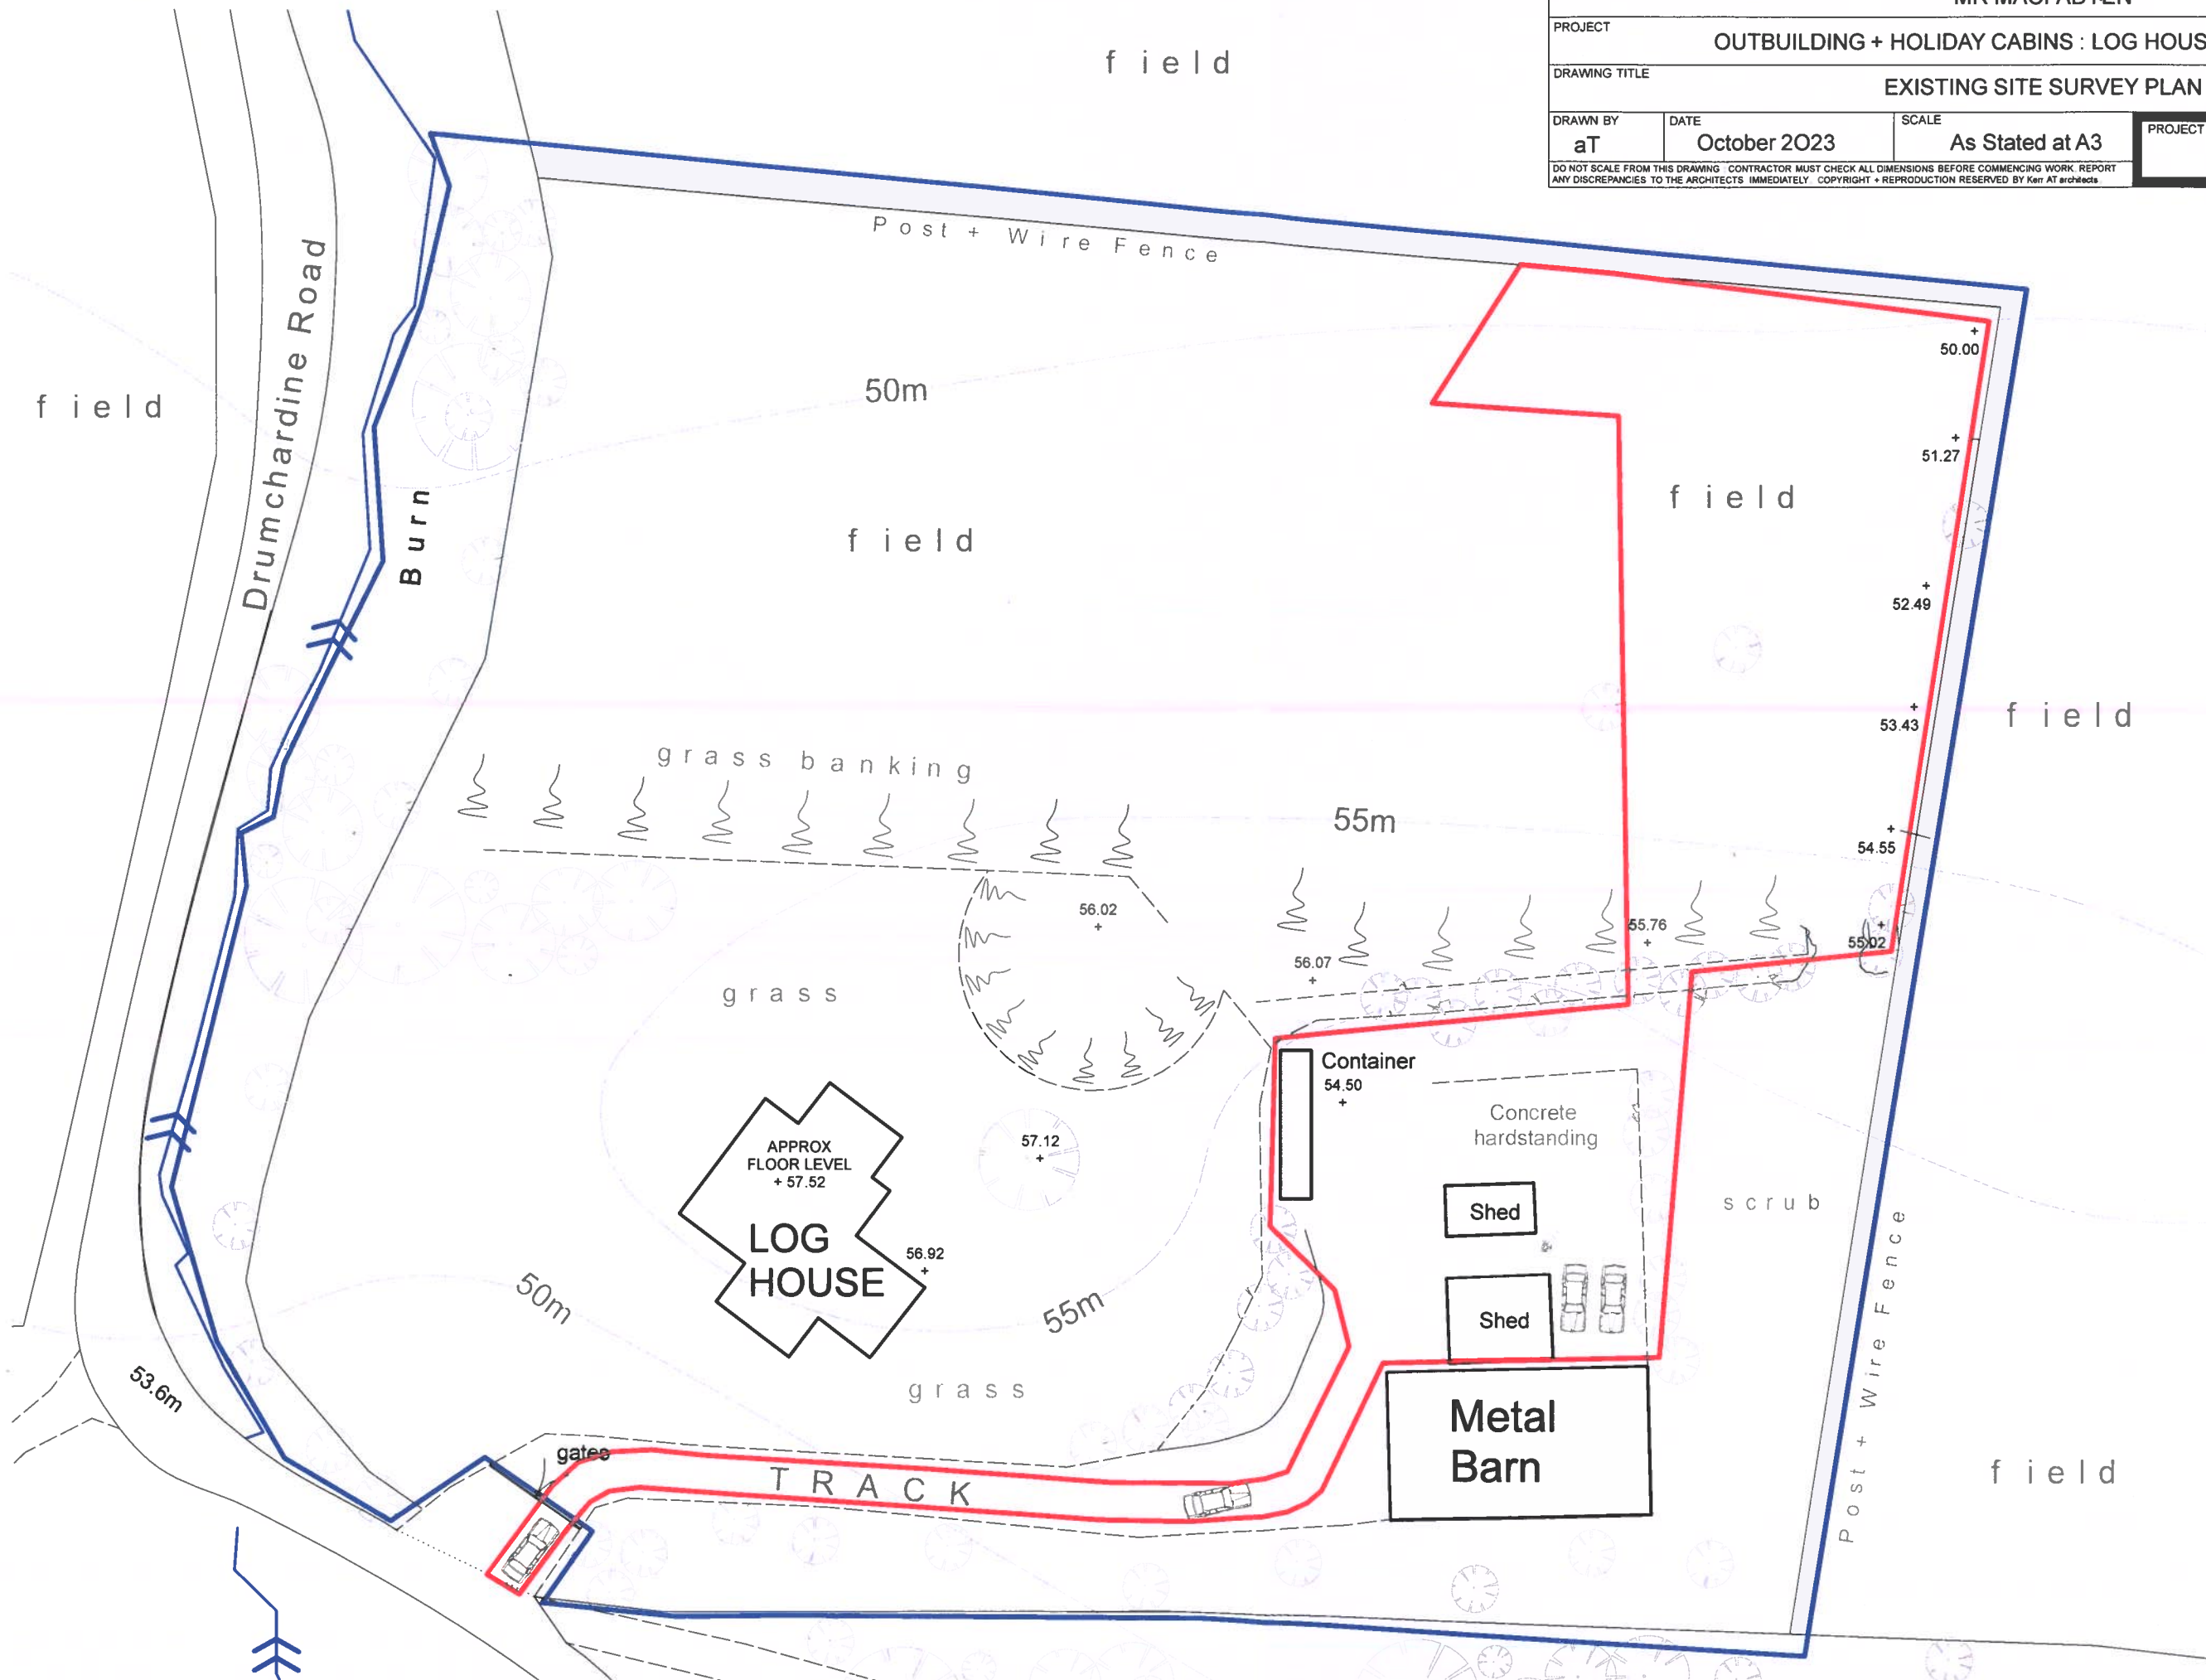

Highland Council
 eProcessing Centre
 Date Received:
21 NOV 2023


 SITE SURVEY PLAN
 1: 500
